


REVISONS


Rev. 2 = As built Jan 2011
Rev 1, CCN-502, CCN-503


| | | | |
|---|---------------|--------------|---------|
| DATE: | Jan 20, 2011 | VERIFIED BY: | LL |
| TITLE: System Interconnection (A/V IN ROOM) | | | |
| PROJECT NO.: | SS/0020018590 | NETWORK NO.: | TYPE A |
| PROJECT NAME: | | ROOM | |
| | | 46009 | |
| KPMG 46th Floor | | | |
| DATE: | Jan 20, 2011 | DRAWN BY: | VR |
| | | DRAWING NO.: | BD46 -1 |


AVW+TELAV

1930 ONESIME GAGNON
LACHINE, QUEBEC, CANADA, H8T 3M6
TEL.:(514) 631-0710 FAX:(514) 631-2943

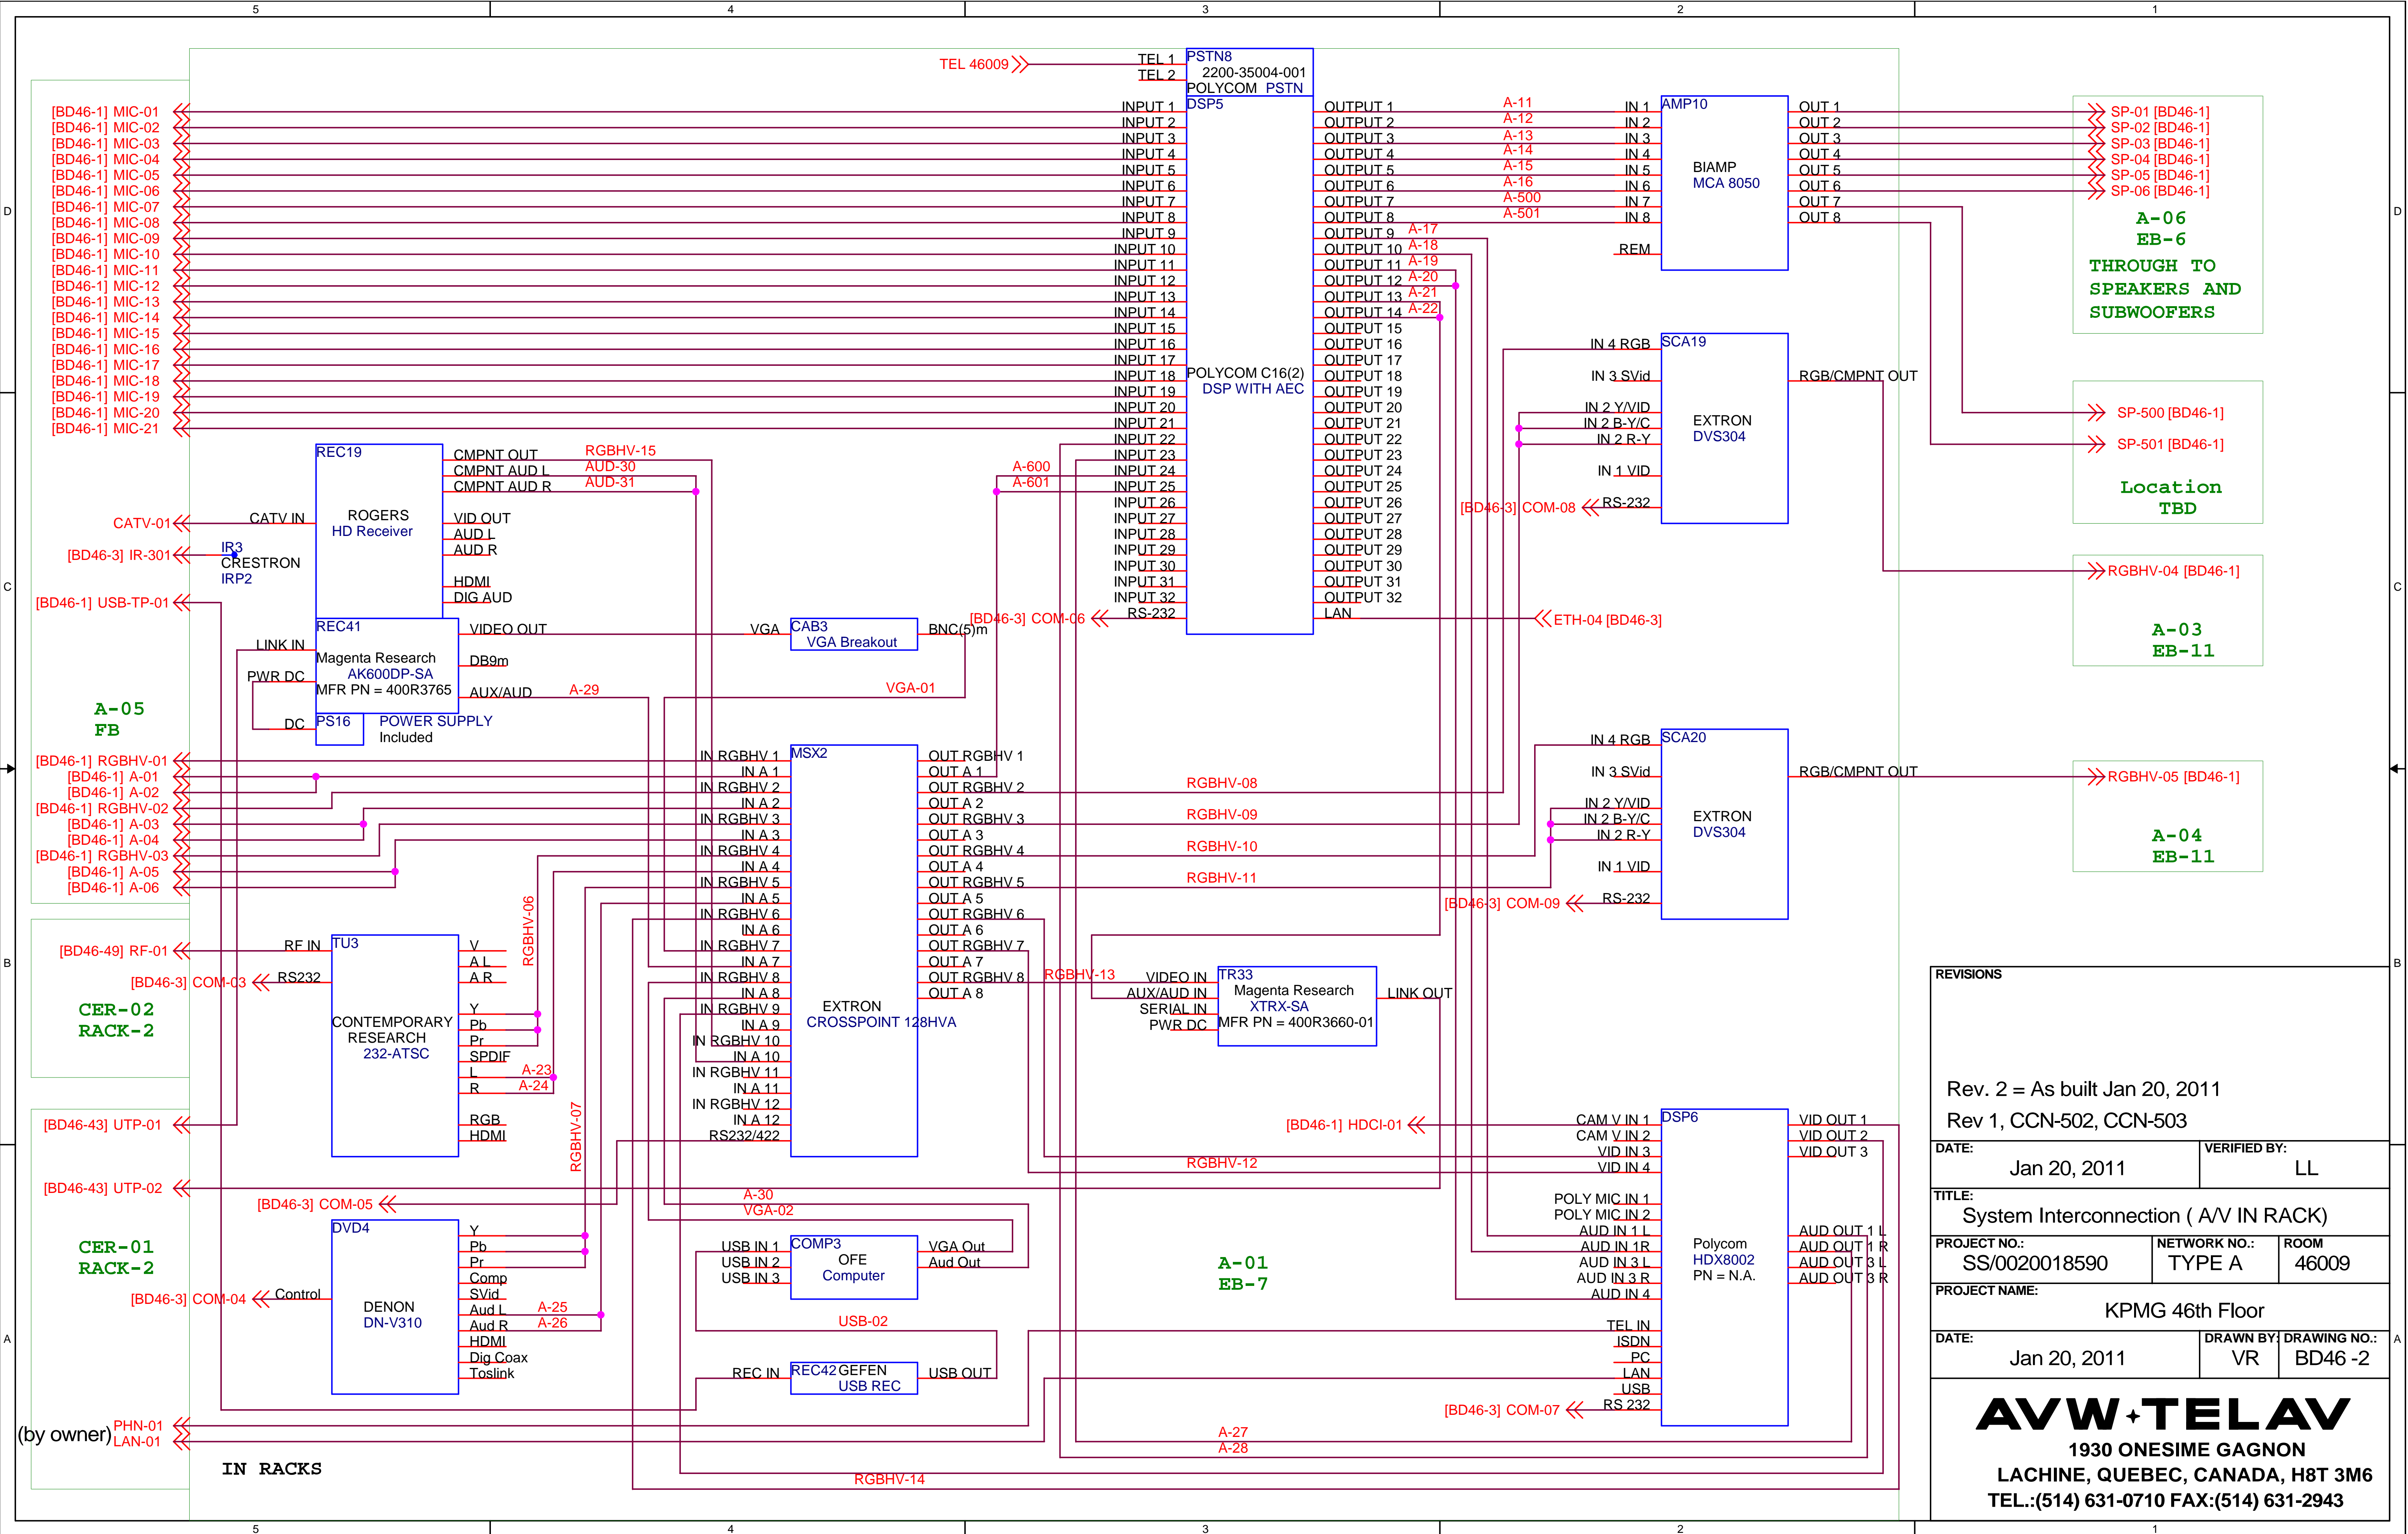

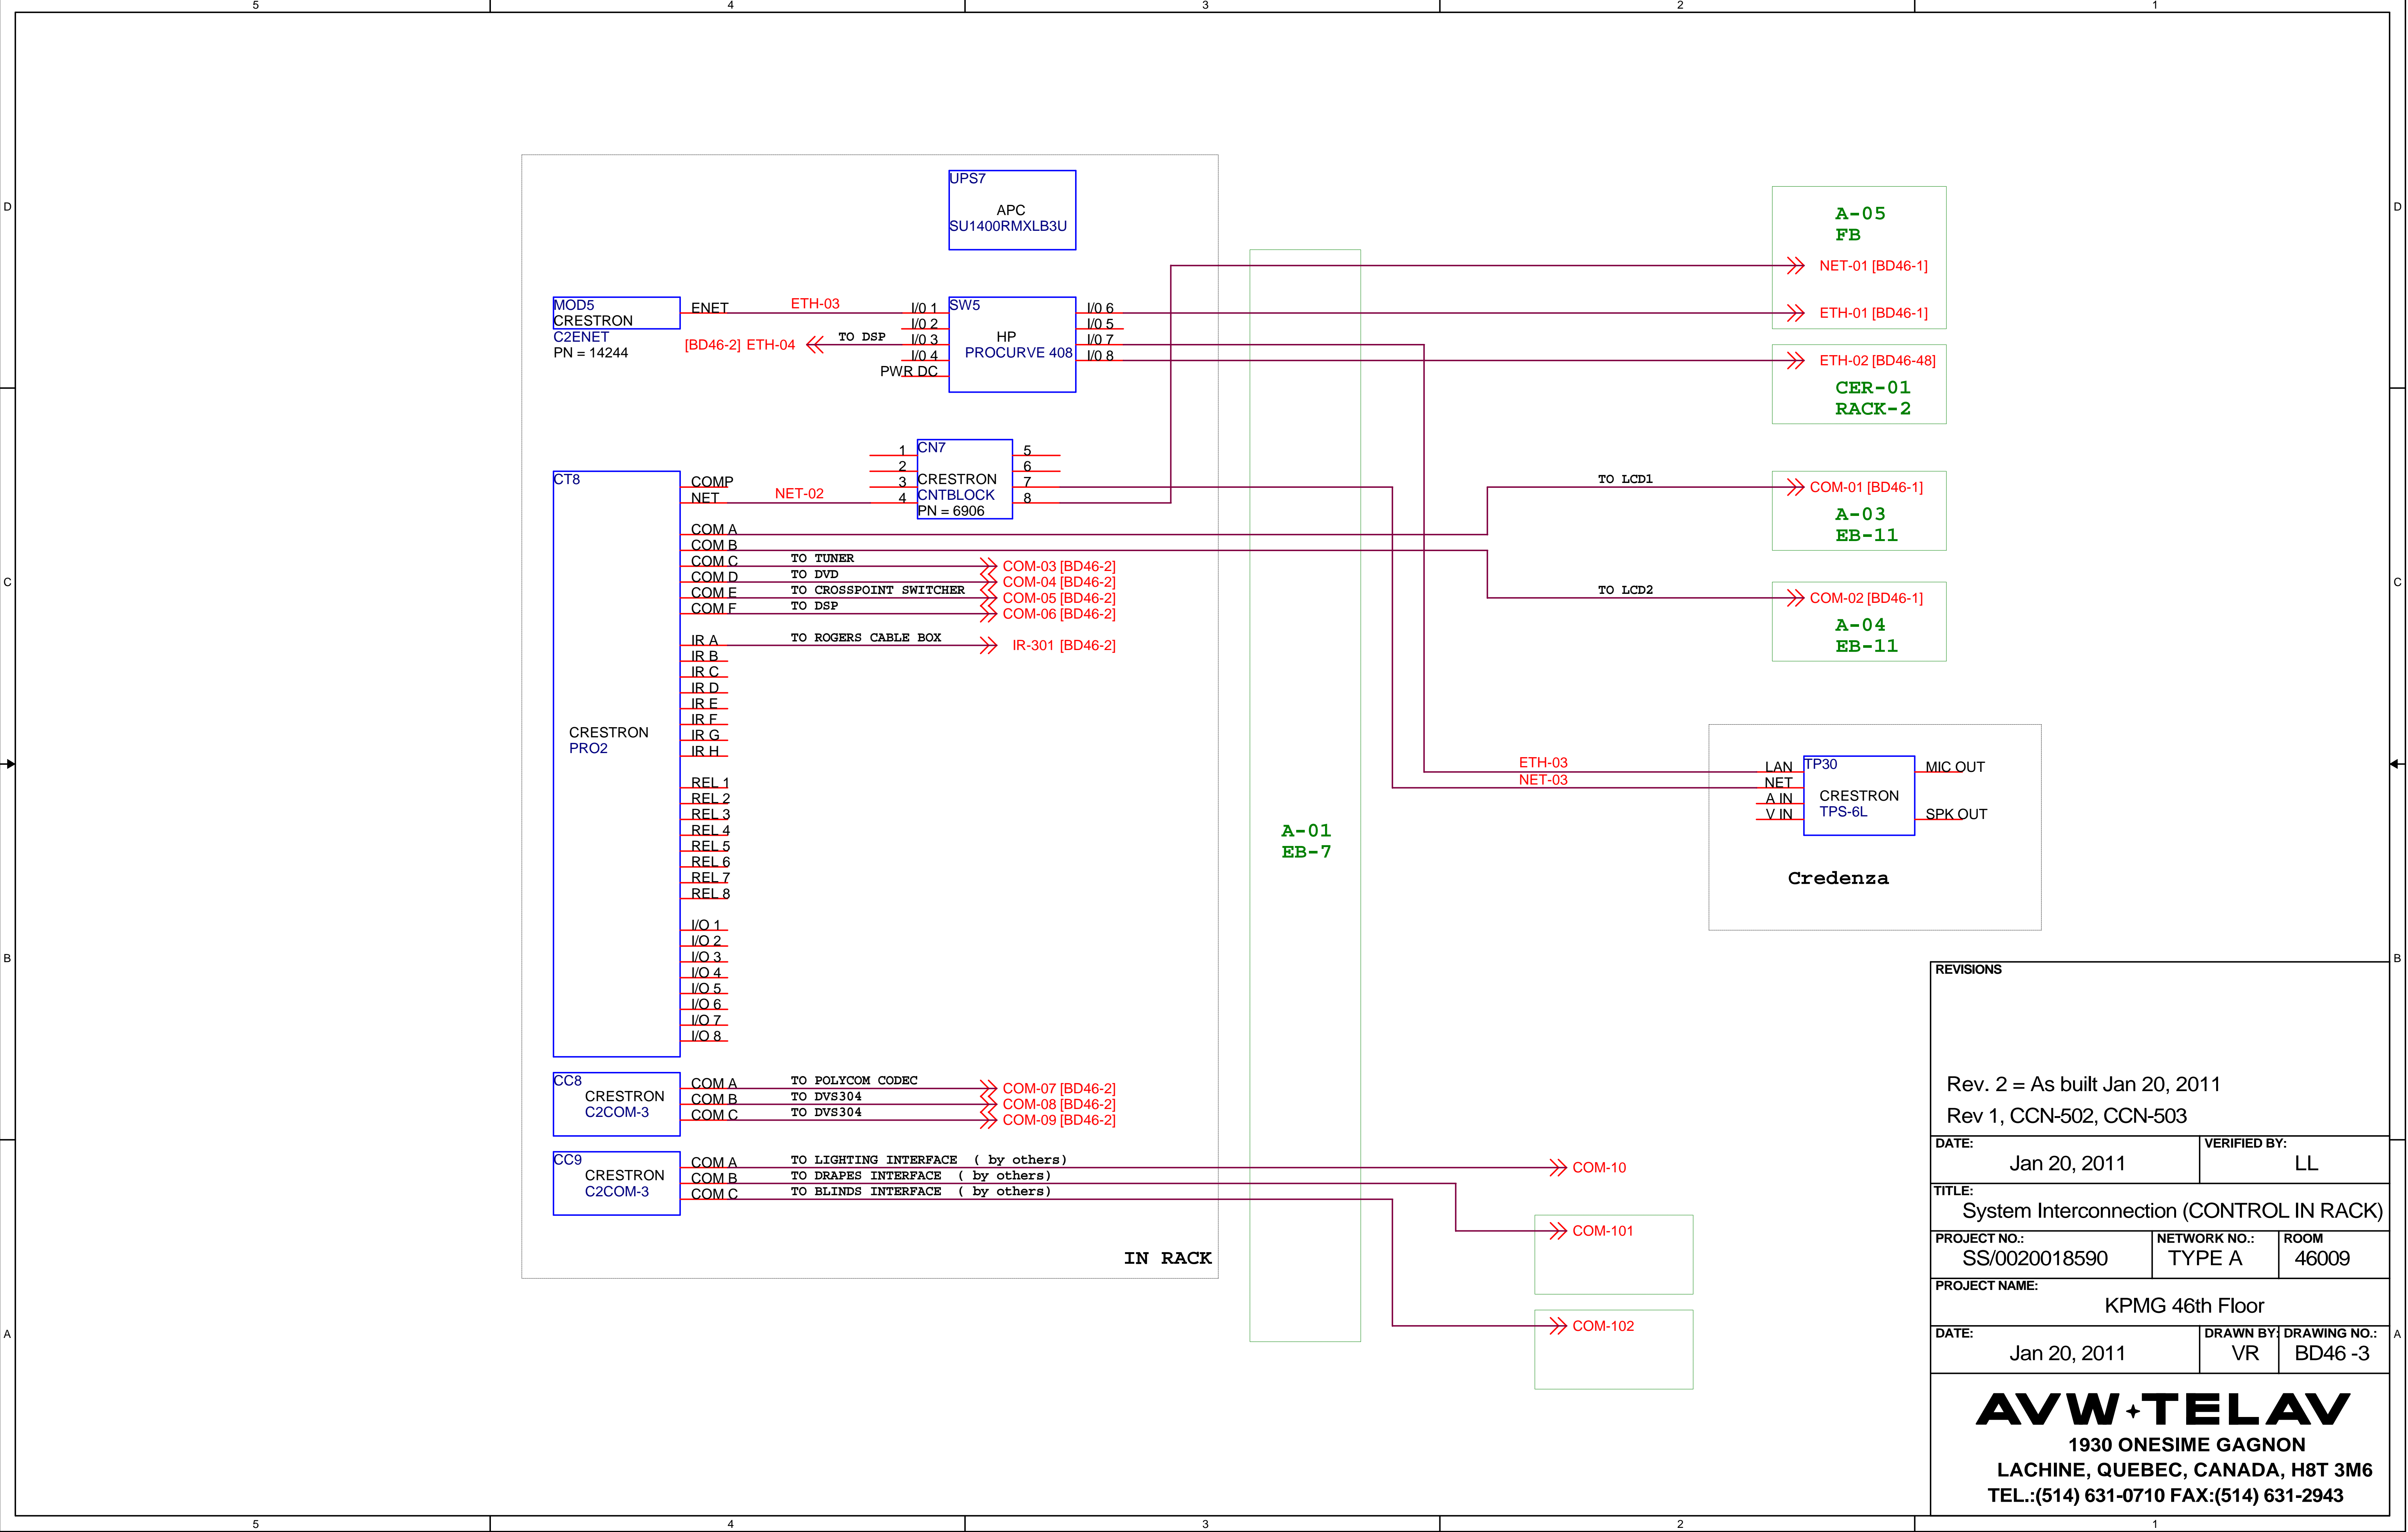

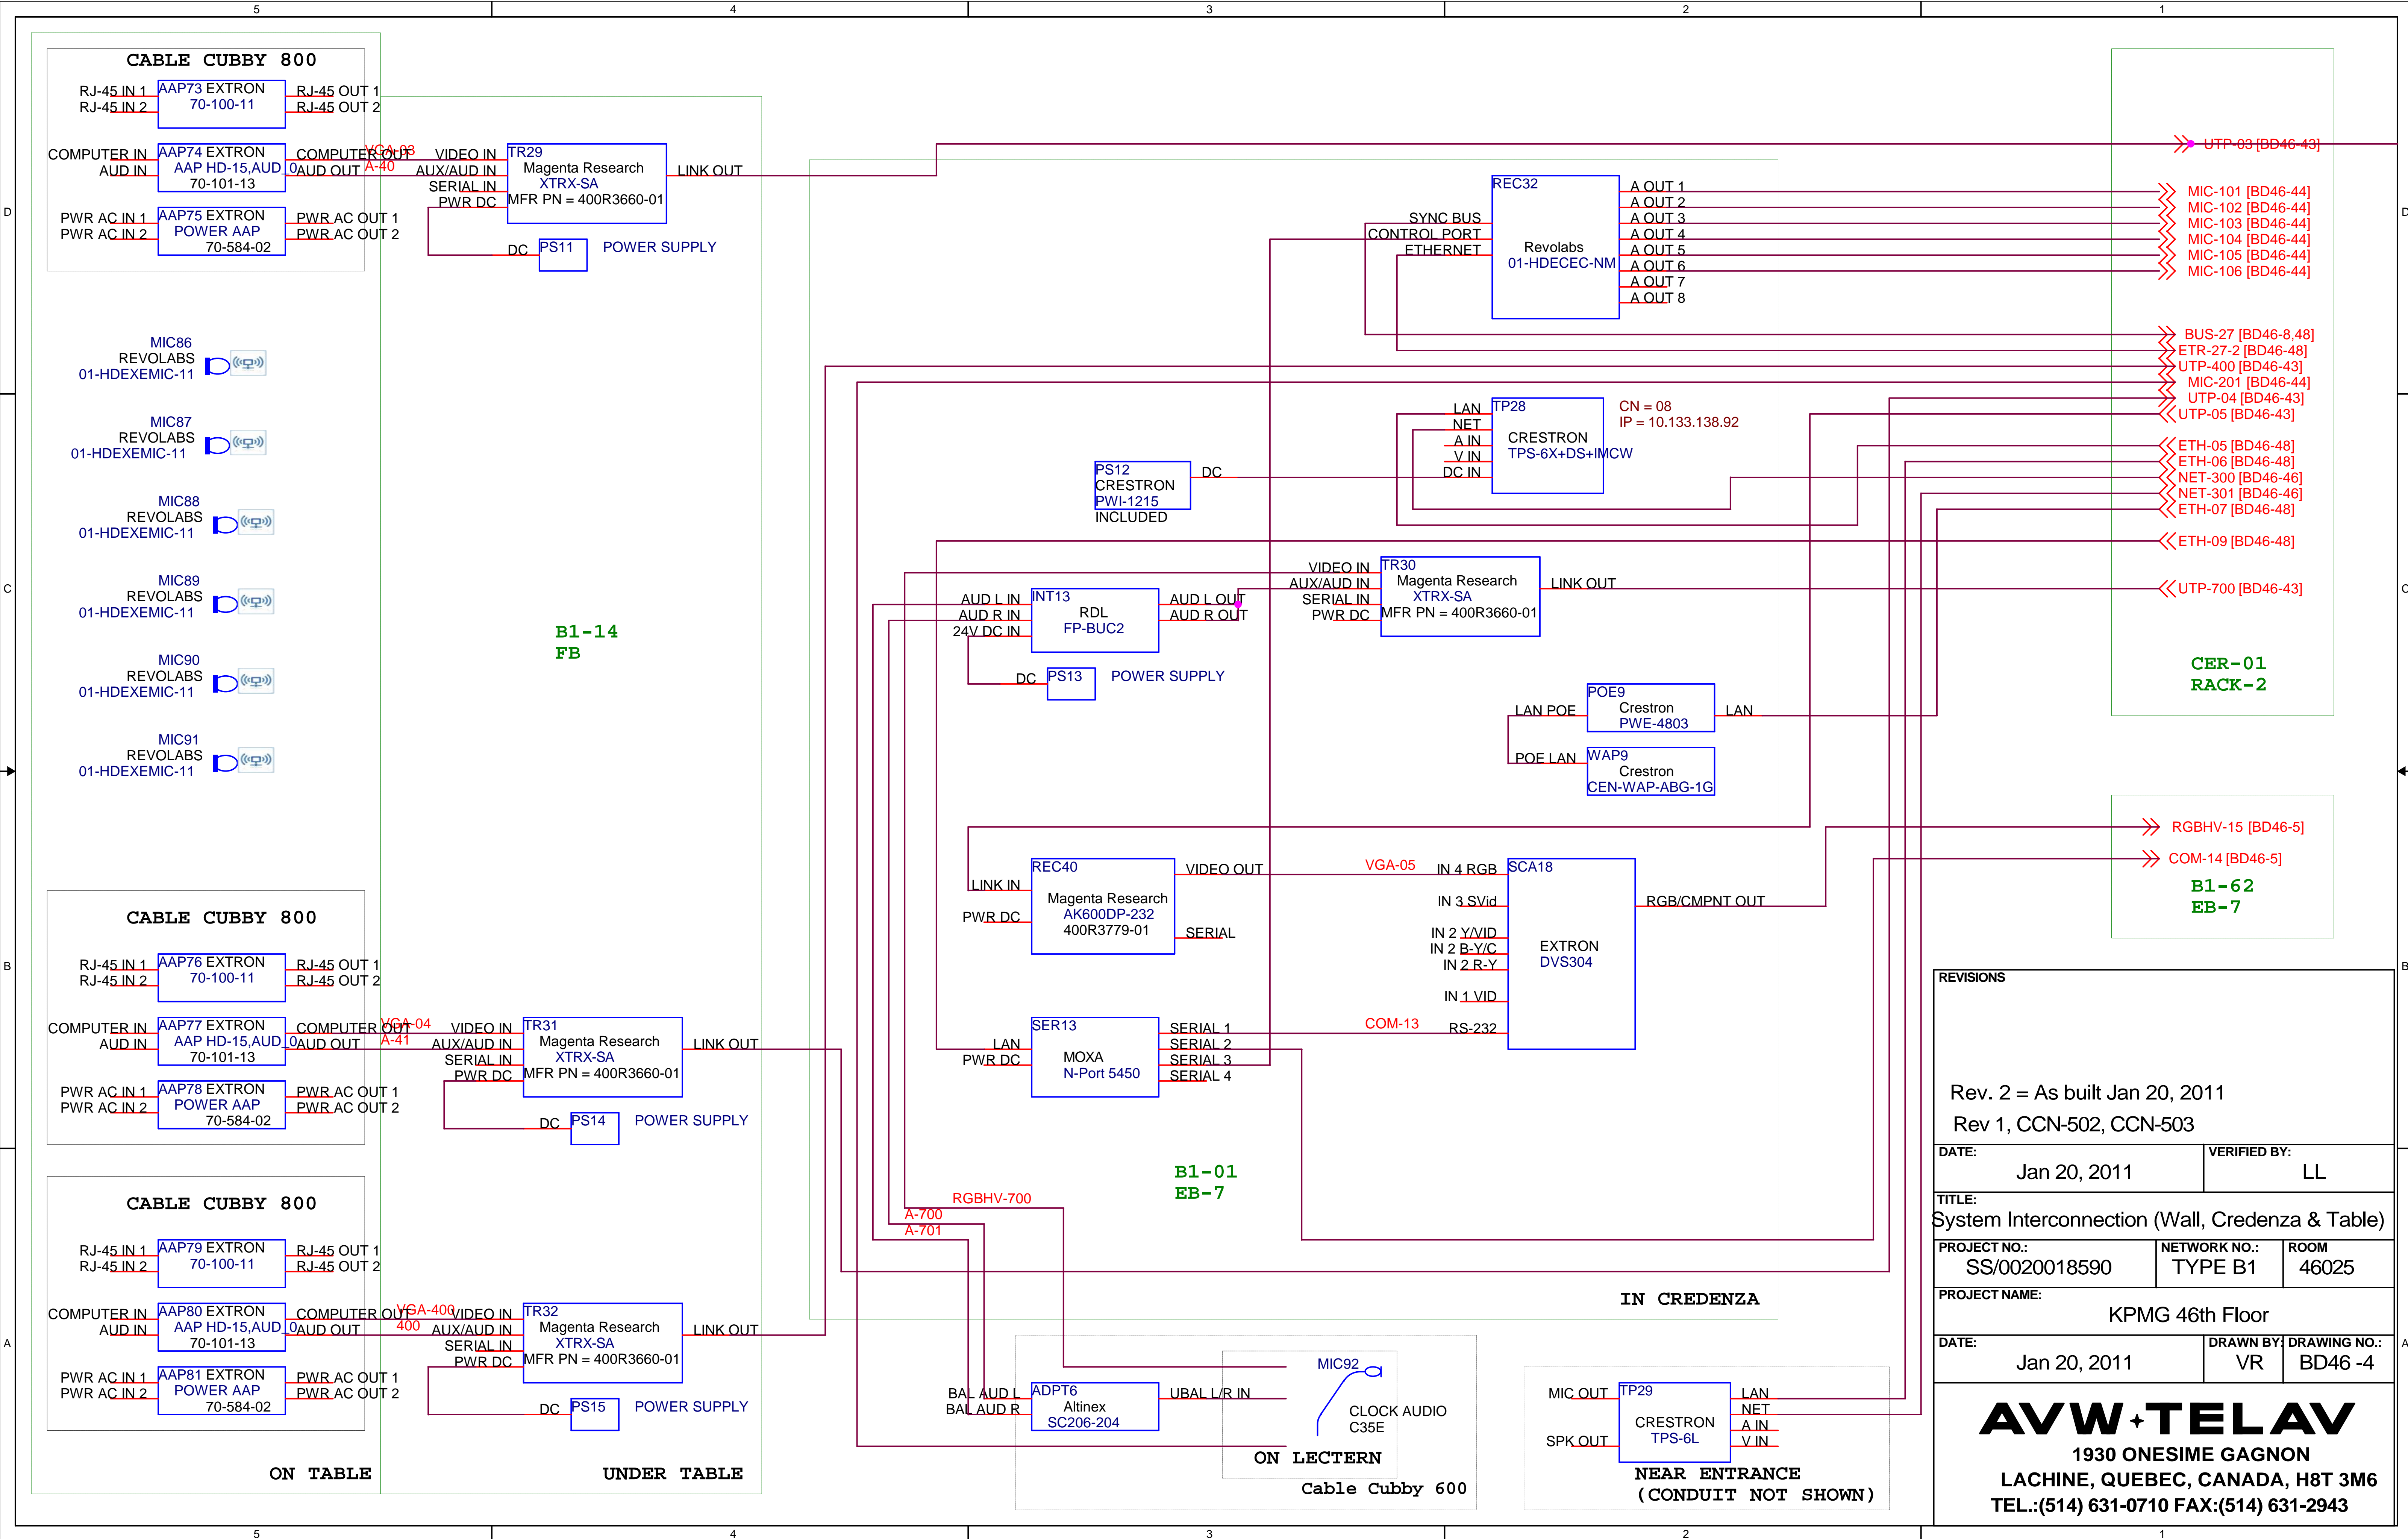

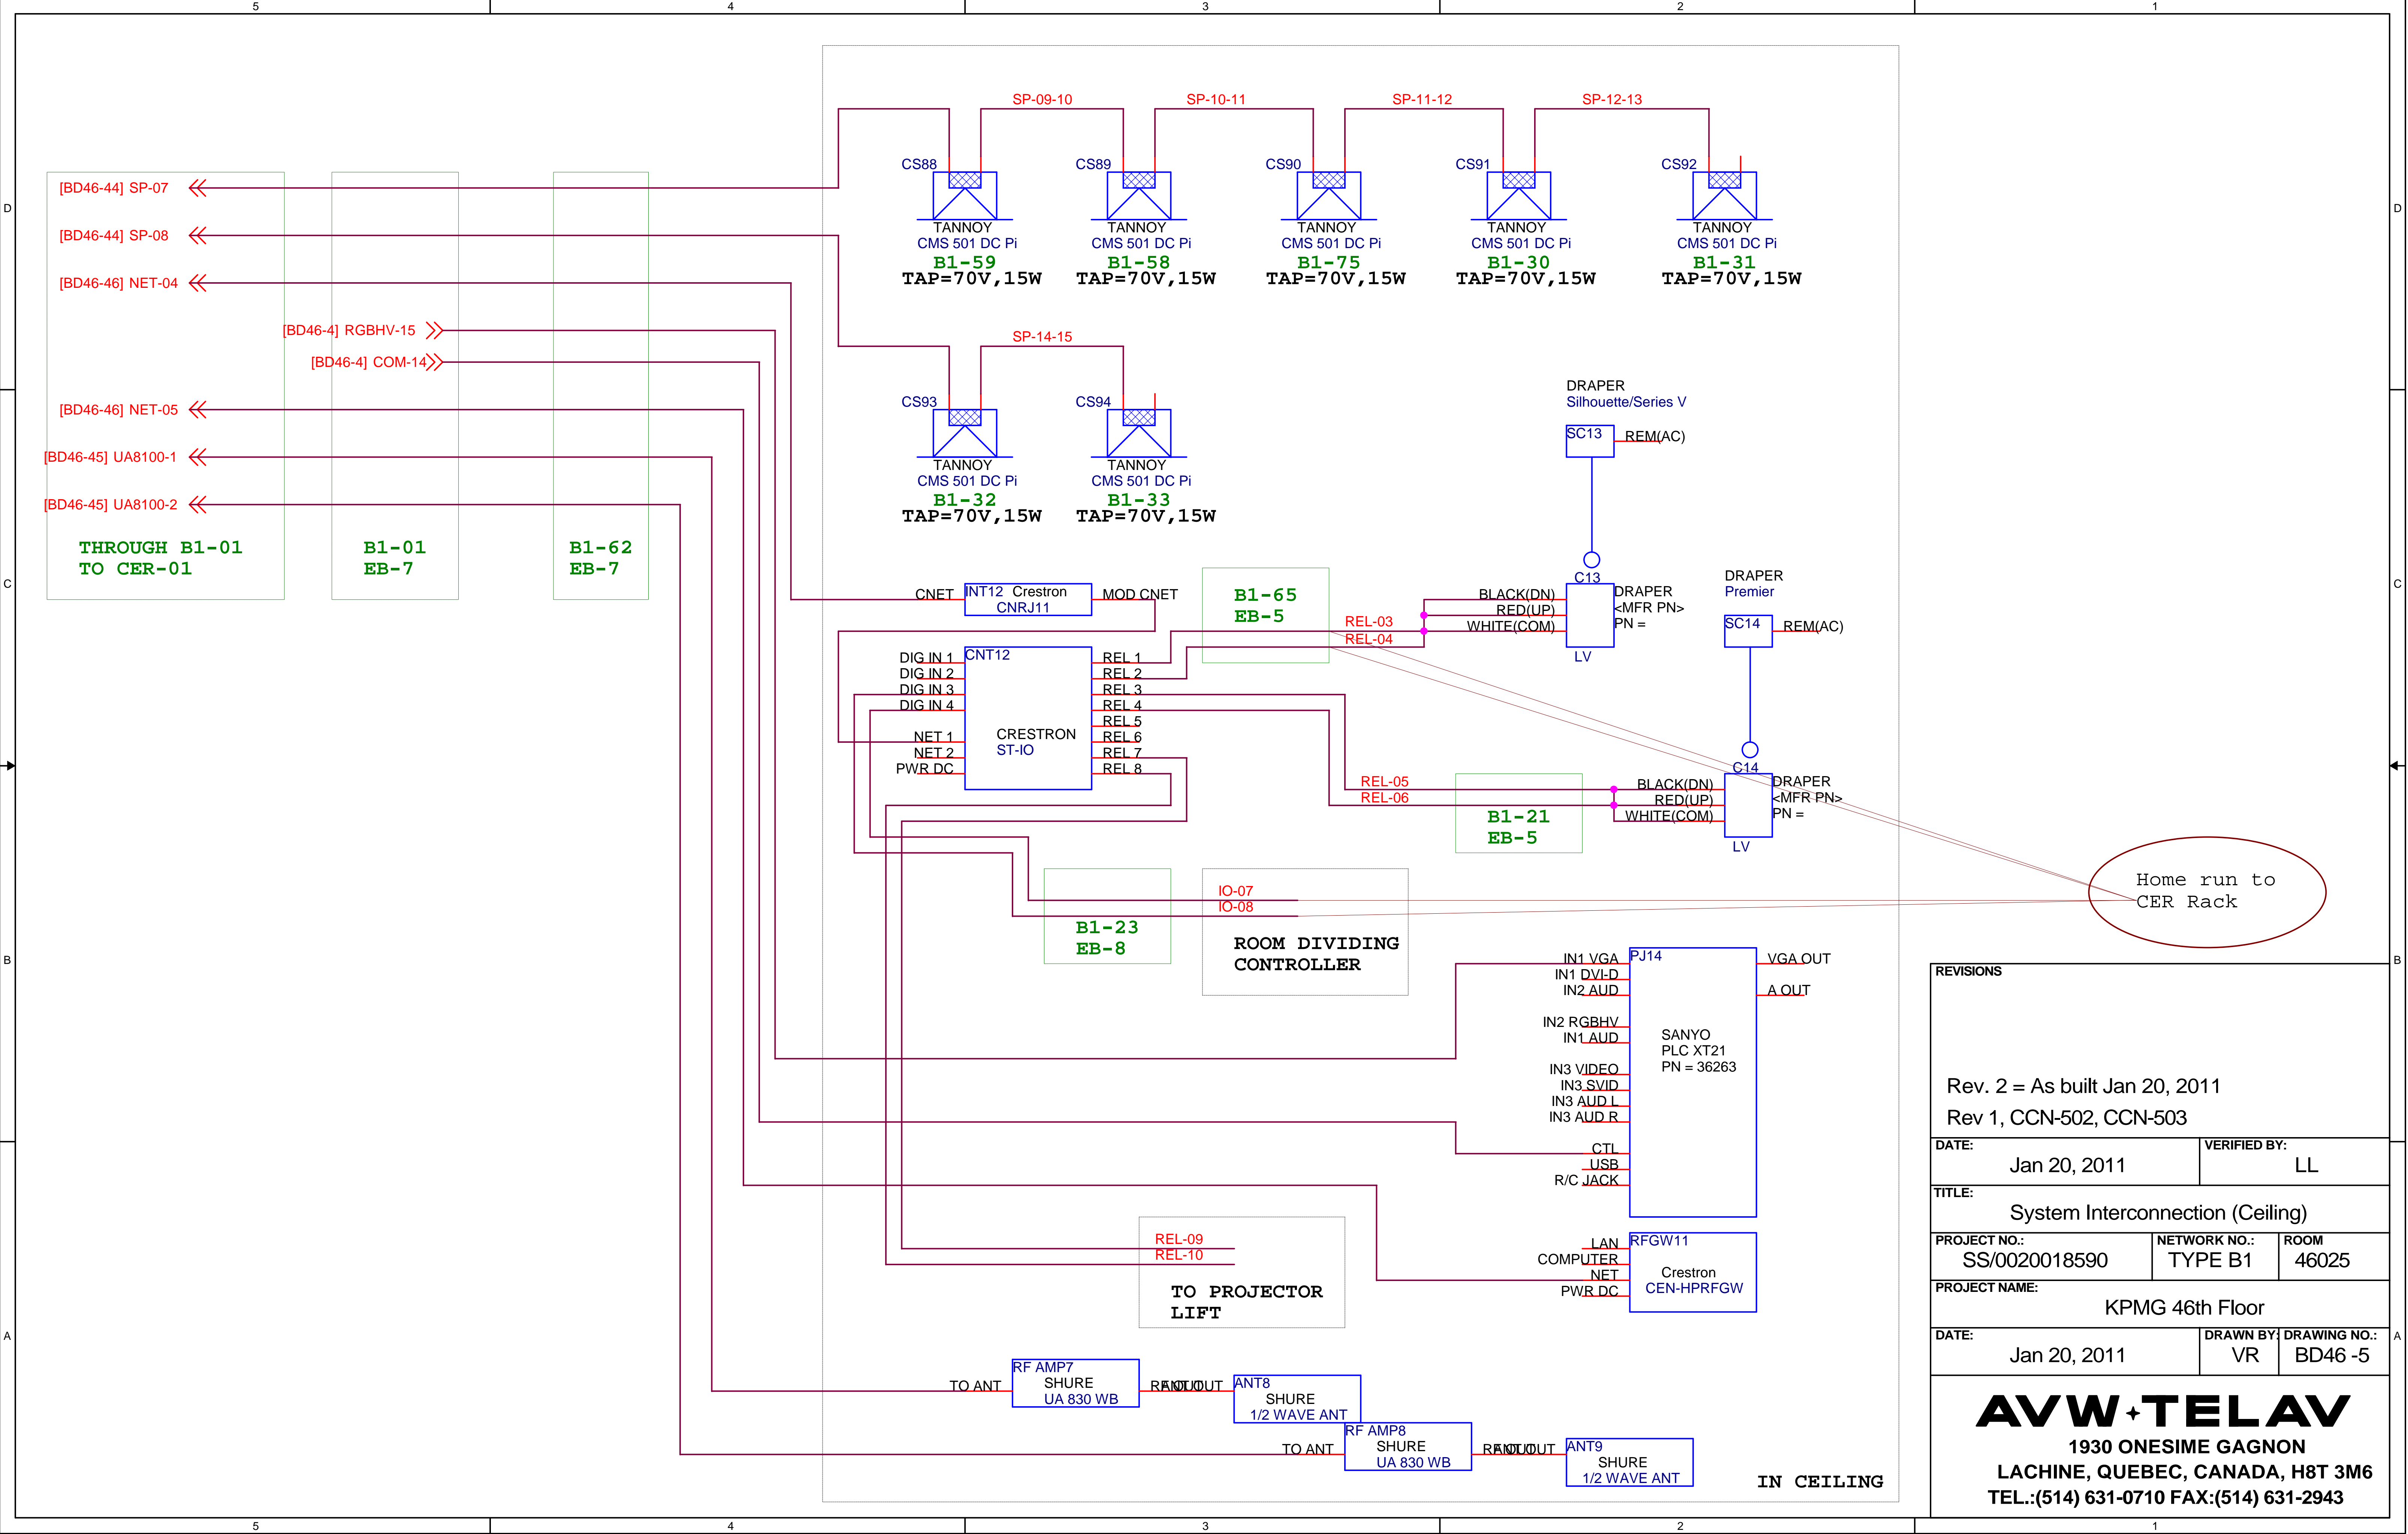

REVISIONS

Rev. 2 = As built Jan 20, 2011
Rev 1, CCN-502, CCN-503

DATE: Jan 20, 2011

VERIFIED BY: LL

TITLE: System Interconnection (Ceiling)

PROJECT NO.: SS/0020018590

NETWORK NO.: TYPE B1

ROOM 46025

PROJECT NAME: KPMG 46th Floor


DATE: Jan 20, 2011


DRAWN BY: VR


DRAWING NO.: BD46 -5


AVW+TELAV

1930 ONESIME GAGNON
LACHINE, QUEBEC, CANADA, H8T 3M6
TEL.:(514) 631-0710 FAX:(514) 631-2943

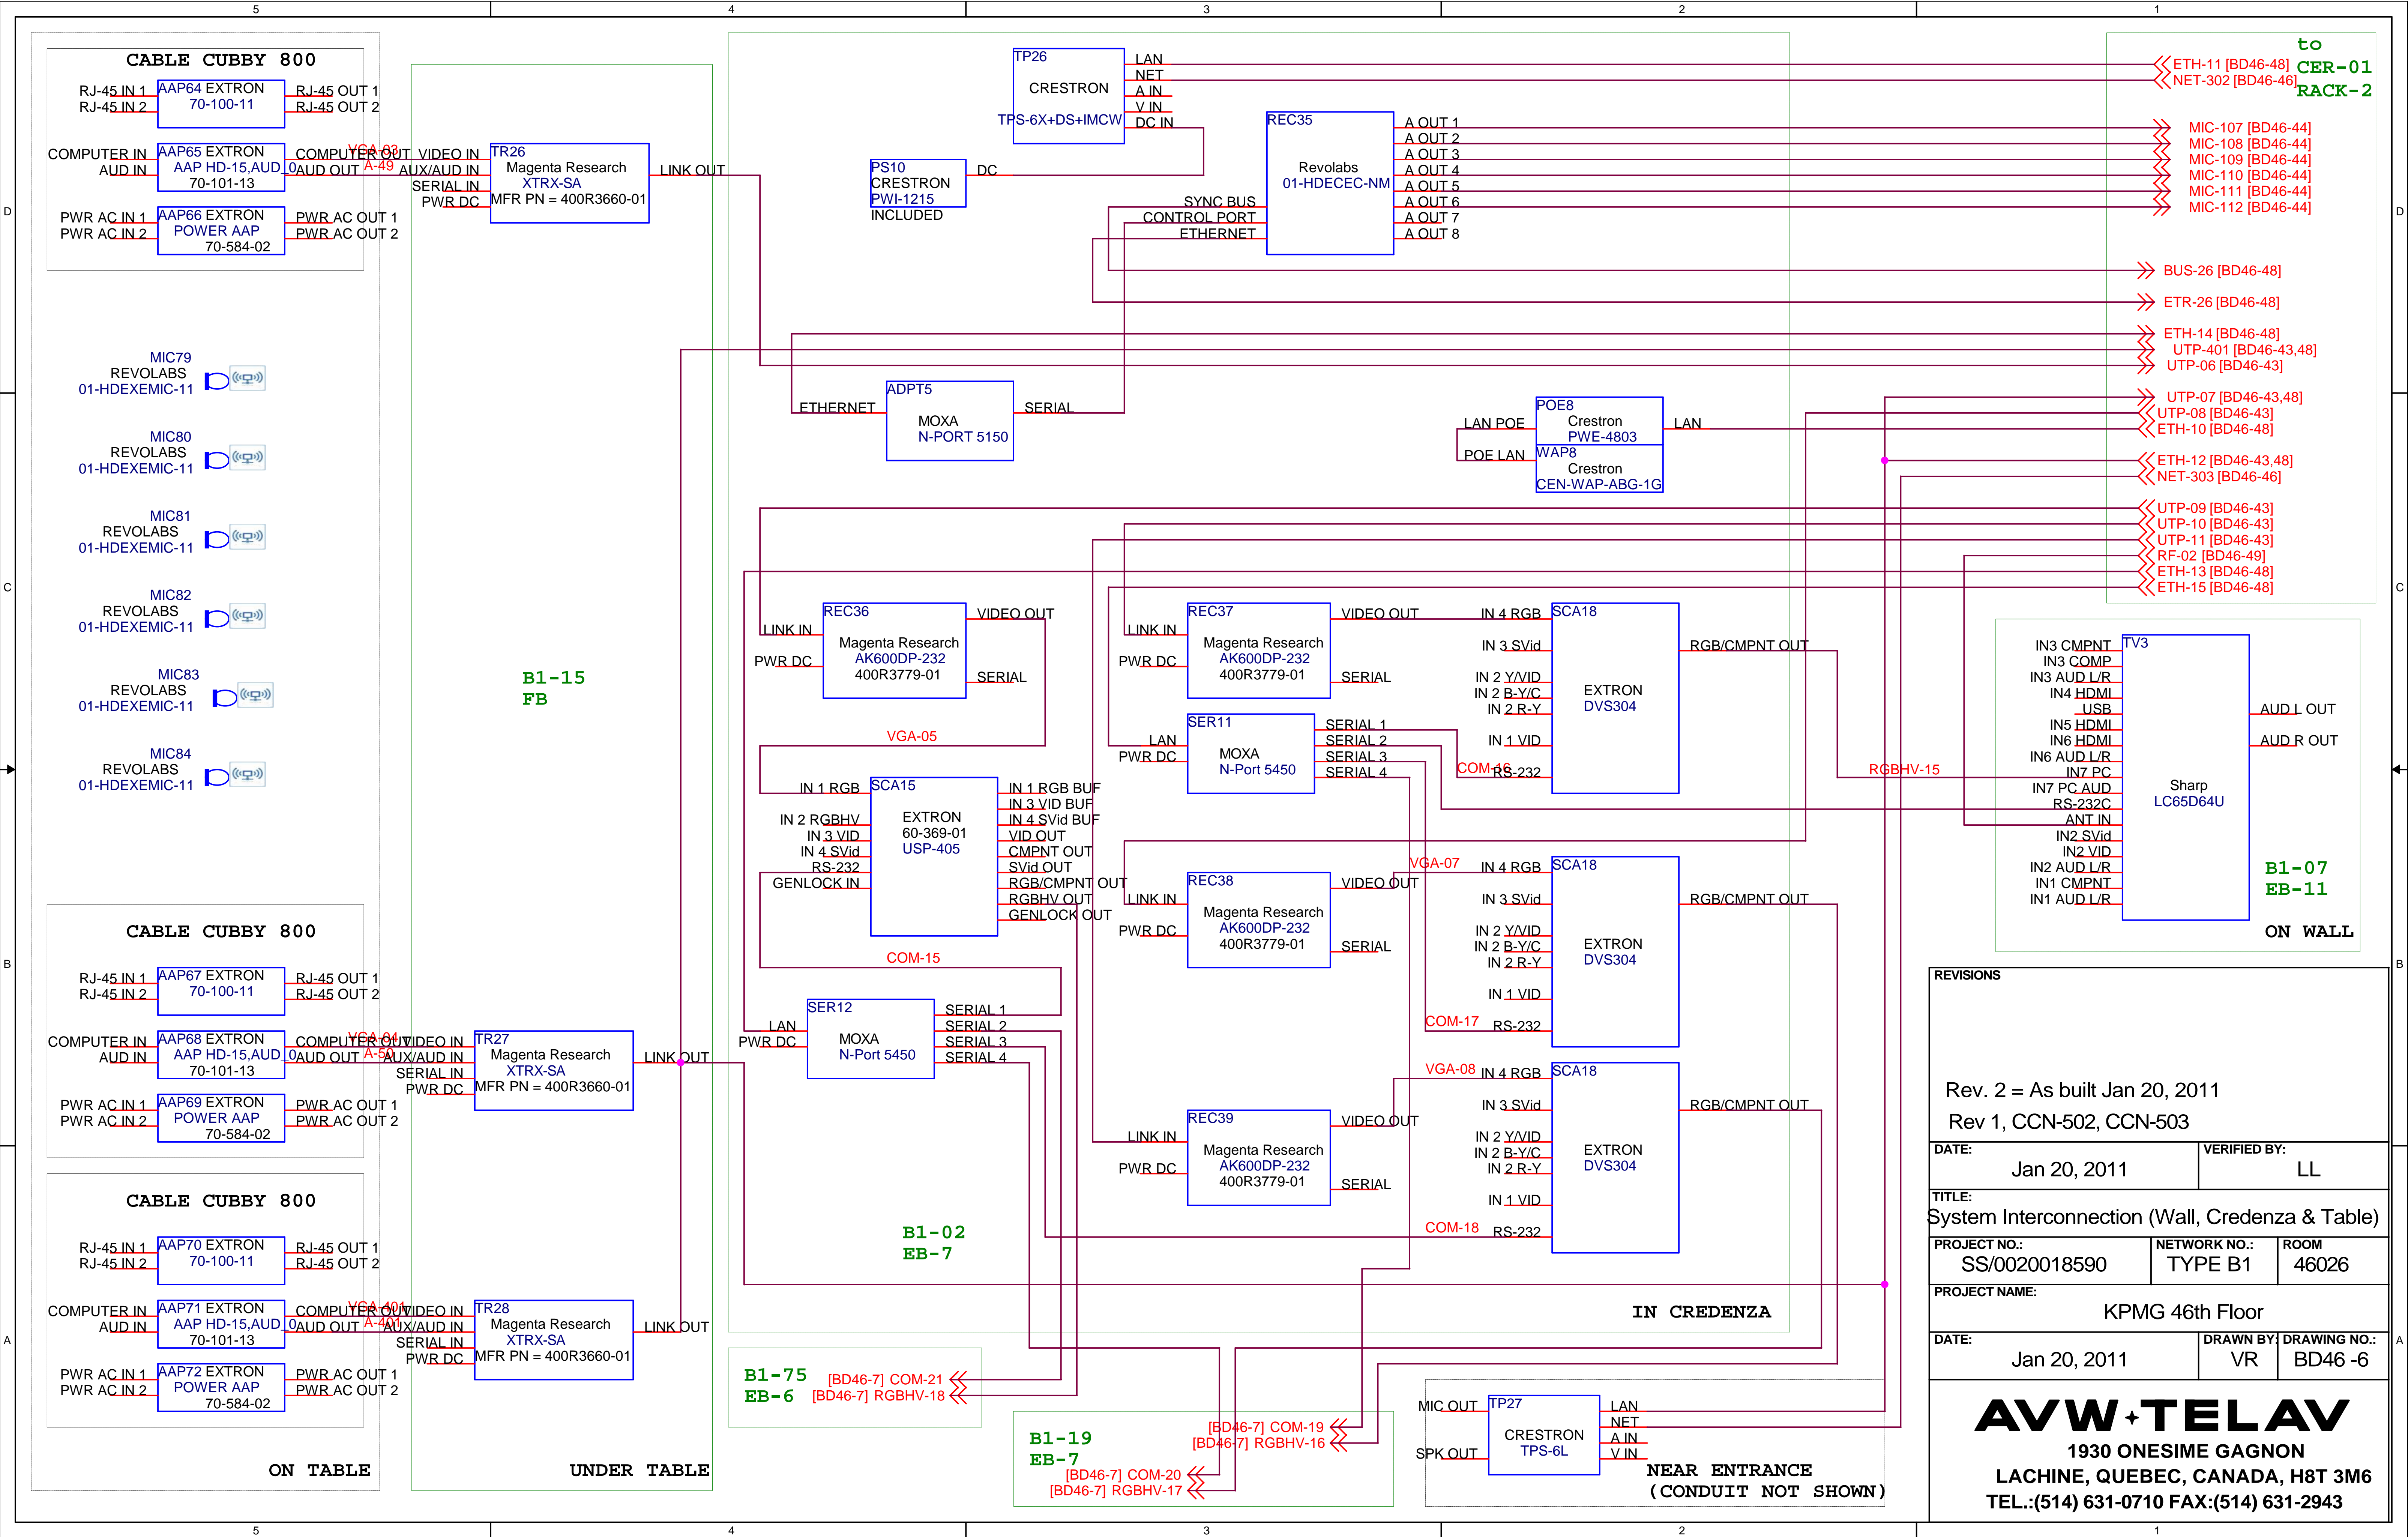

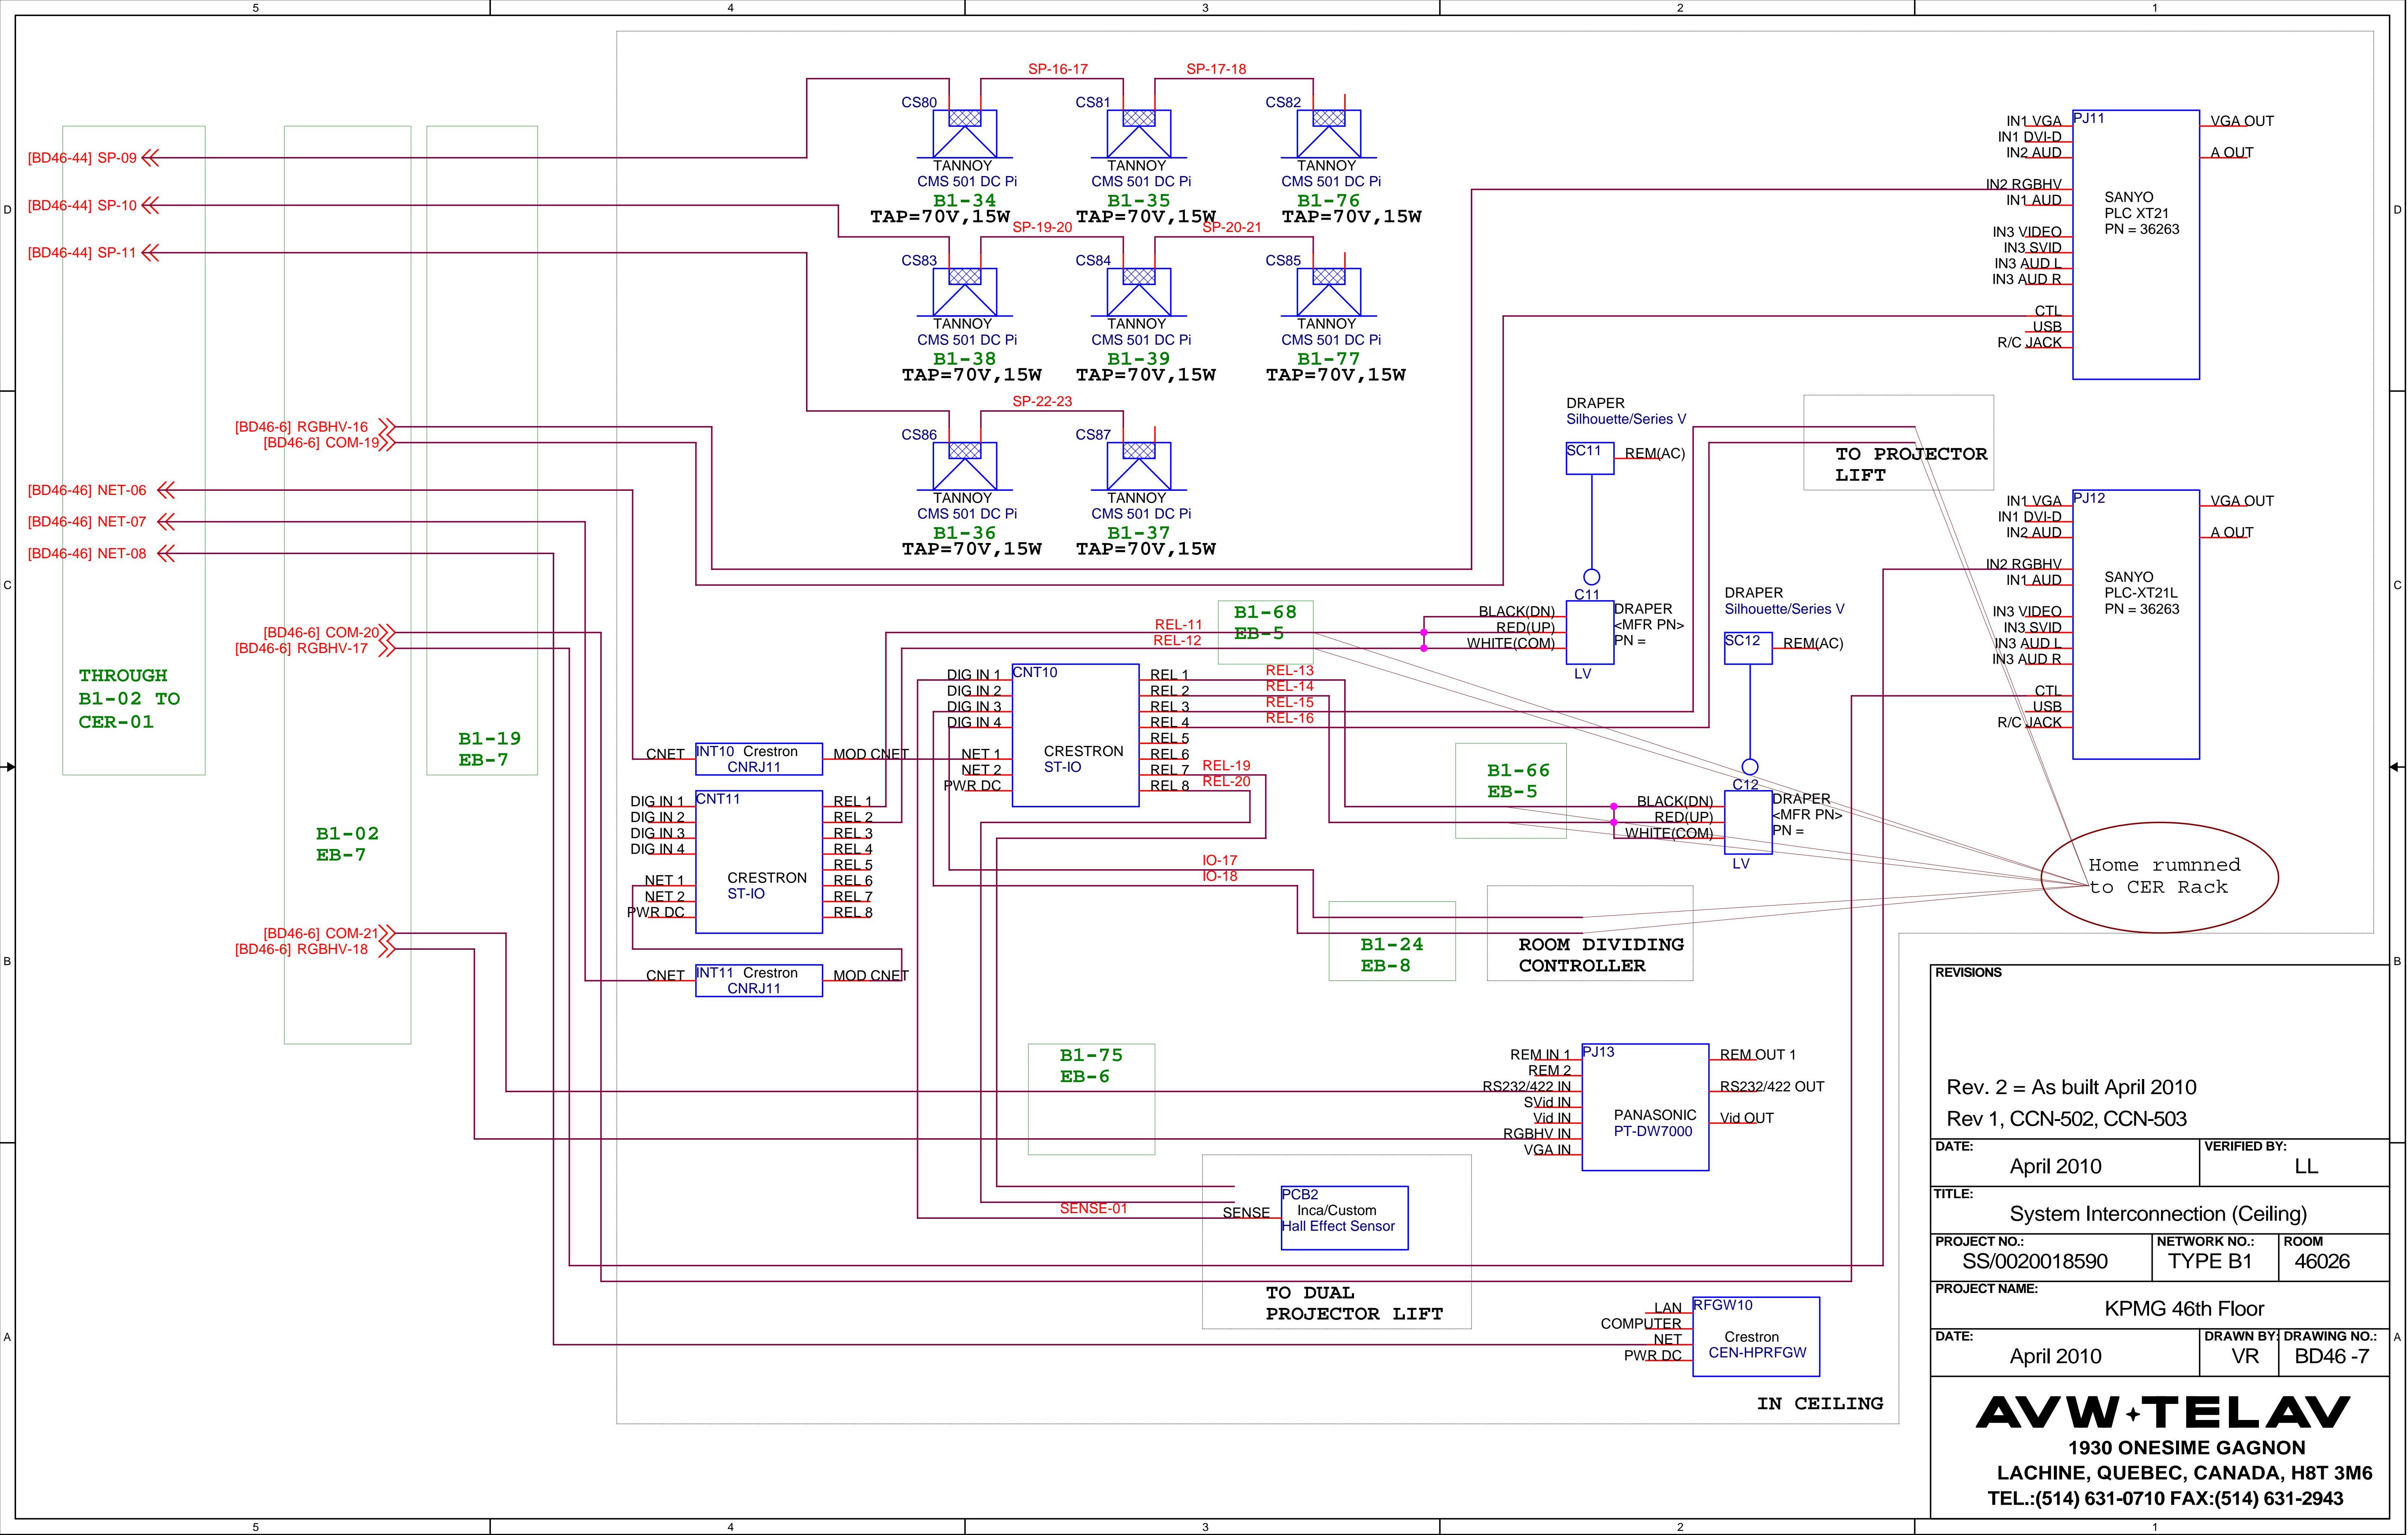

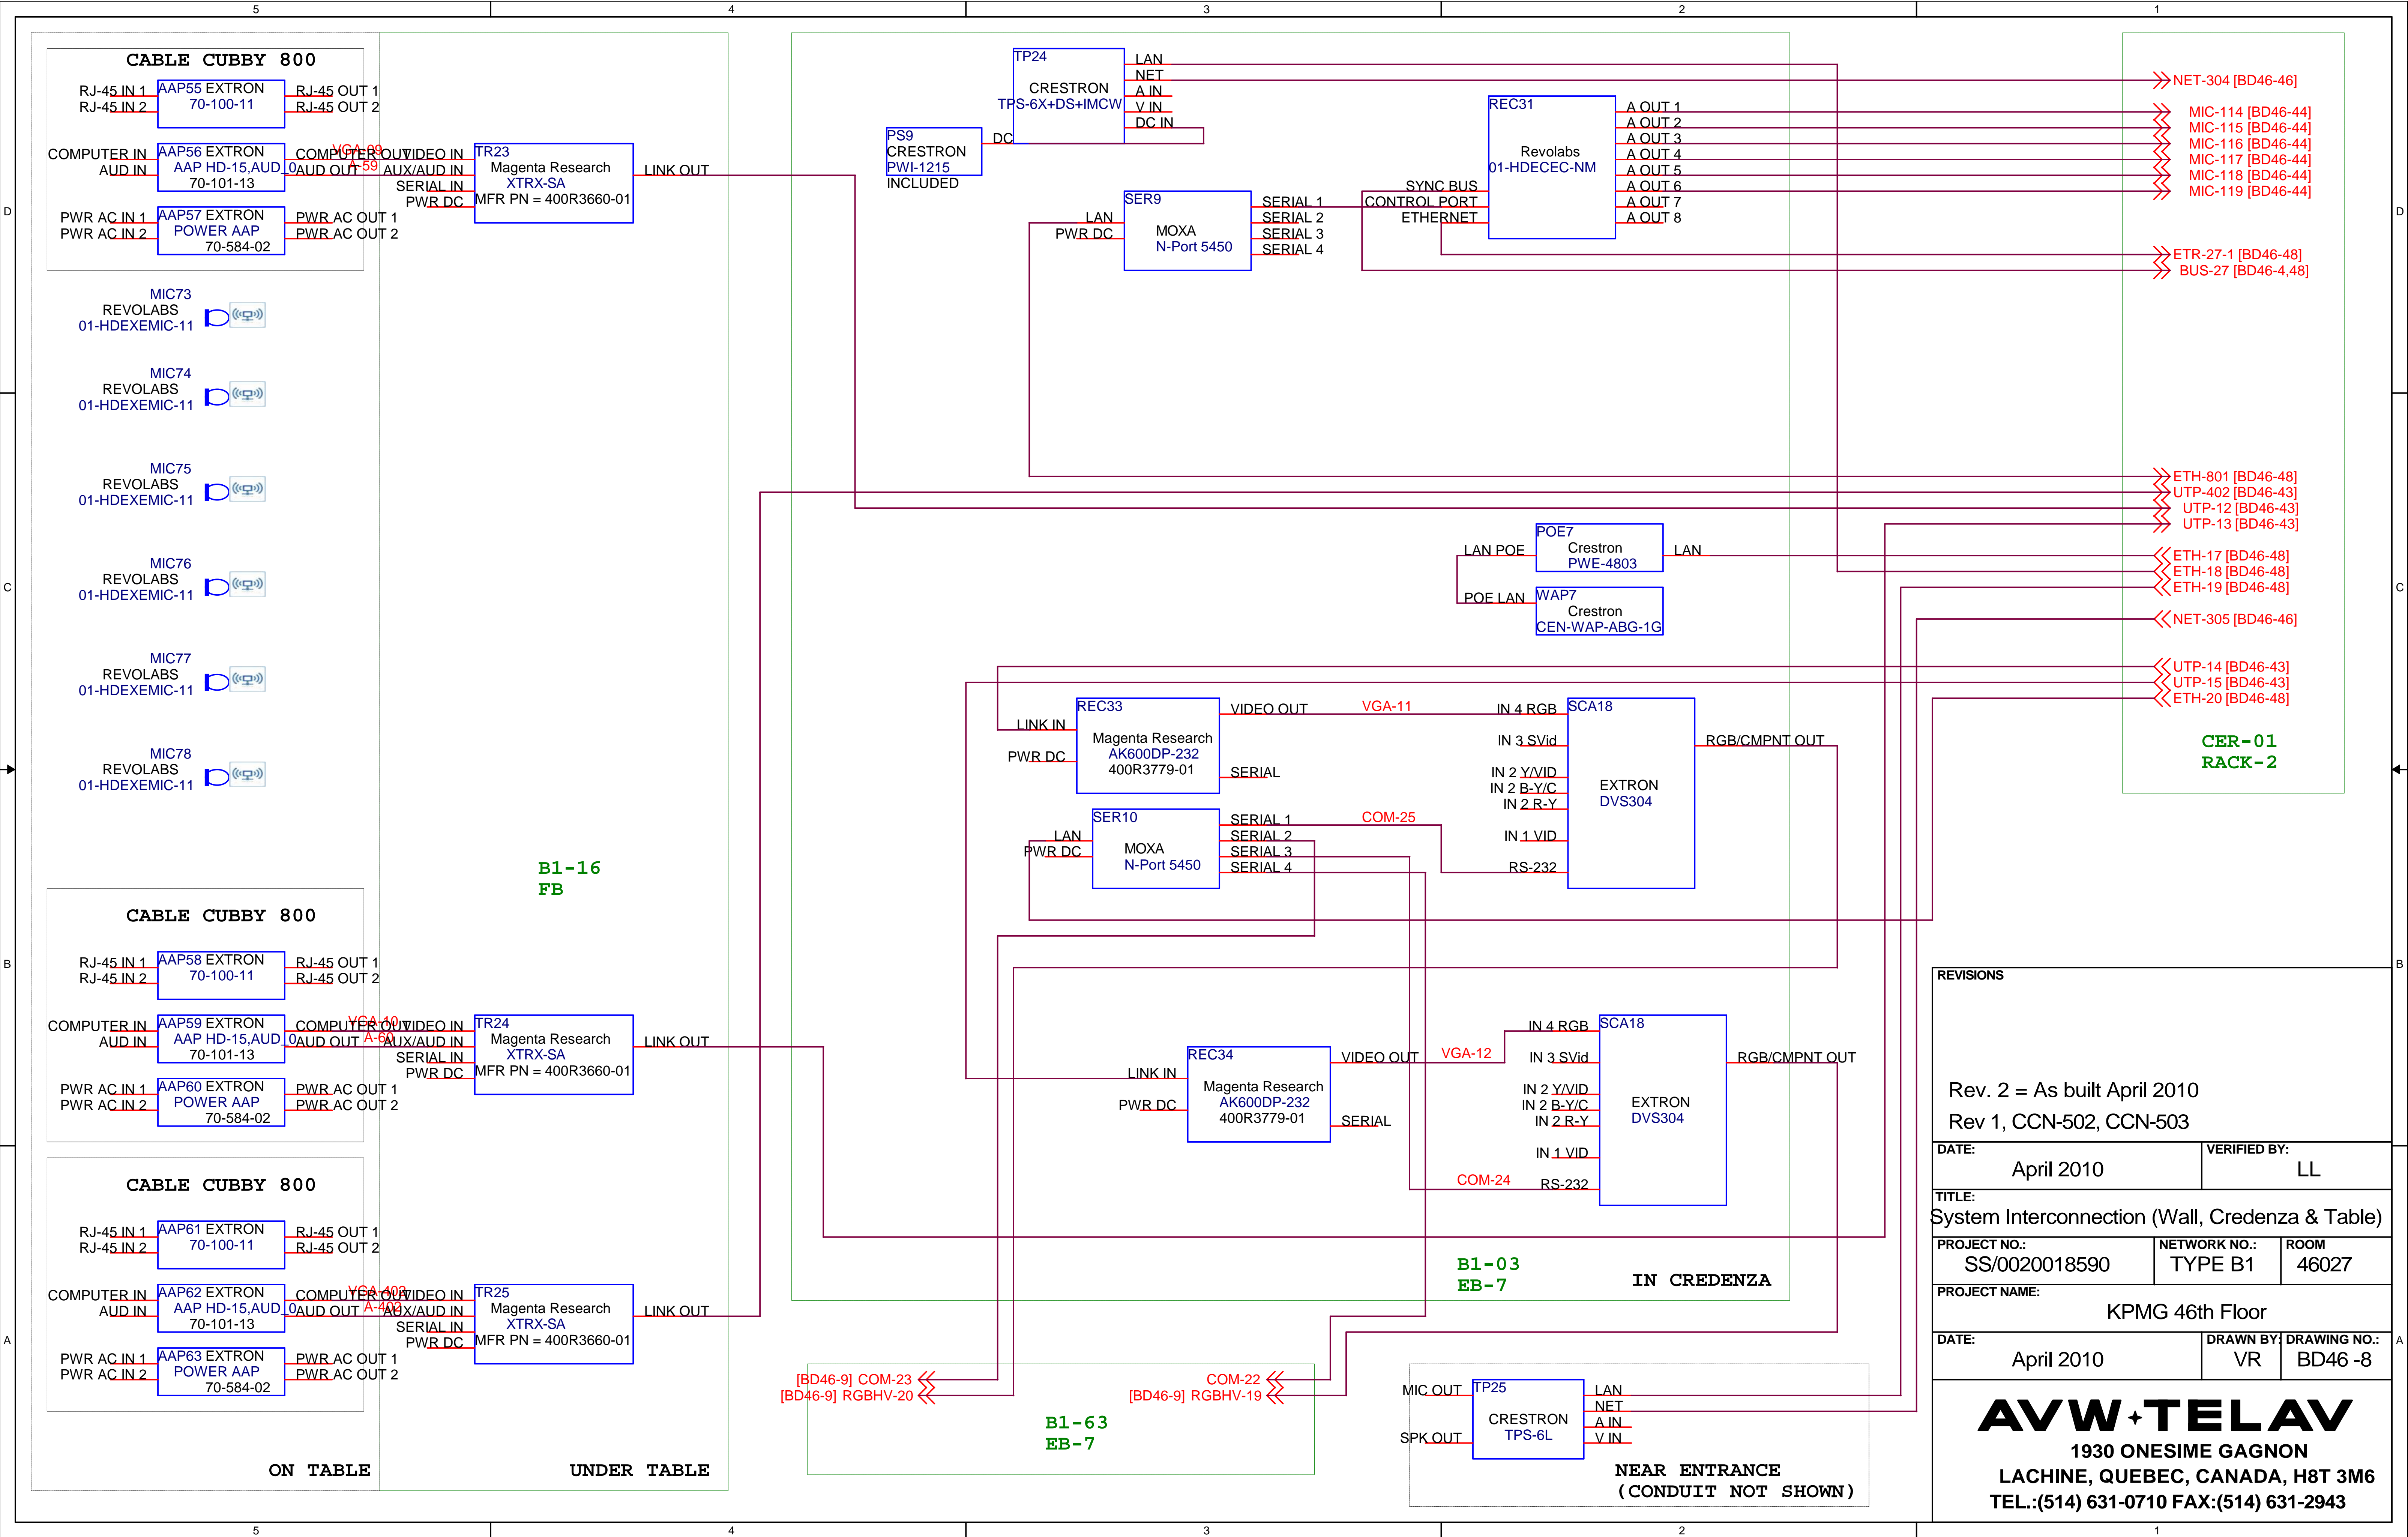

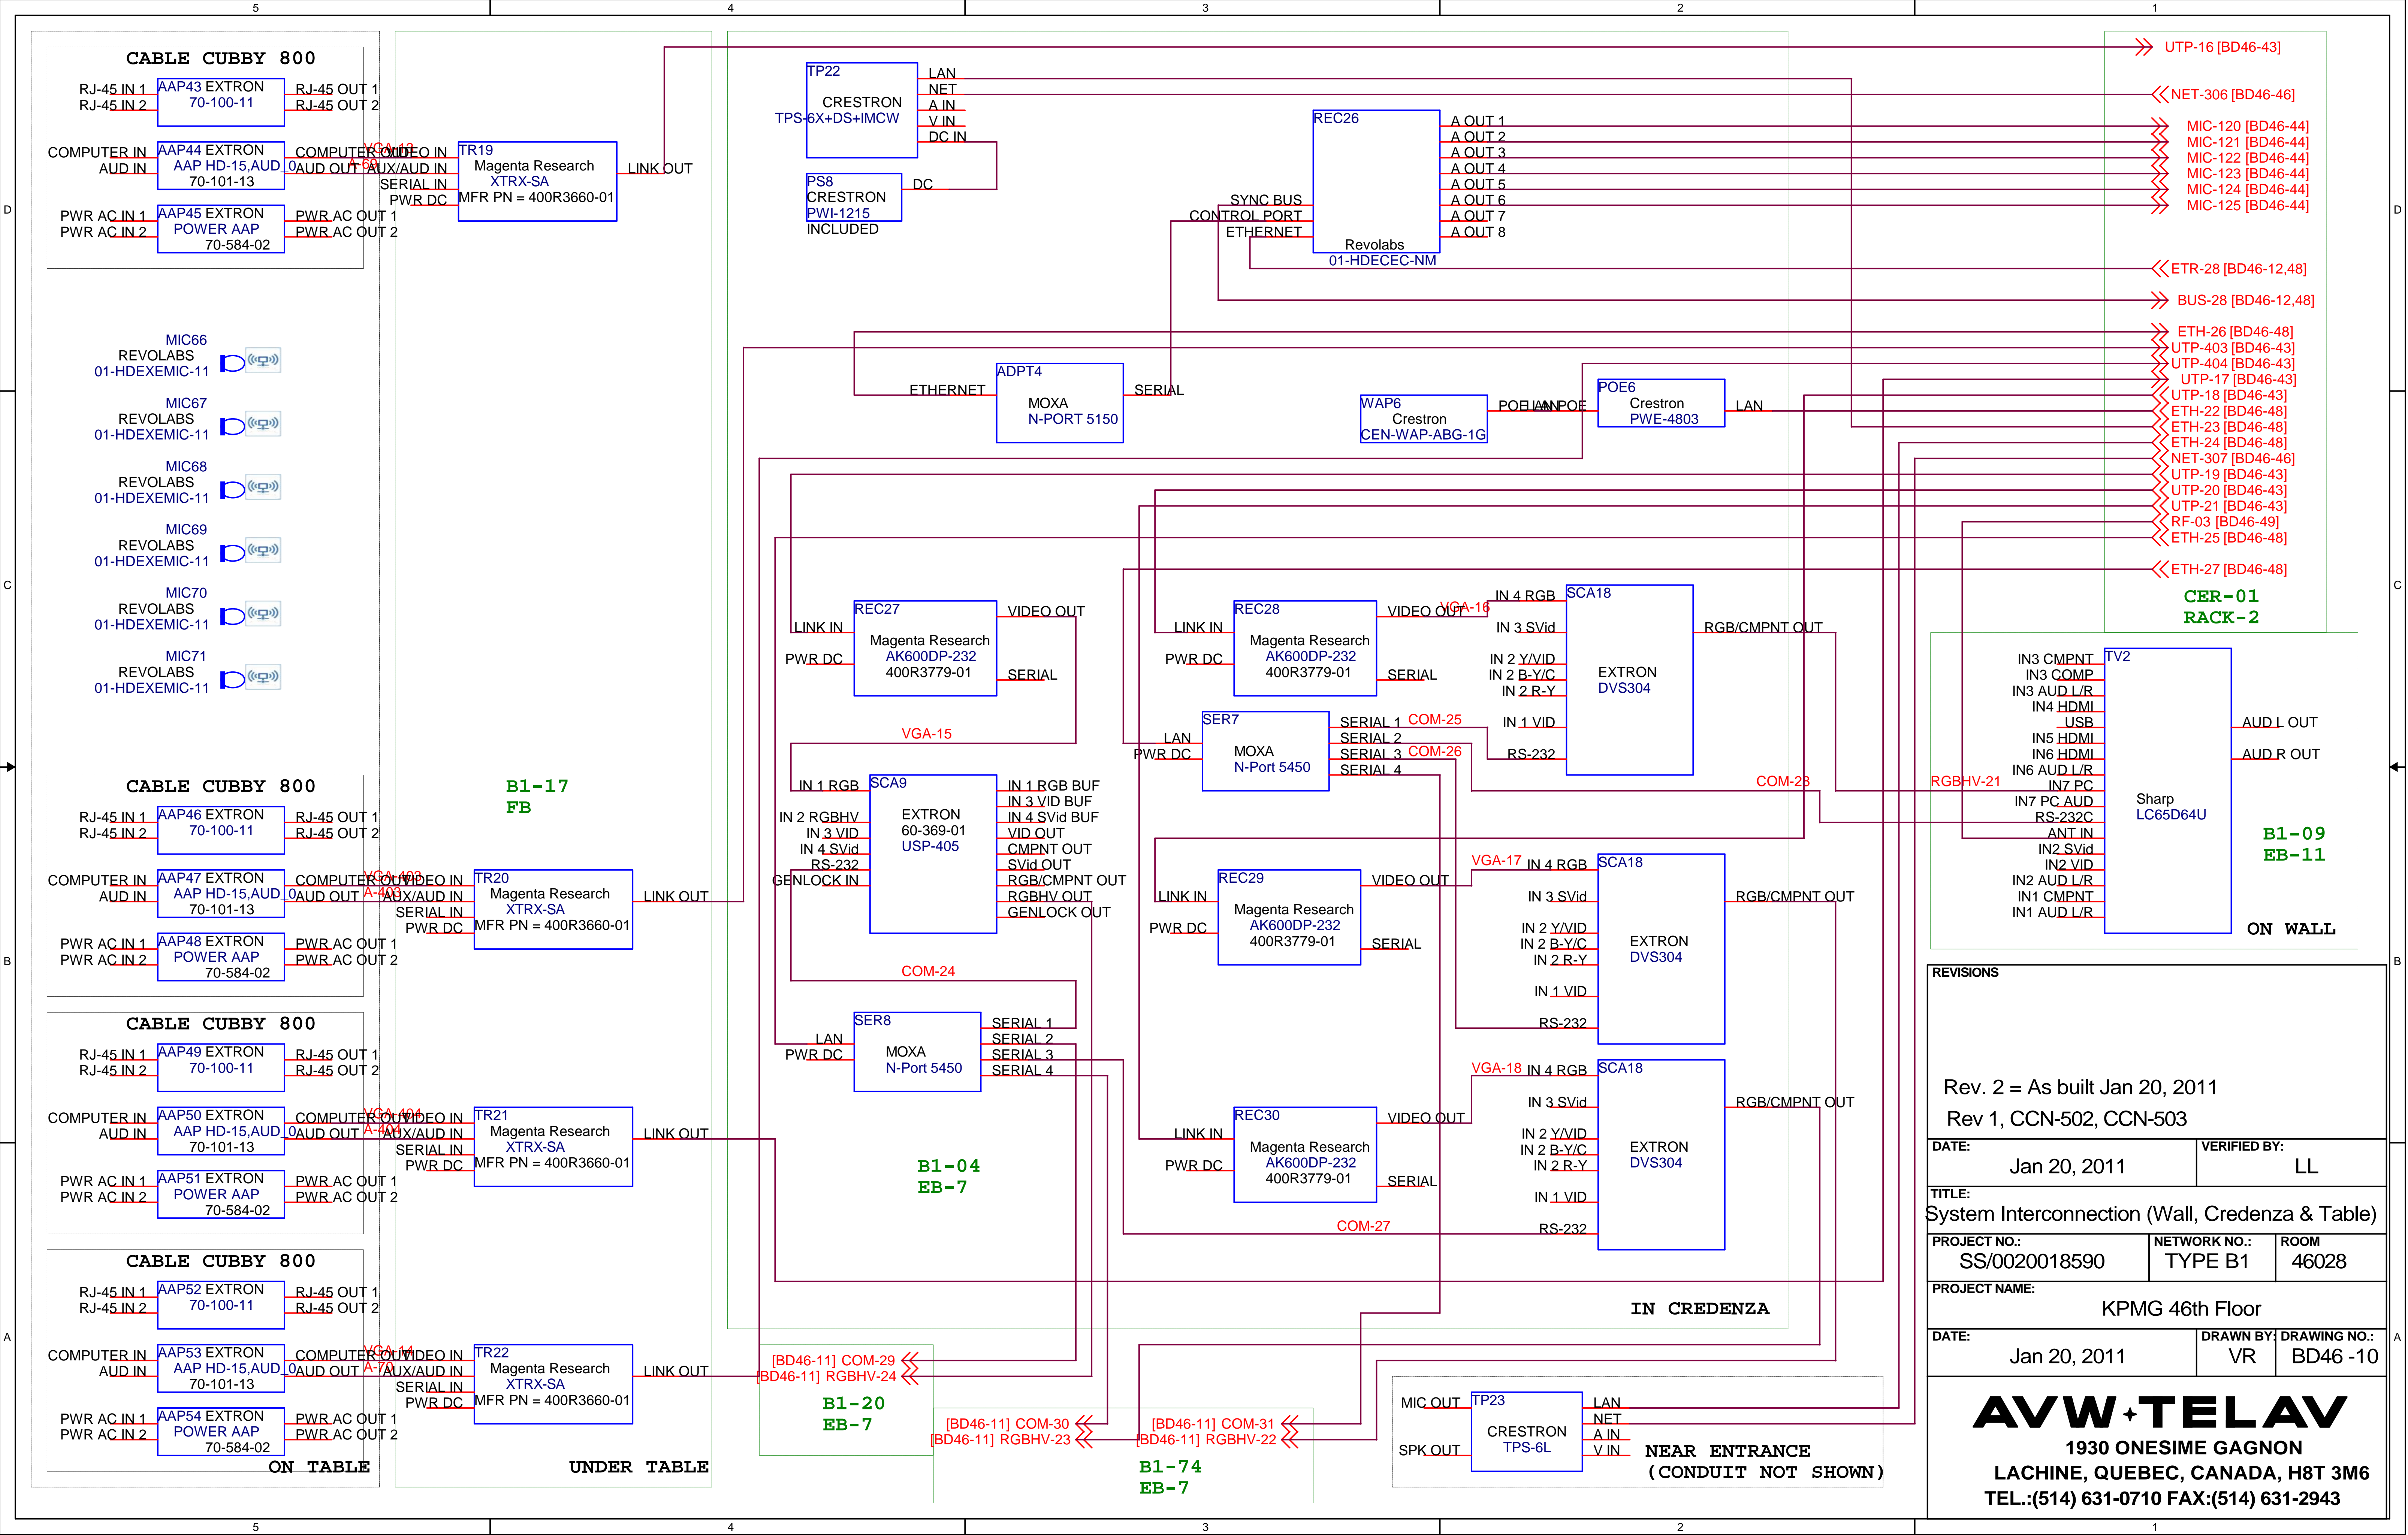

REVISIONS

Rev. 2 = As built Jan 20, 2011

Rev 1, CCN-502, CCN-503


| | | | |
|---|---------------|--------------|----------|
| DATE: | Jan 20, 2011 | VERIFIED BY: | LL |
| TITLE: System Interconnection (Wall, Credenza & Table) | | | |
| PROJECT NO.: | SS/0020018590 | NETWORK NO.: | TYPE B1 |
| PROJECT NAME: | | ROOM | |
| KPMG 46th Floor | | 46028 | |
| DATE: | Jan 20, 2011 | DRAWN BY: | VR |
| | | DRAWING NO.: | BD46 -10 |


AVW+TELAV


1930 ONESIME GAGNON

LACHINE, QUEBEC, CANADA, H8T 3M6


TEL.:(514) 631-0710 FAX:(514) 631-2943

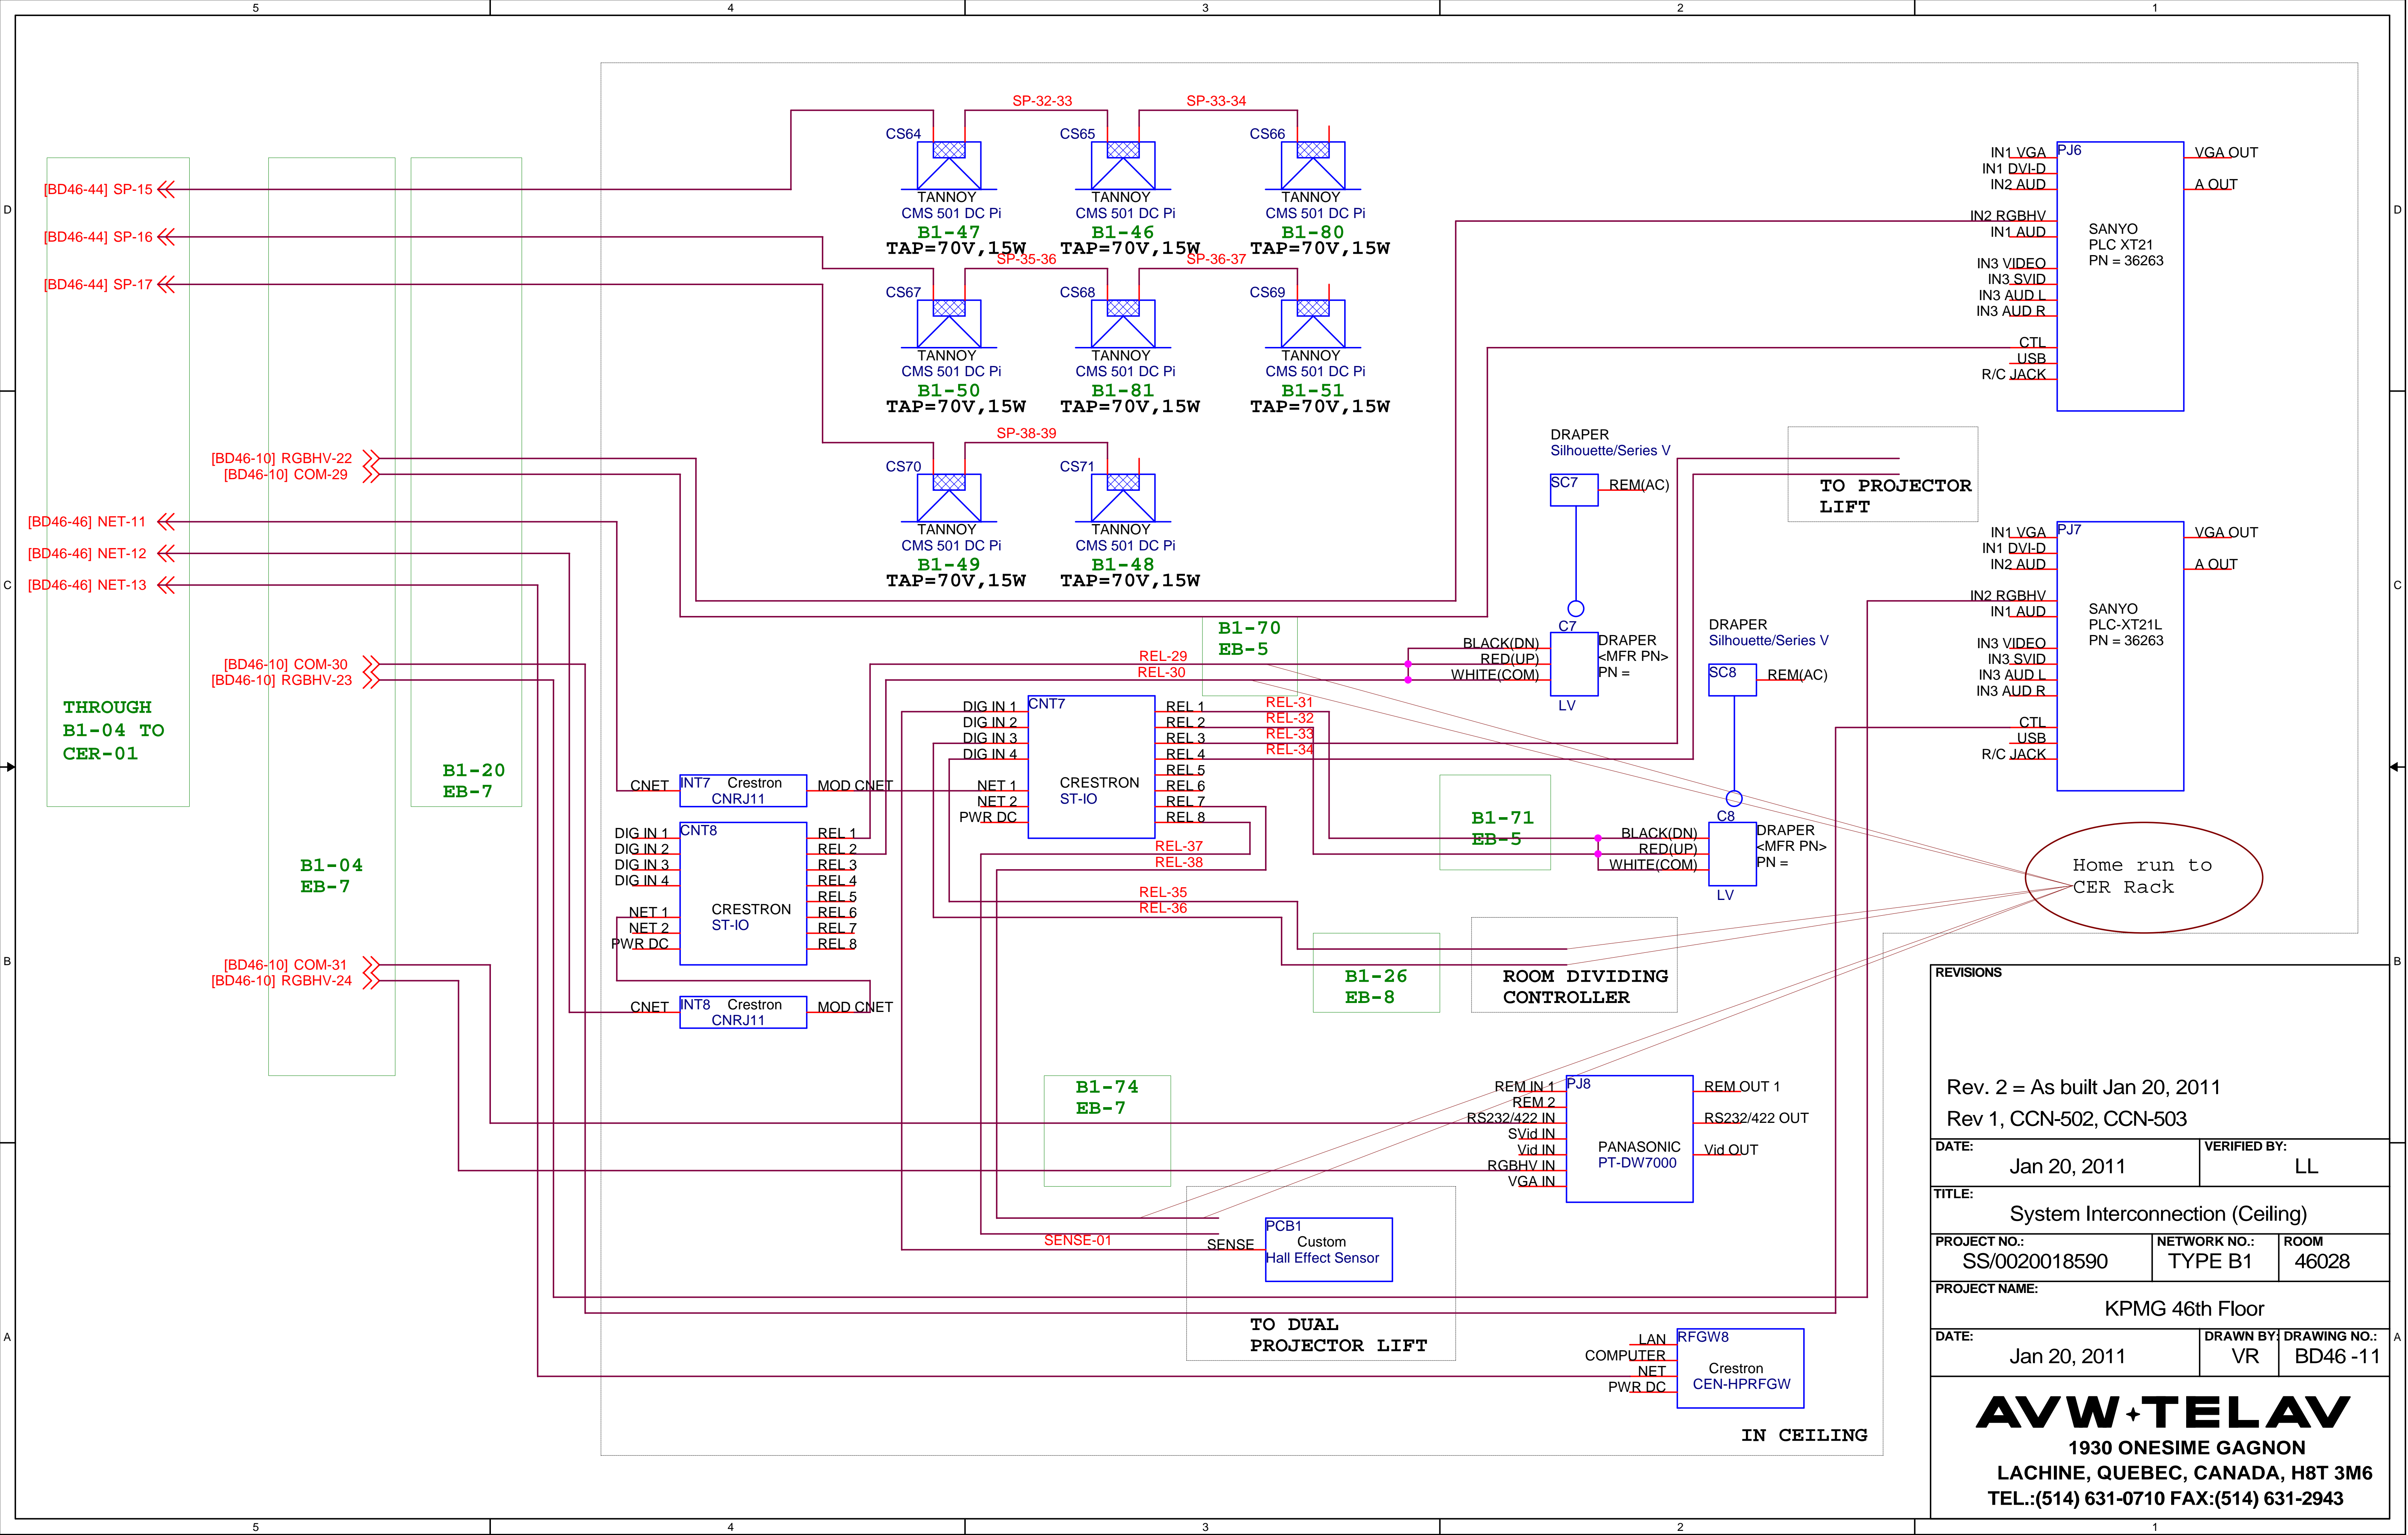


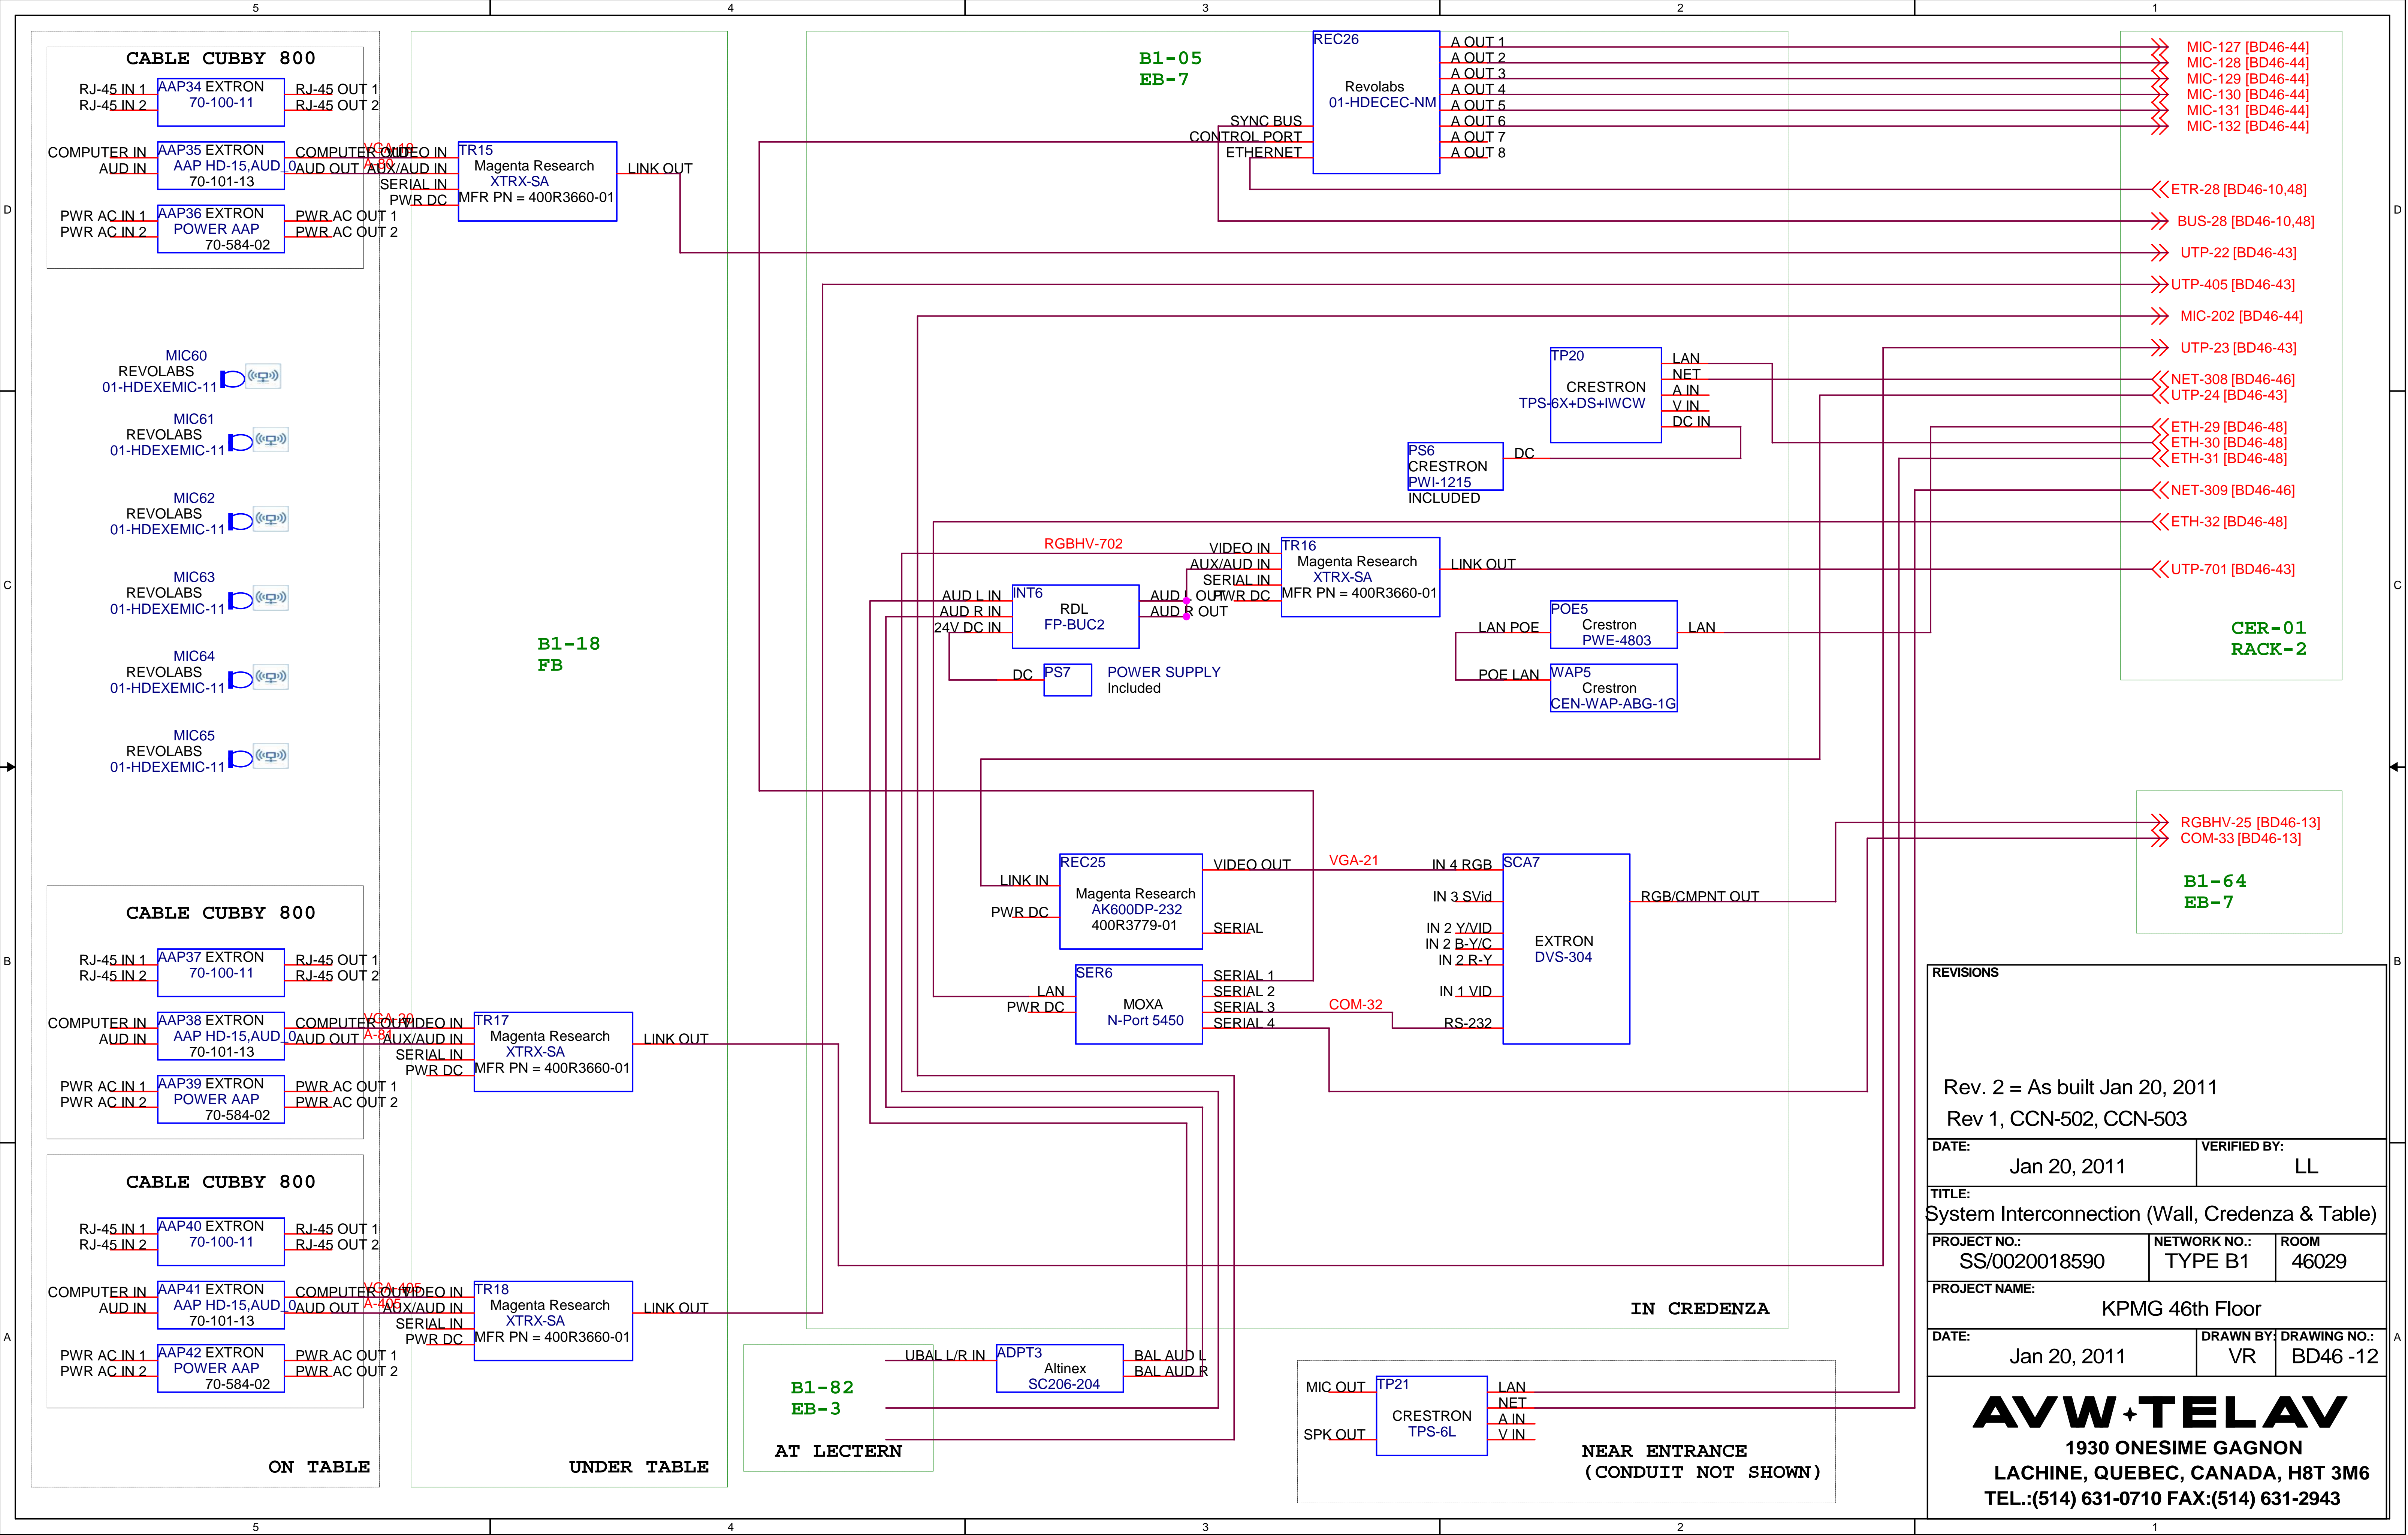


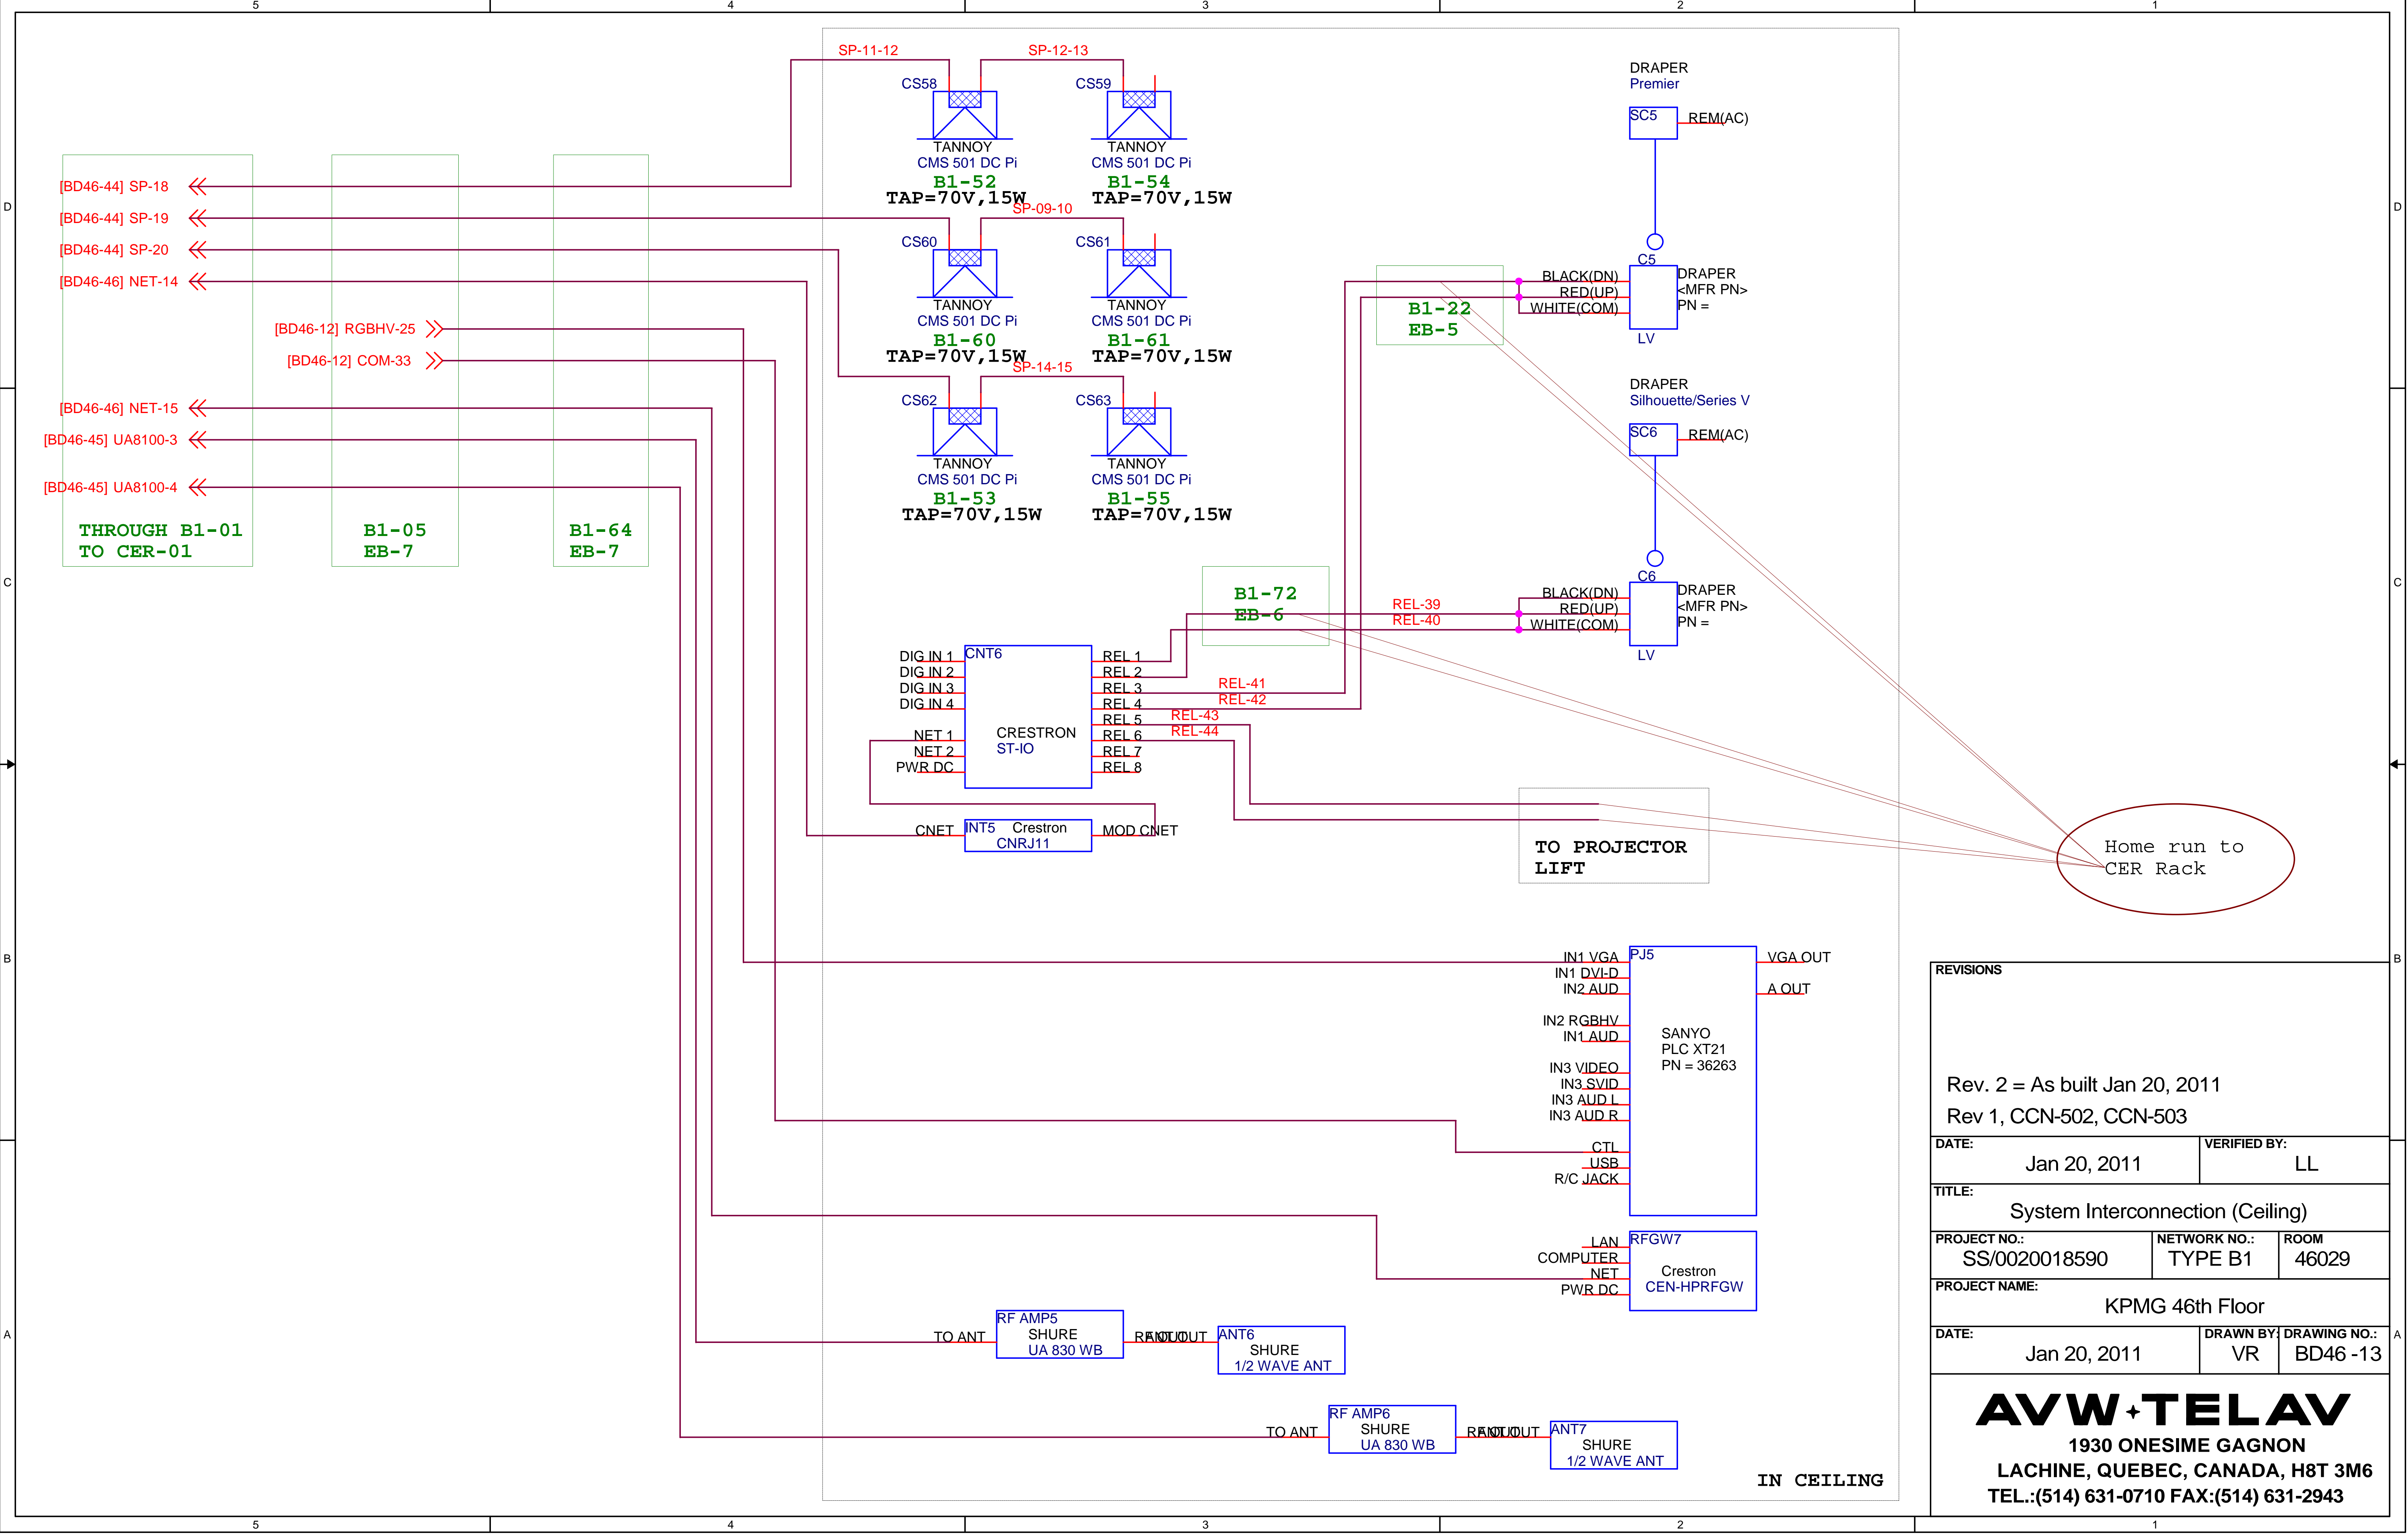


| REVISIONS | | |
|---|-------------------------|---------------------------------------|
| Rev. 2 = As built Jan 20, 2011 Rev 1, CCN-502, CCN-503 | | |
| DATE: | Jan 20, 2011 | VERIFIED BY: LL |
| TITLE: System Interconnection (Ceiling) | | |
| PROJECT NO.: SS/0020018590 | NETWORK NO.: TYPE B1 | ROOM 46029 |
| PROJECT NAME: KPMG 46th Floor | | |
| DATE: | Jan 20, 2011 | DRAWN BY: VR DRAWING NO.: BD46 -13 |
| AVW+TELAV 1930 ONESIME GAGNON LACHINE, QUEBEC, CANADA, H8T 3M6 TEL.:(514) 631-0710 FAX:(514) 631-2943 | | |

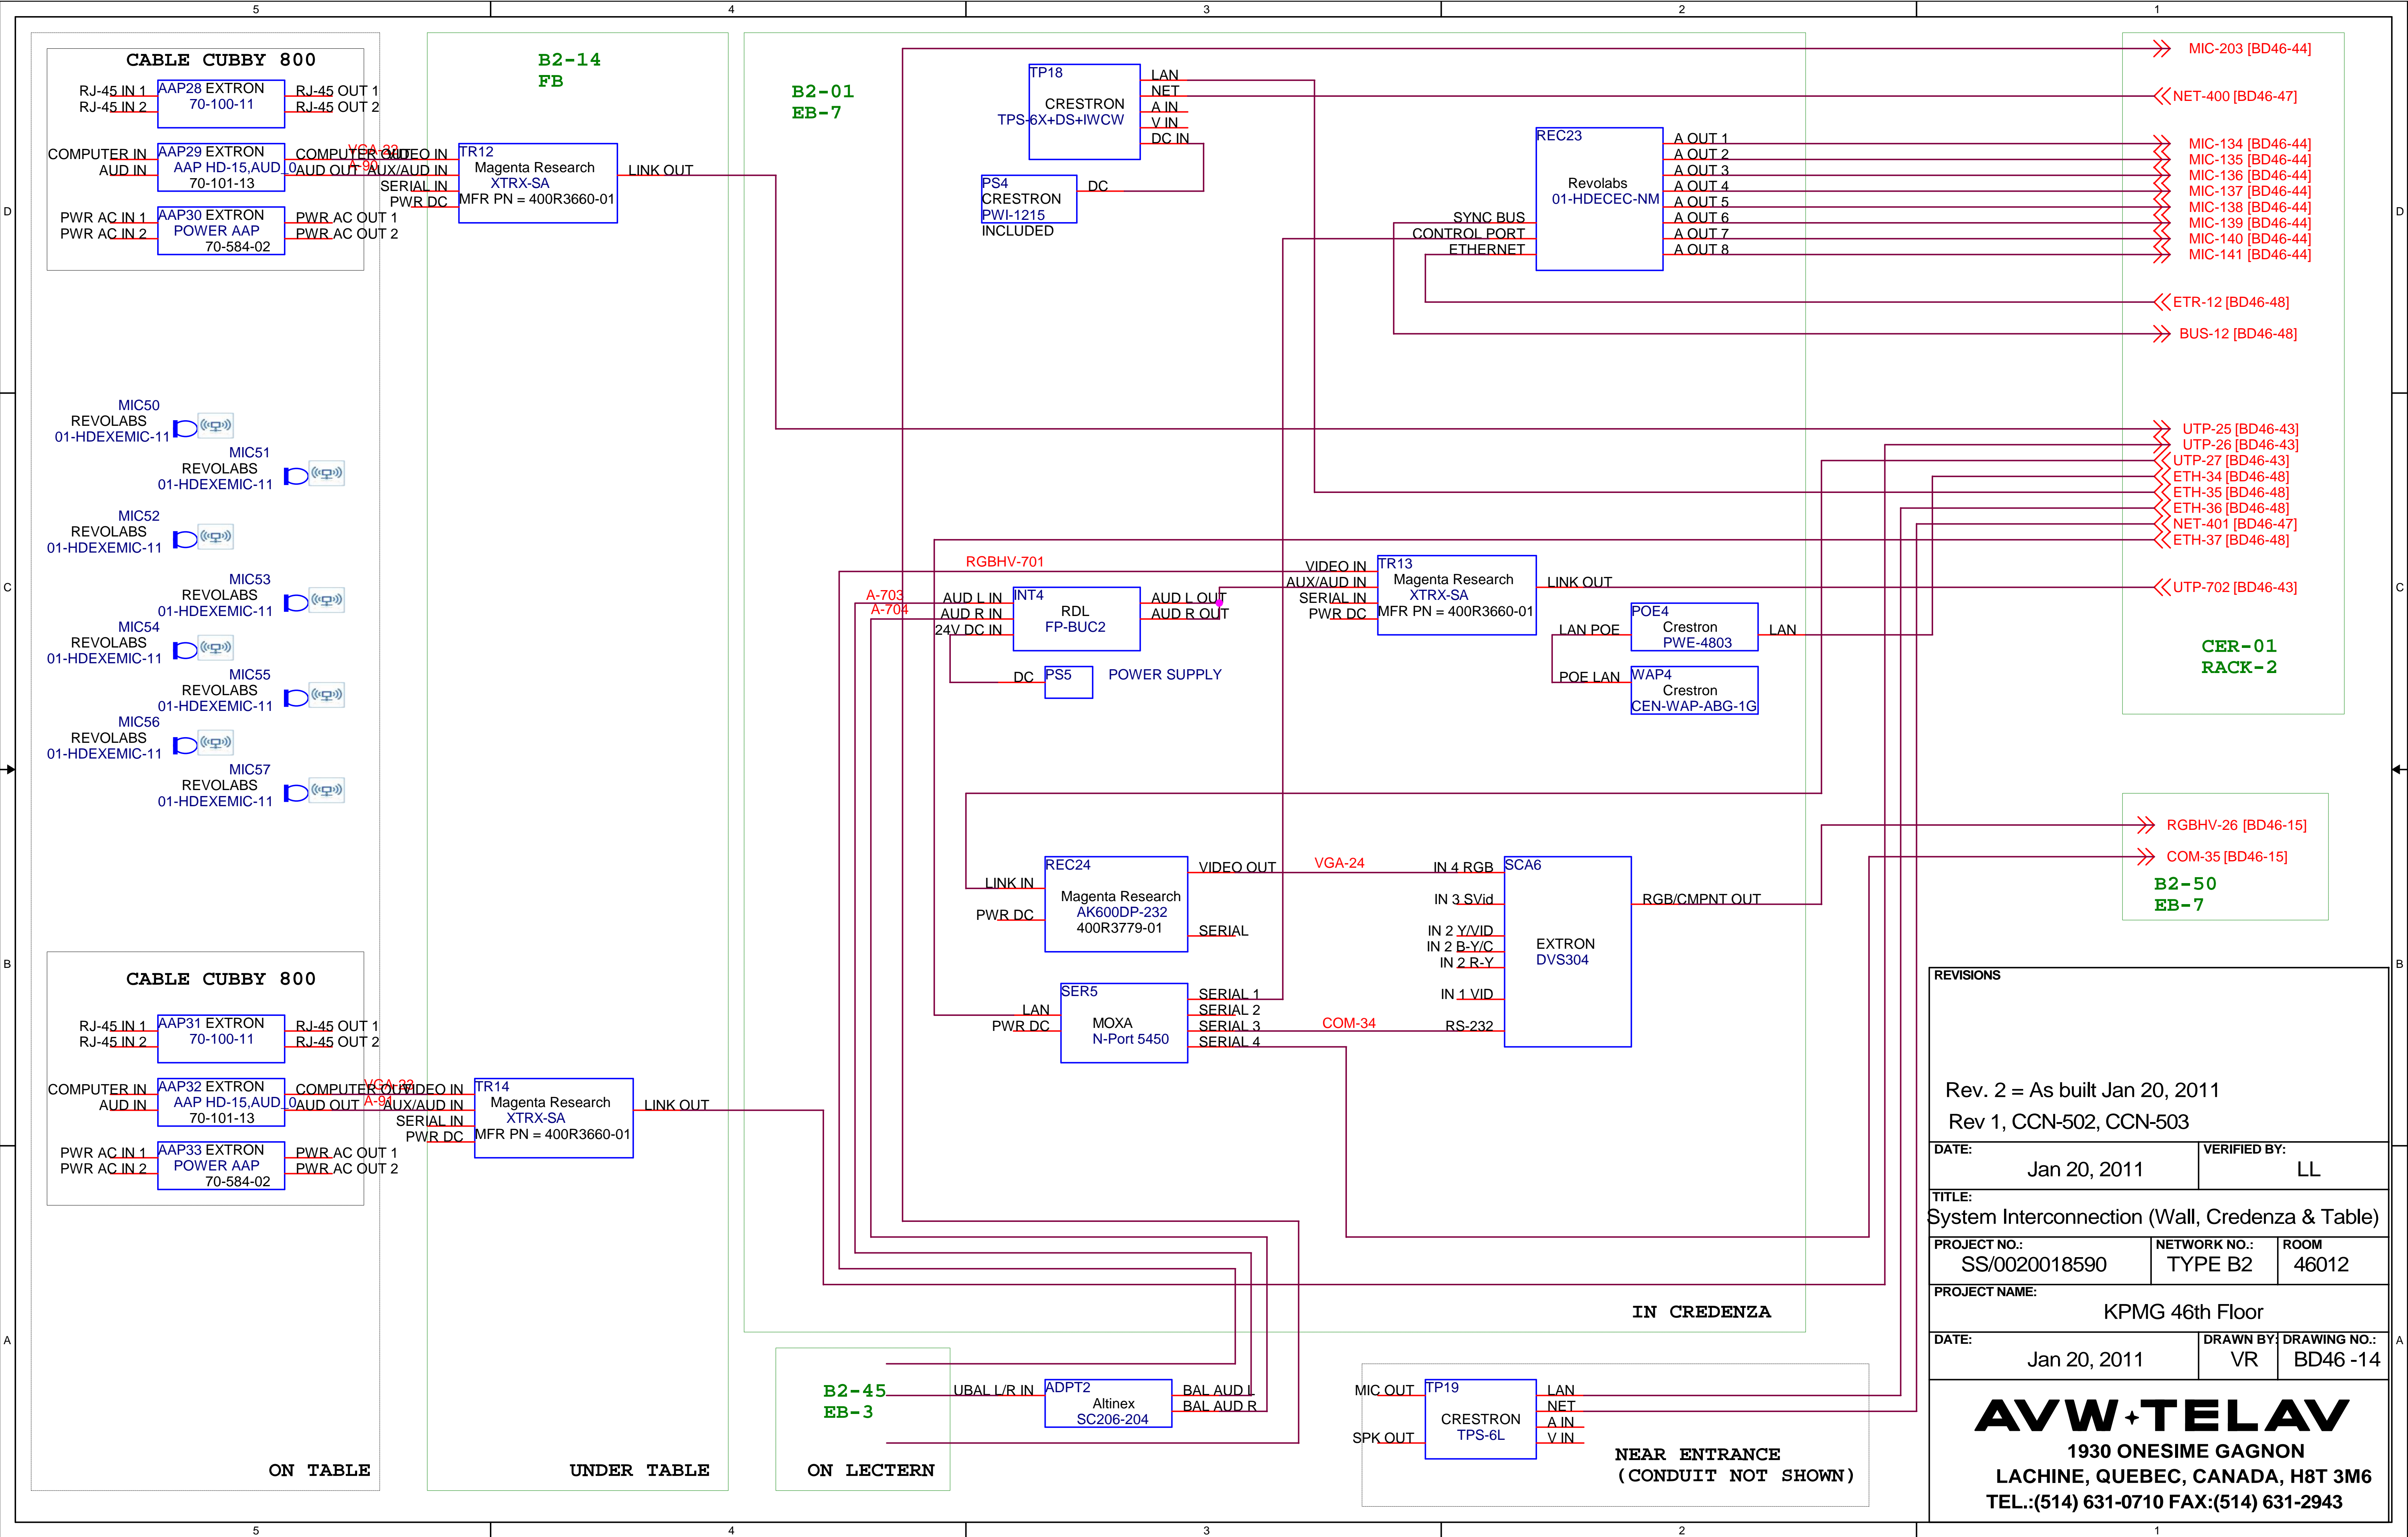

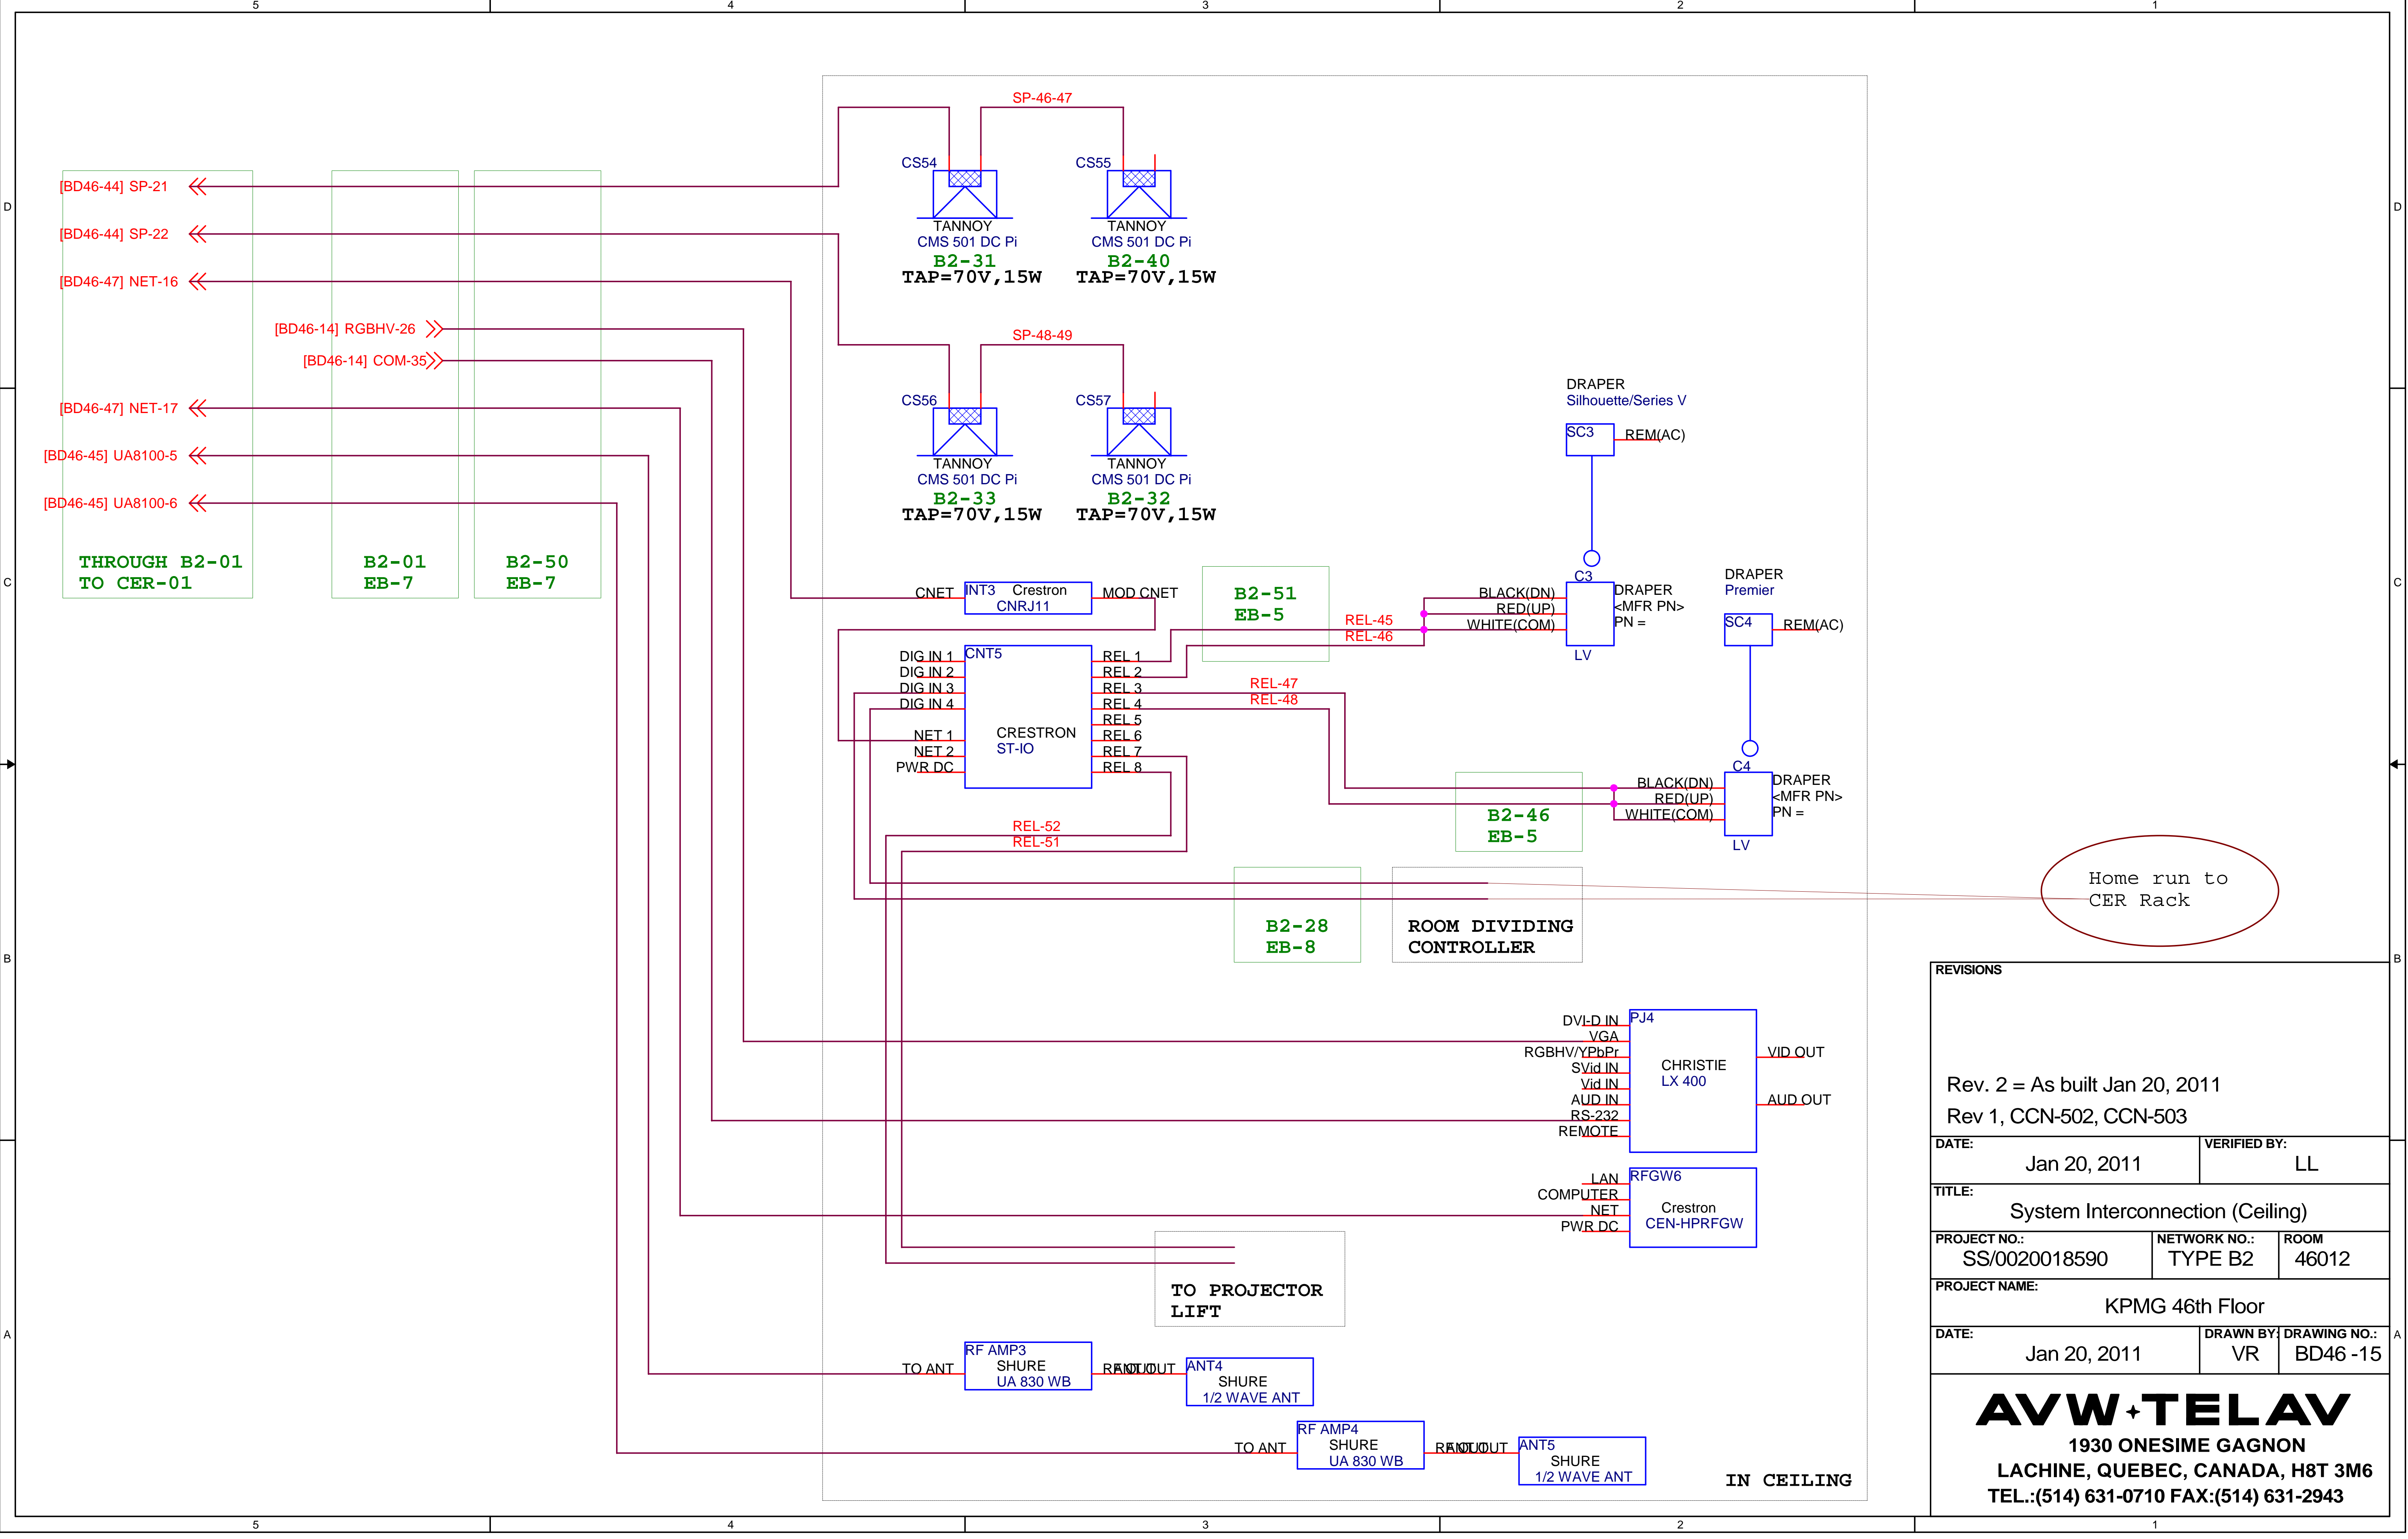

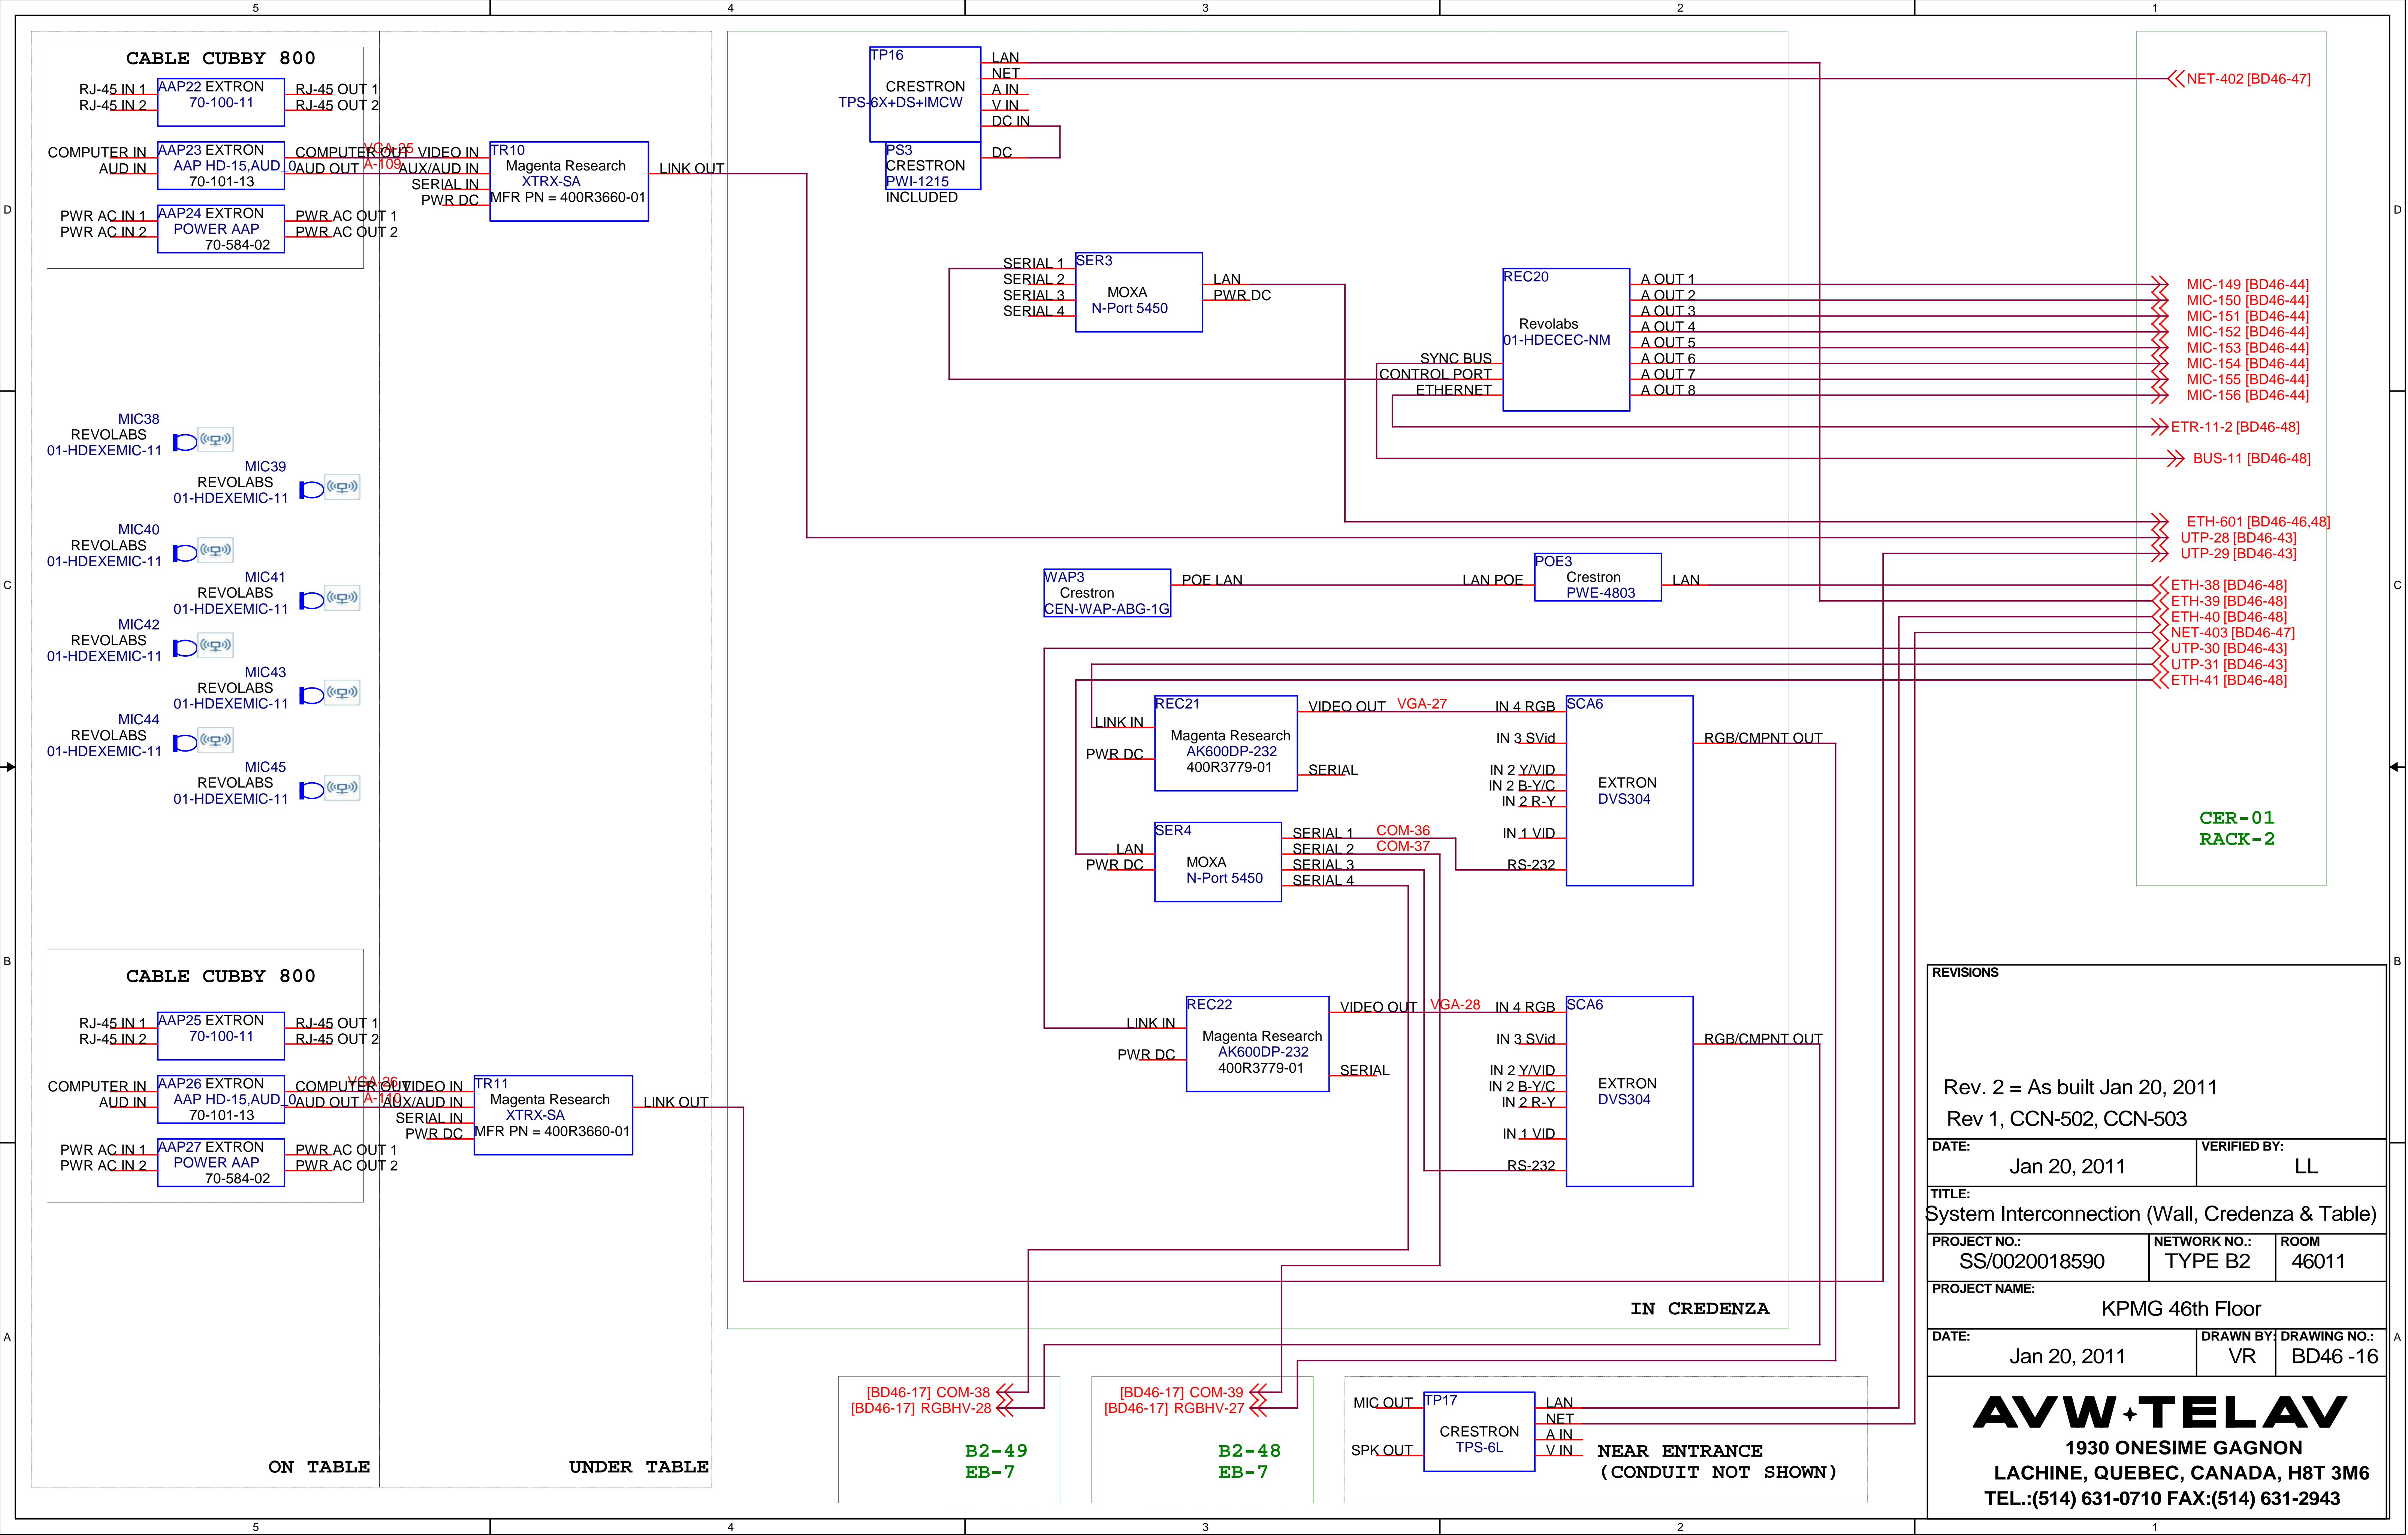

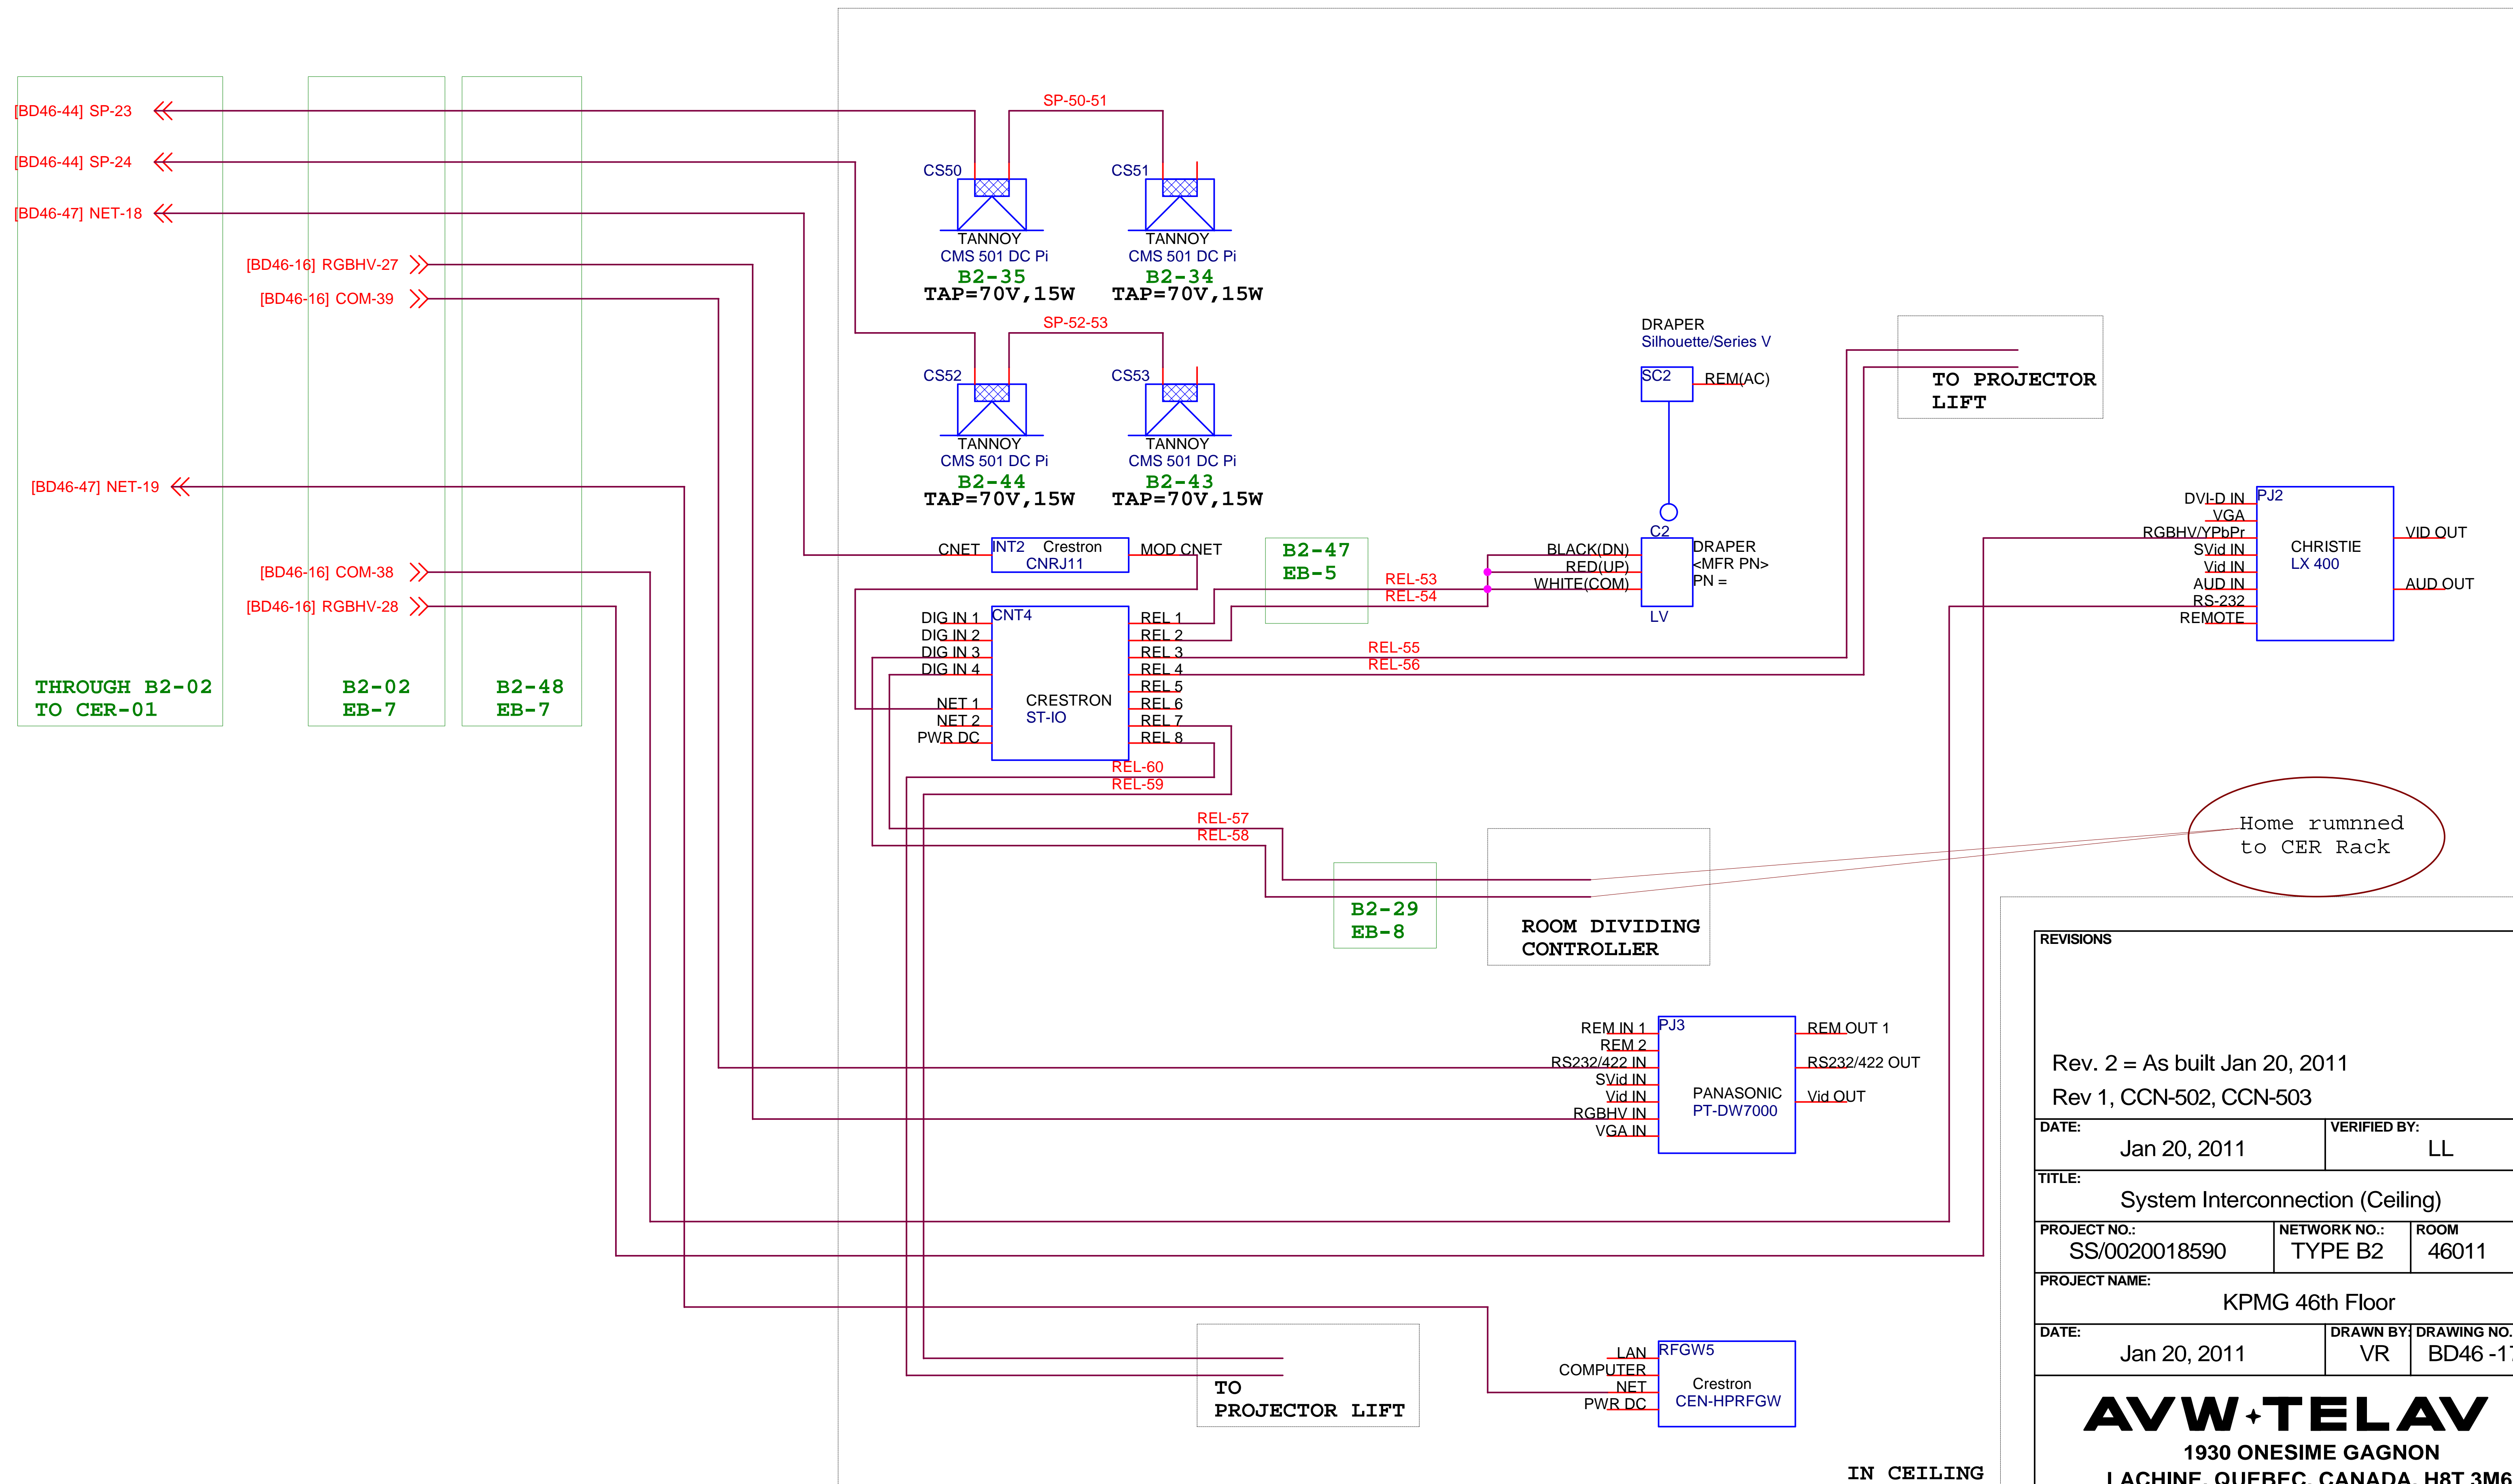


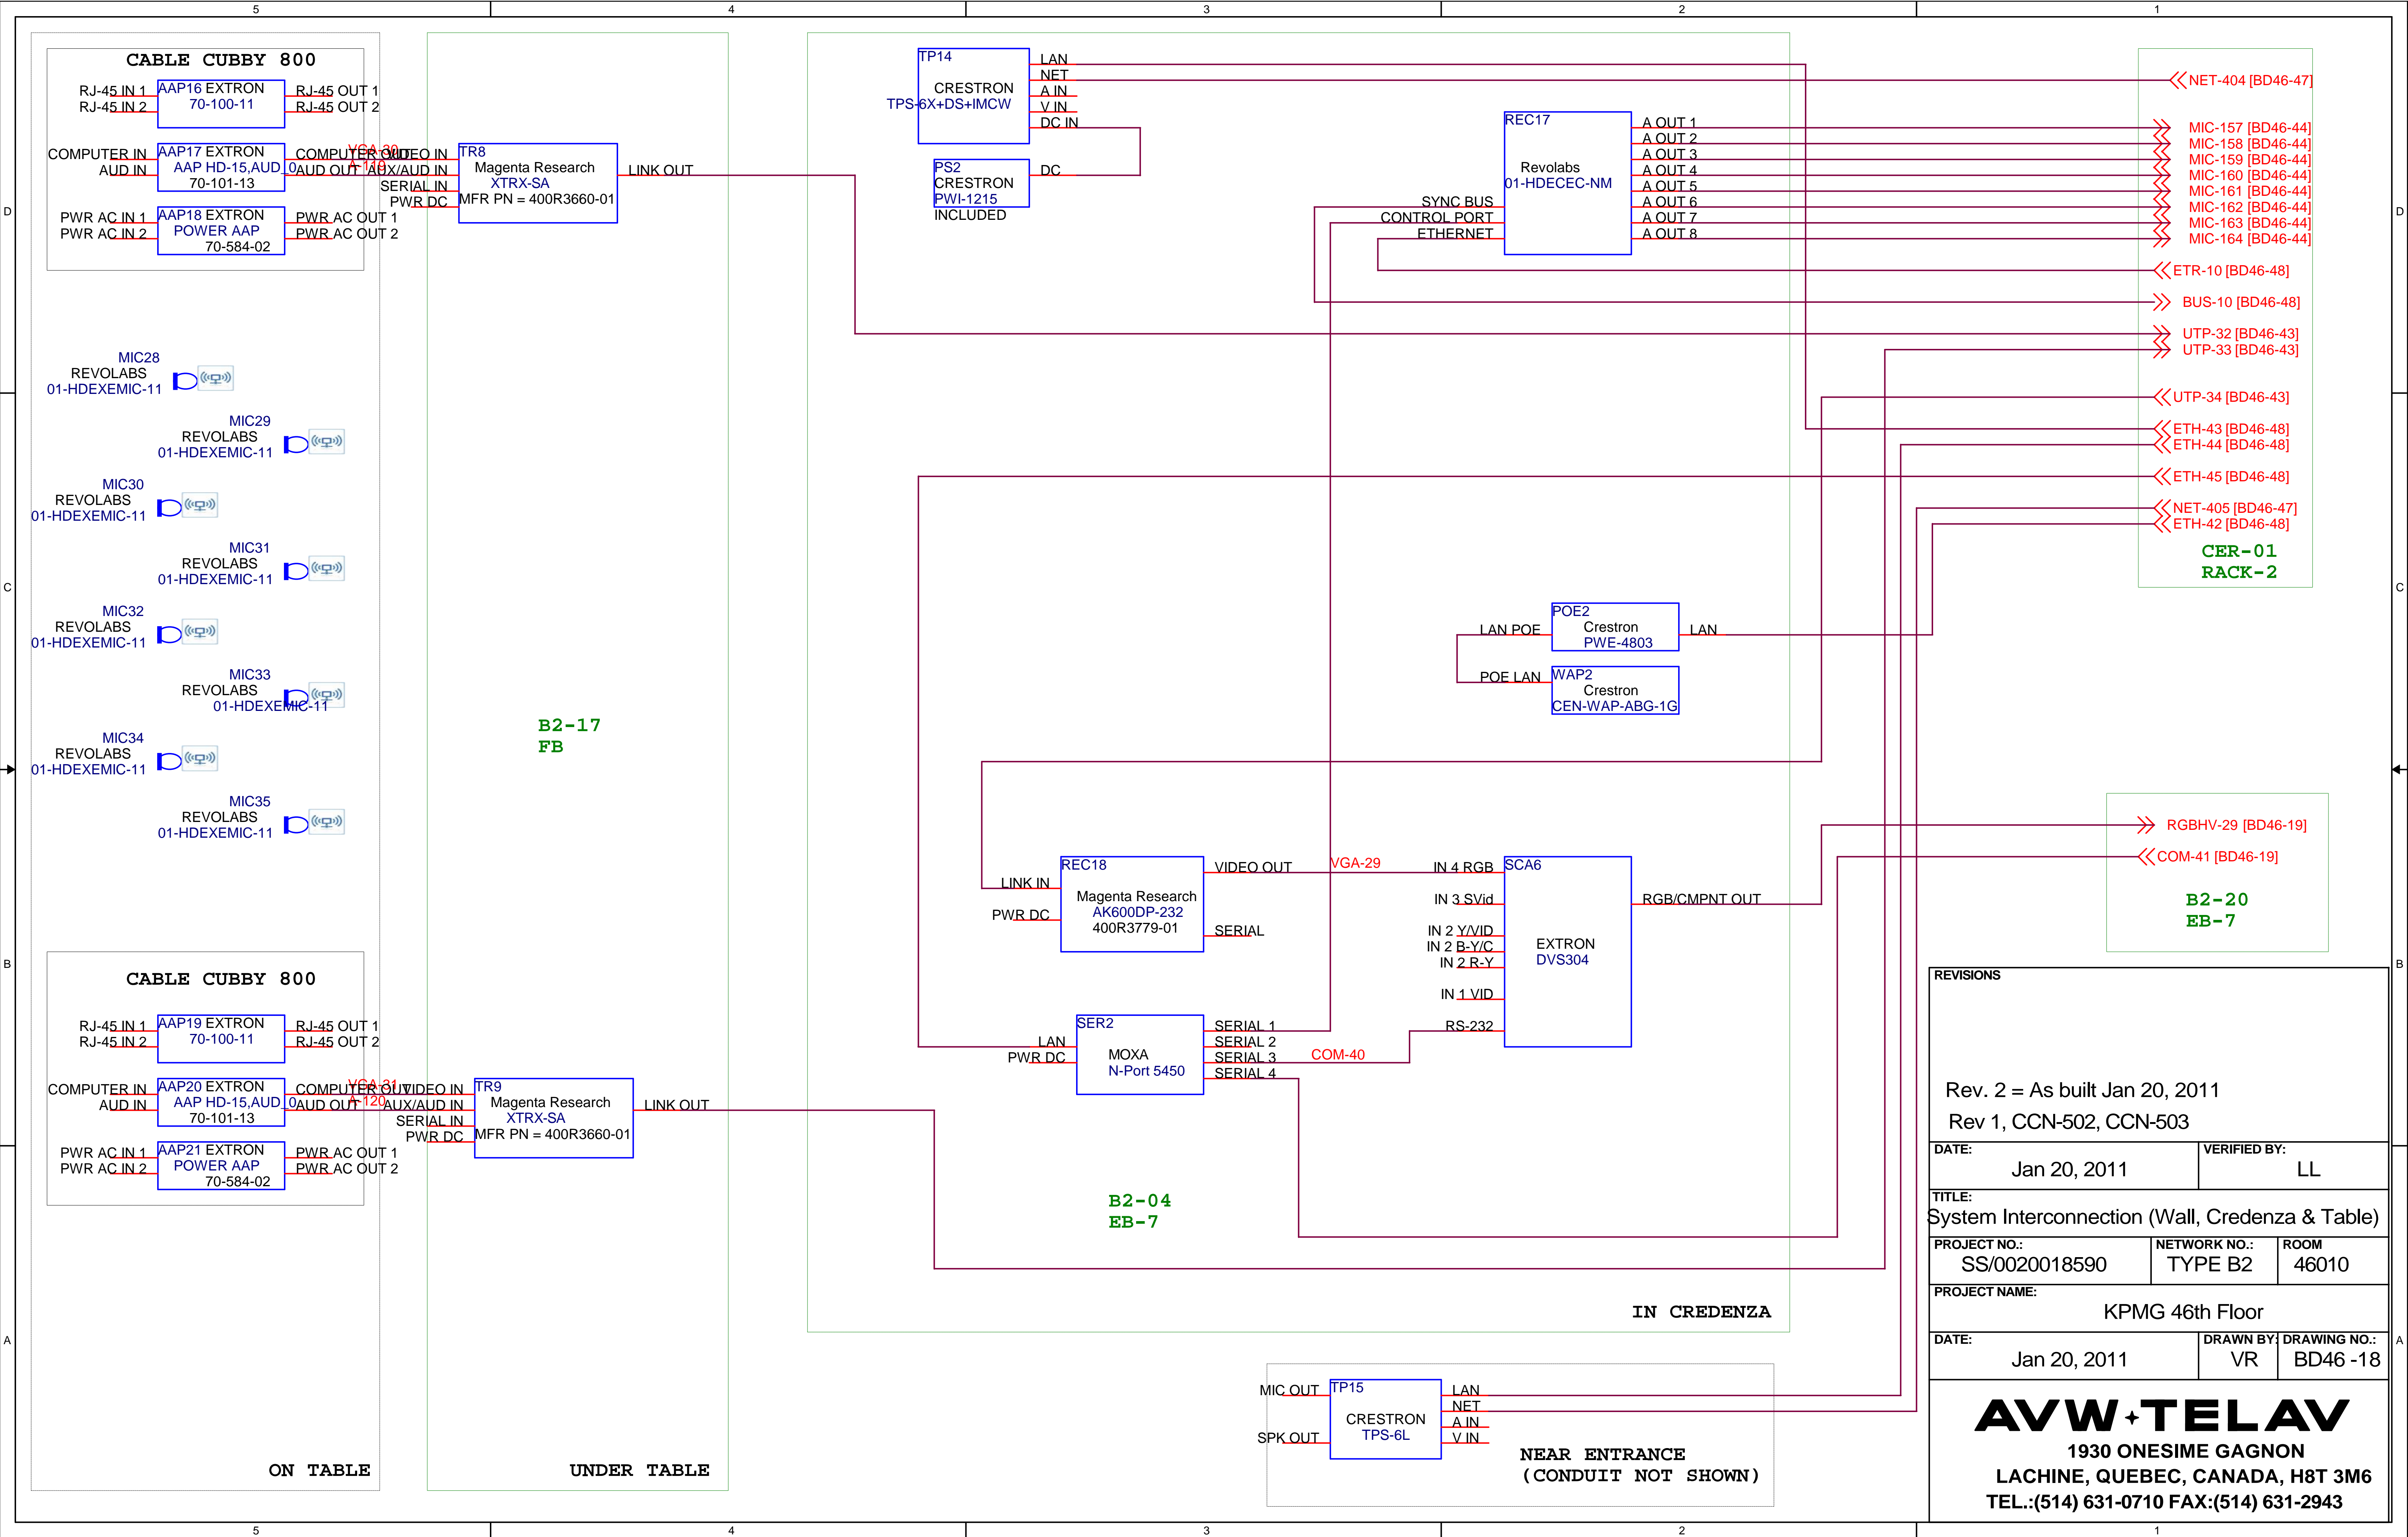
| | | |
|---|---------------------|---------------------|
| <p>REVISIONS</p> <p>Rev. 2 = As built Jan 20, 2011</p> <p>Rev 1, CCN-502, CCN-503</p> | | |
| DATE: | | VERIFIED BY: |
| Jan 20, 2011 | | LL |
| TITLE: | | |
| System Interconnection (Ceiling) | | |
| PROJECT NO.: | NETWORK NO.: | ROOM |
| SS/0020018590 | TYPE B2 | 46011 |
| PROJECT NAME: | | |
| KPMG 46th Floor | | |
| DATE: | | DRAWN BY: |
| Jan 20, 2011 | | VR |
| | | DRAWING NO.: |
| | | BD46 - 17 |




1930 ONESIME GAGNON


LACHINE, QUEBEC, CANADA, H8T 3M6


TEL.: (514) 631-0710 FAX: (514) 631-2943




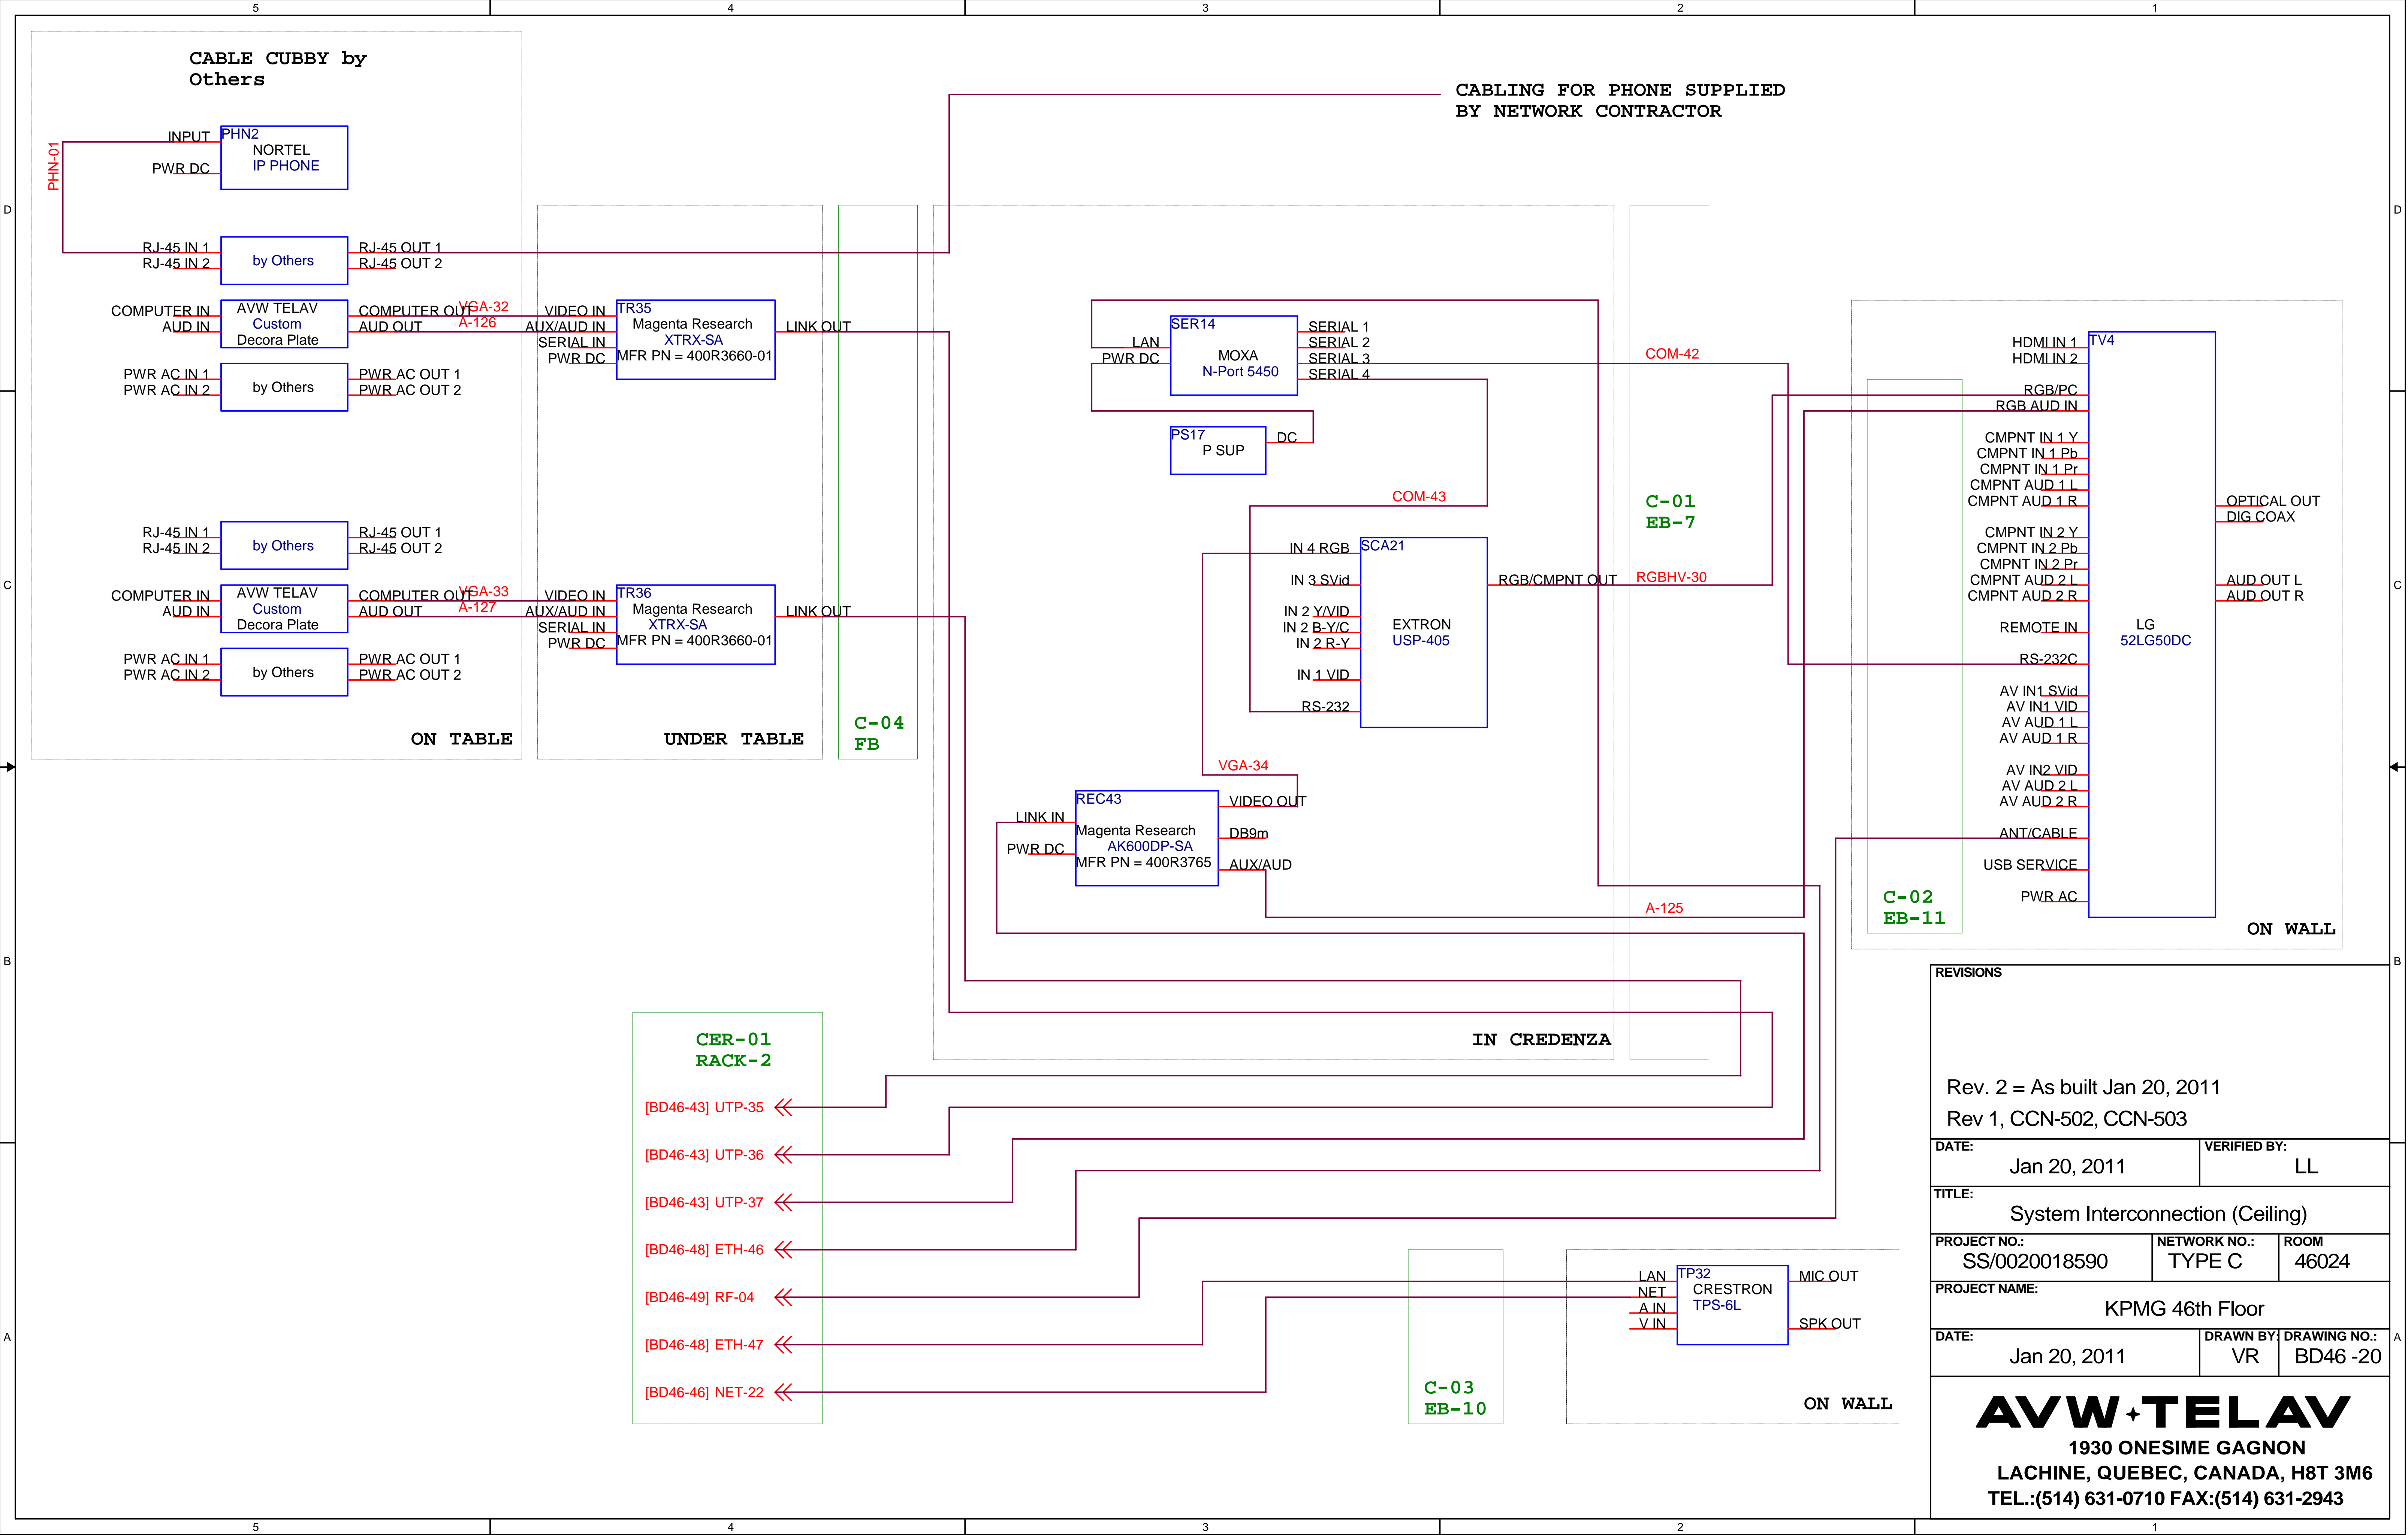



| REVISIONS | | |
|--|--------------|------------------------|
| Rev. 2 = As built Jan 20, 2011 | | |
| Rev 1, CCN-502, CCN-503 | | |
| DATE: | | VERIFIED BY: |
| Jan 20, 2011 | | LL |
| TITLE: | | |
| System Interconnection (Ceiling) | | |
| PROJECT NO.: | NETWORK NO.: | ROOM |
| SS/0020018590 | TYPE C | 46024 |
| PROJECT NAME: | | |
| KPMG 46th Floor | | |
| DATE: | | DRAWN BY: DRAWING NO.: |
| Jan 20, 2011 | | VR BD46 -20 |
| AVW+TELAV | | |
| 1930 ONESIME GAGNON | | |
| LACHINE, QUEBEC, CANADA, H8T 3M6 | | |
| TEL.:(514) 631-0710 FAX:(514) 631-2943 | | |

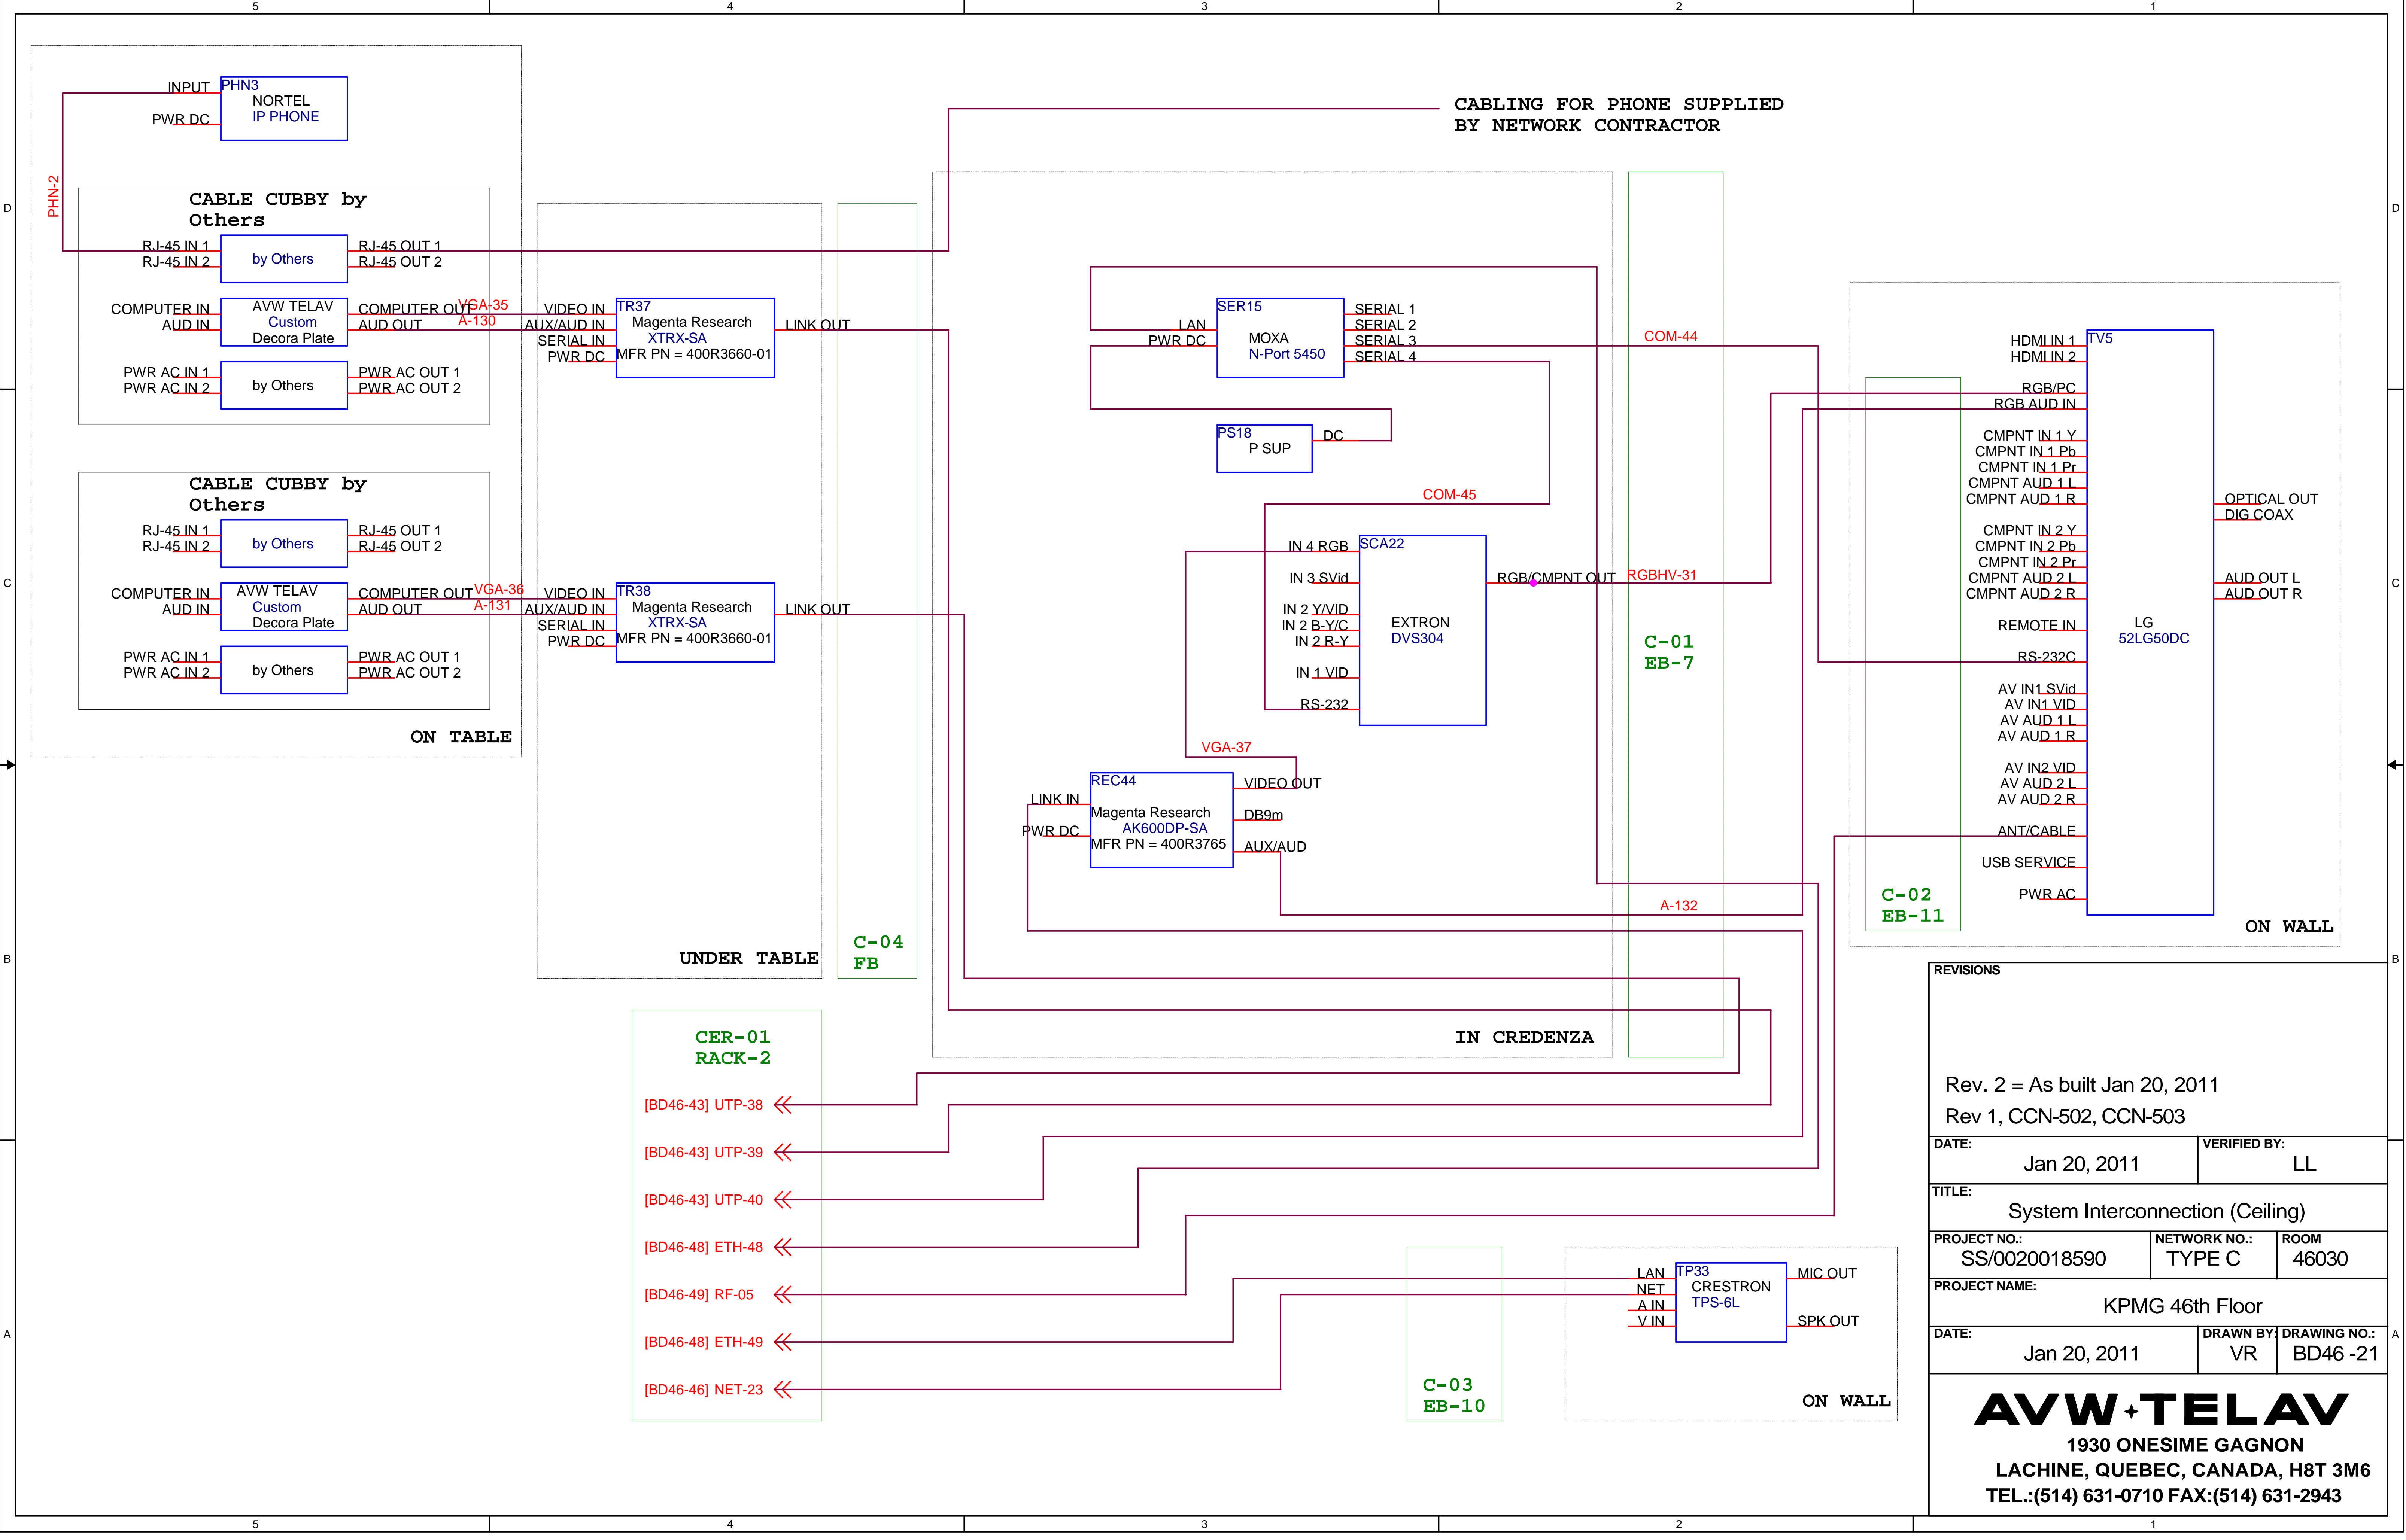

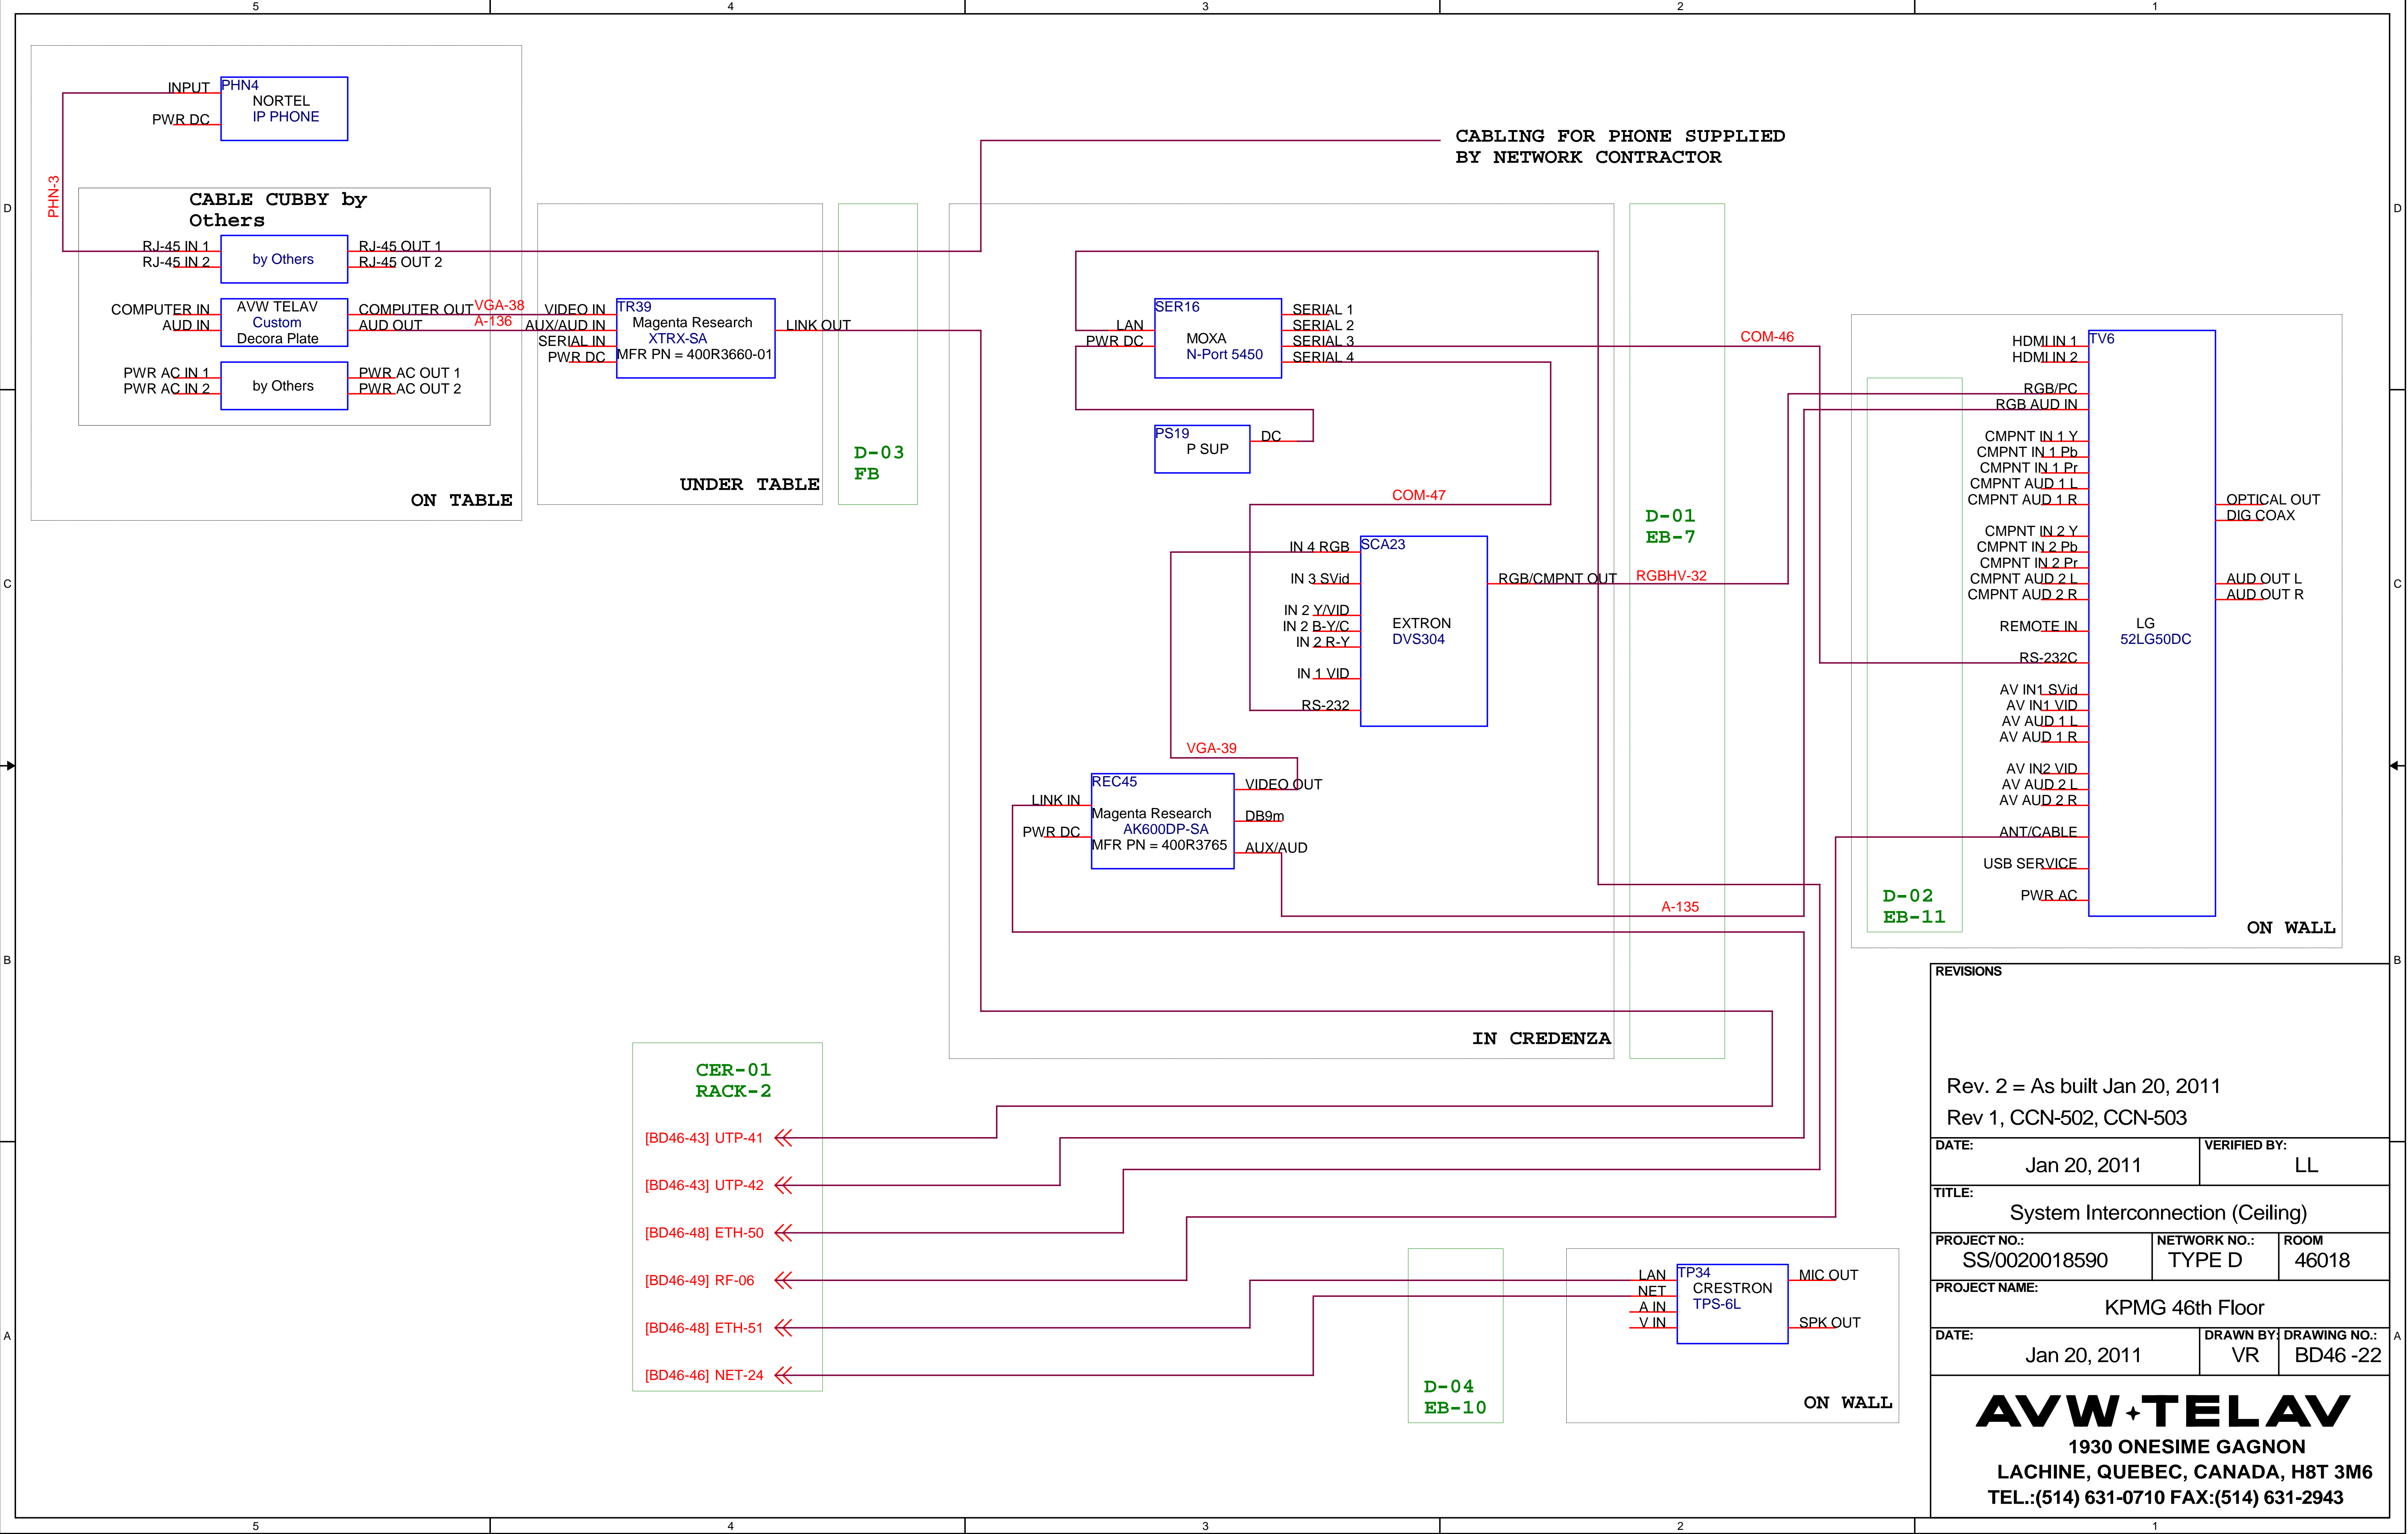

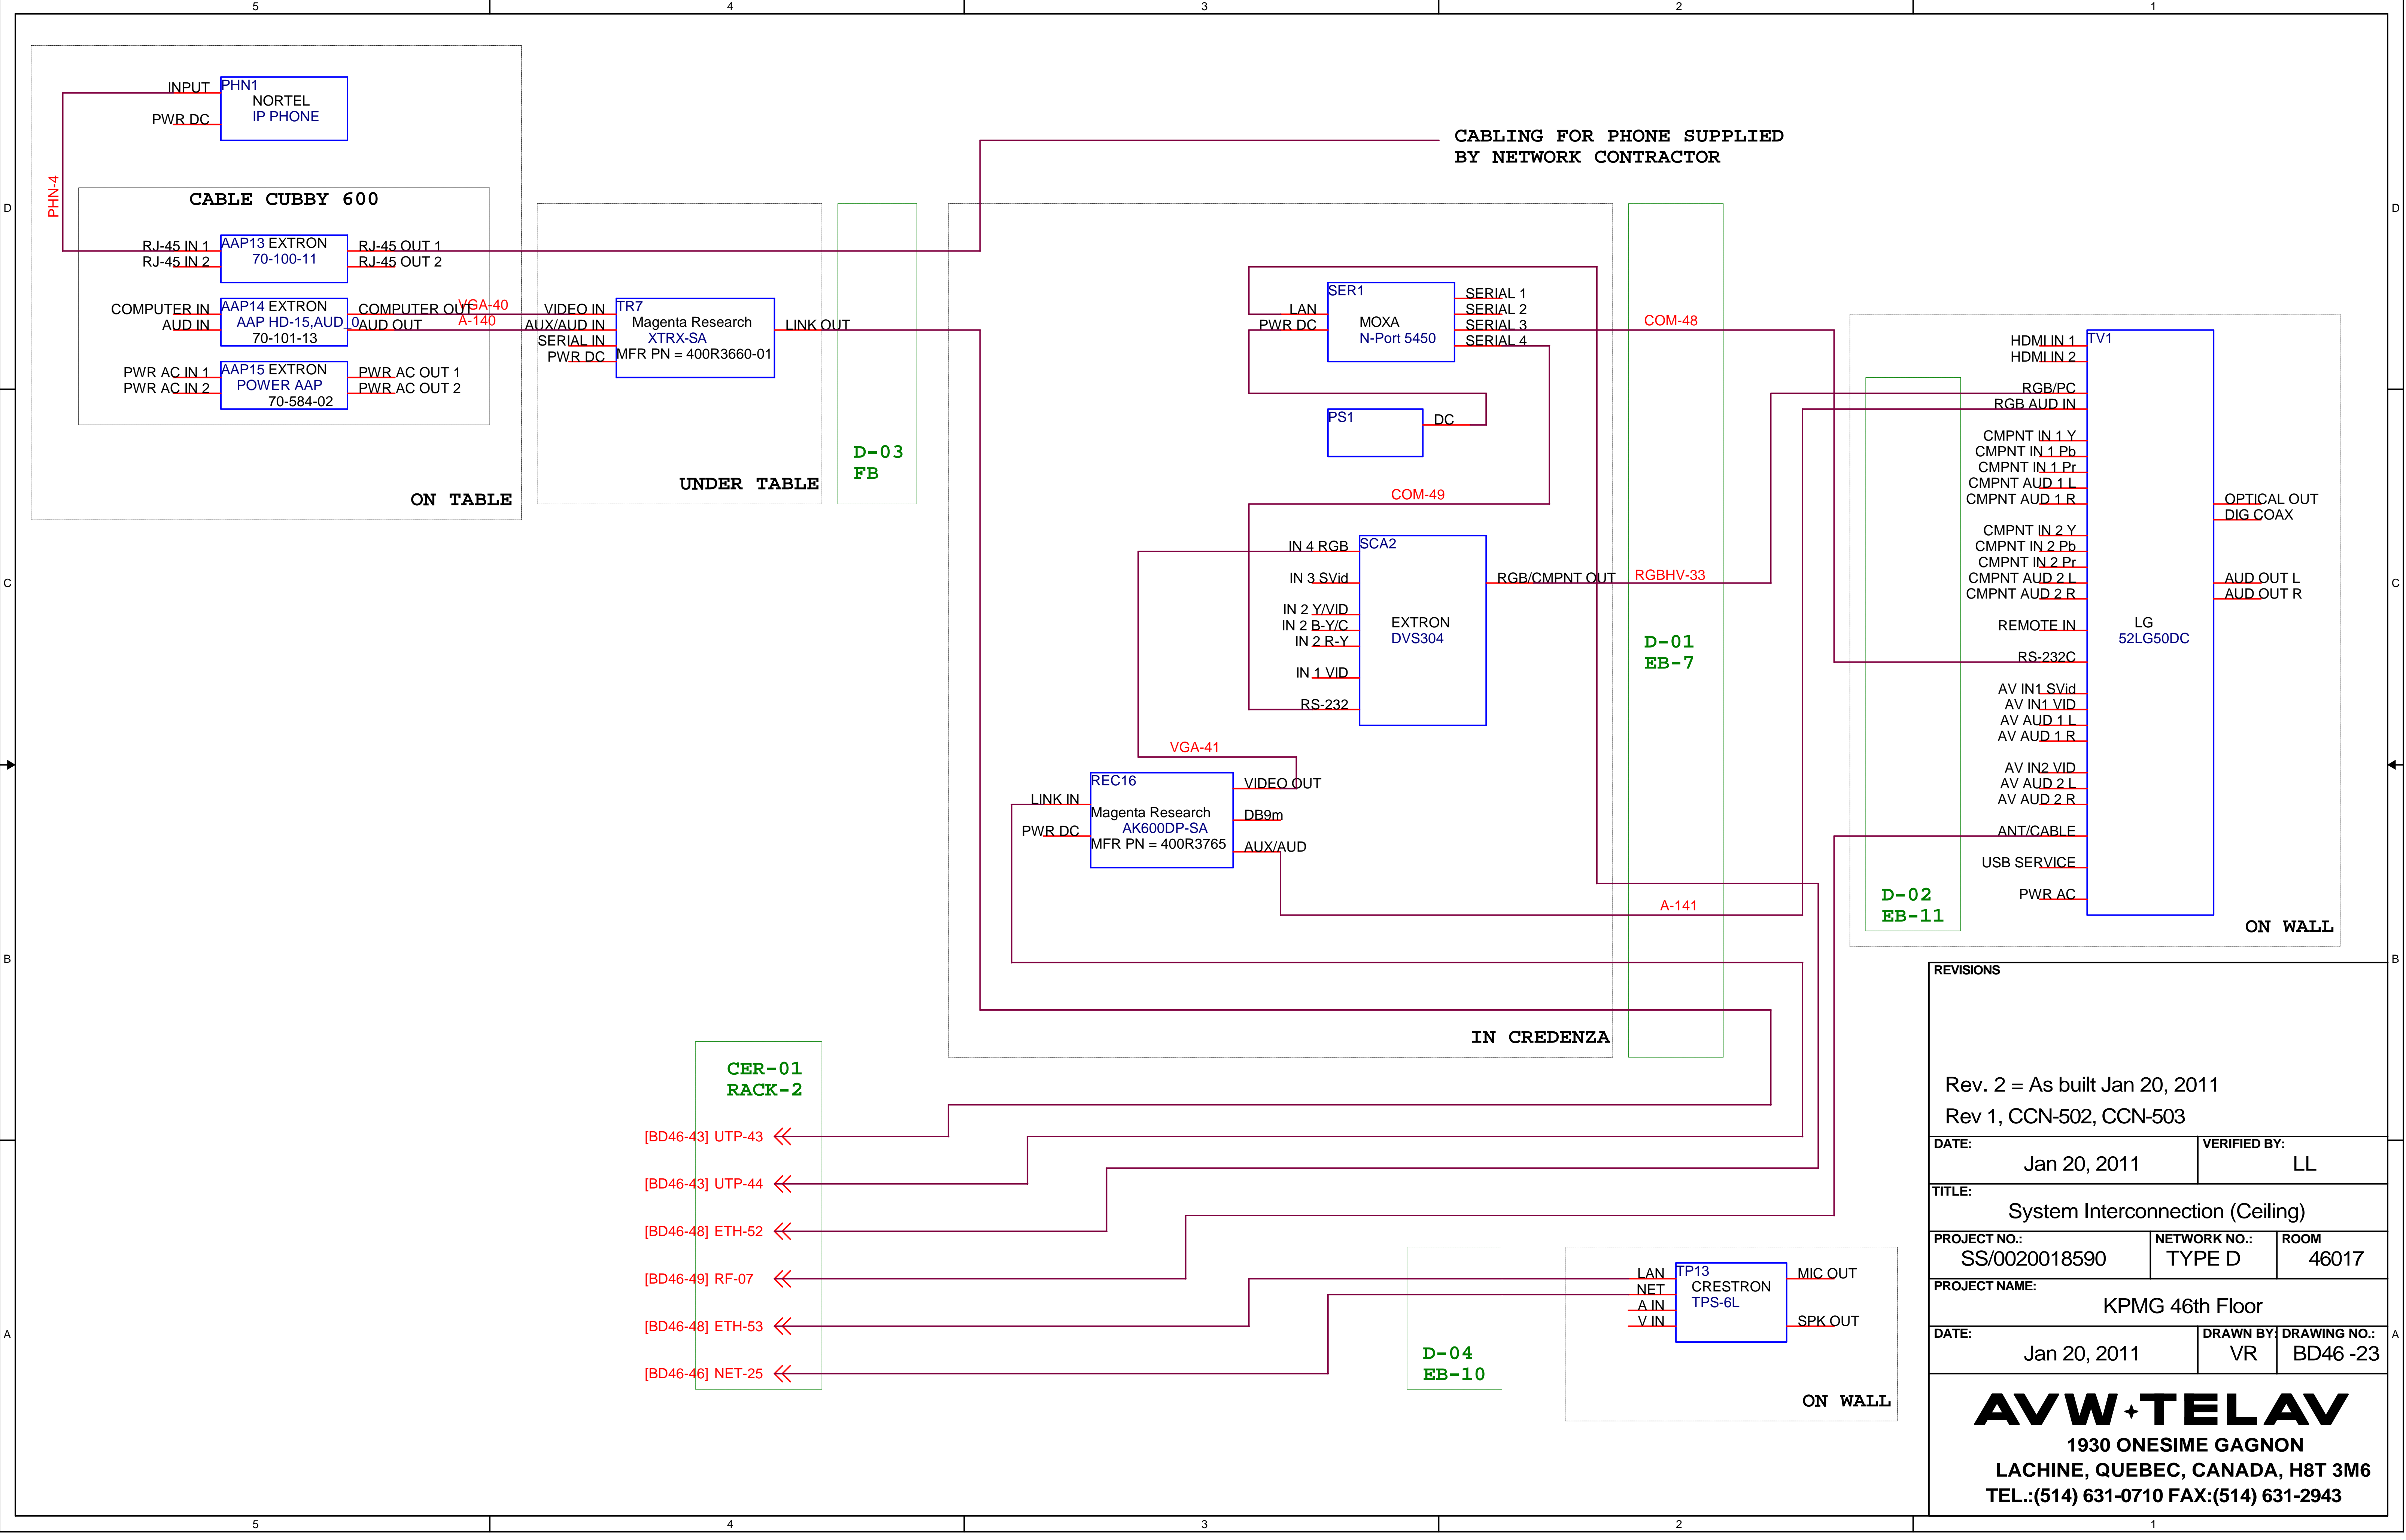

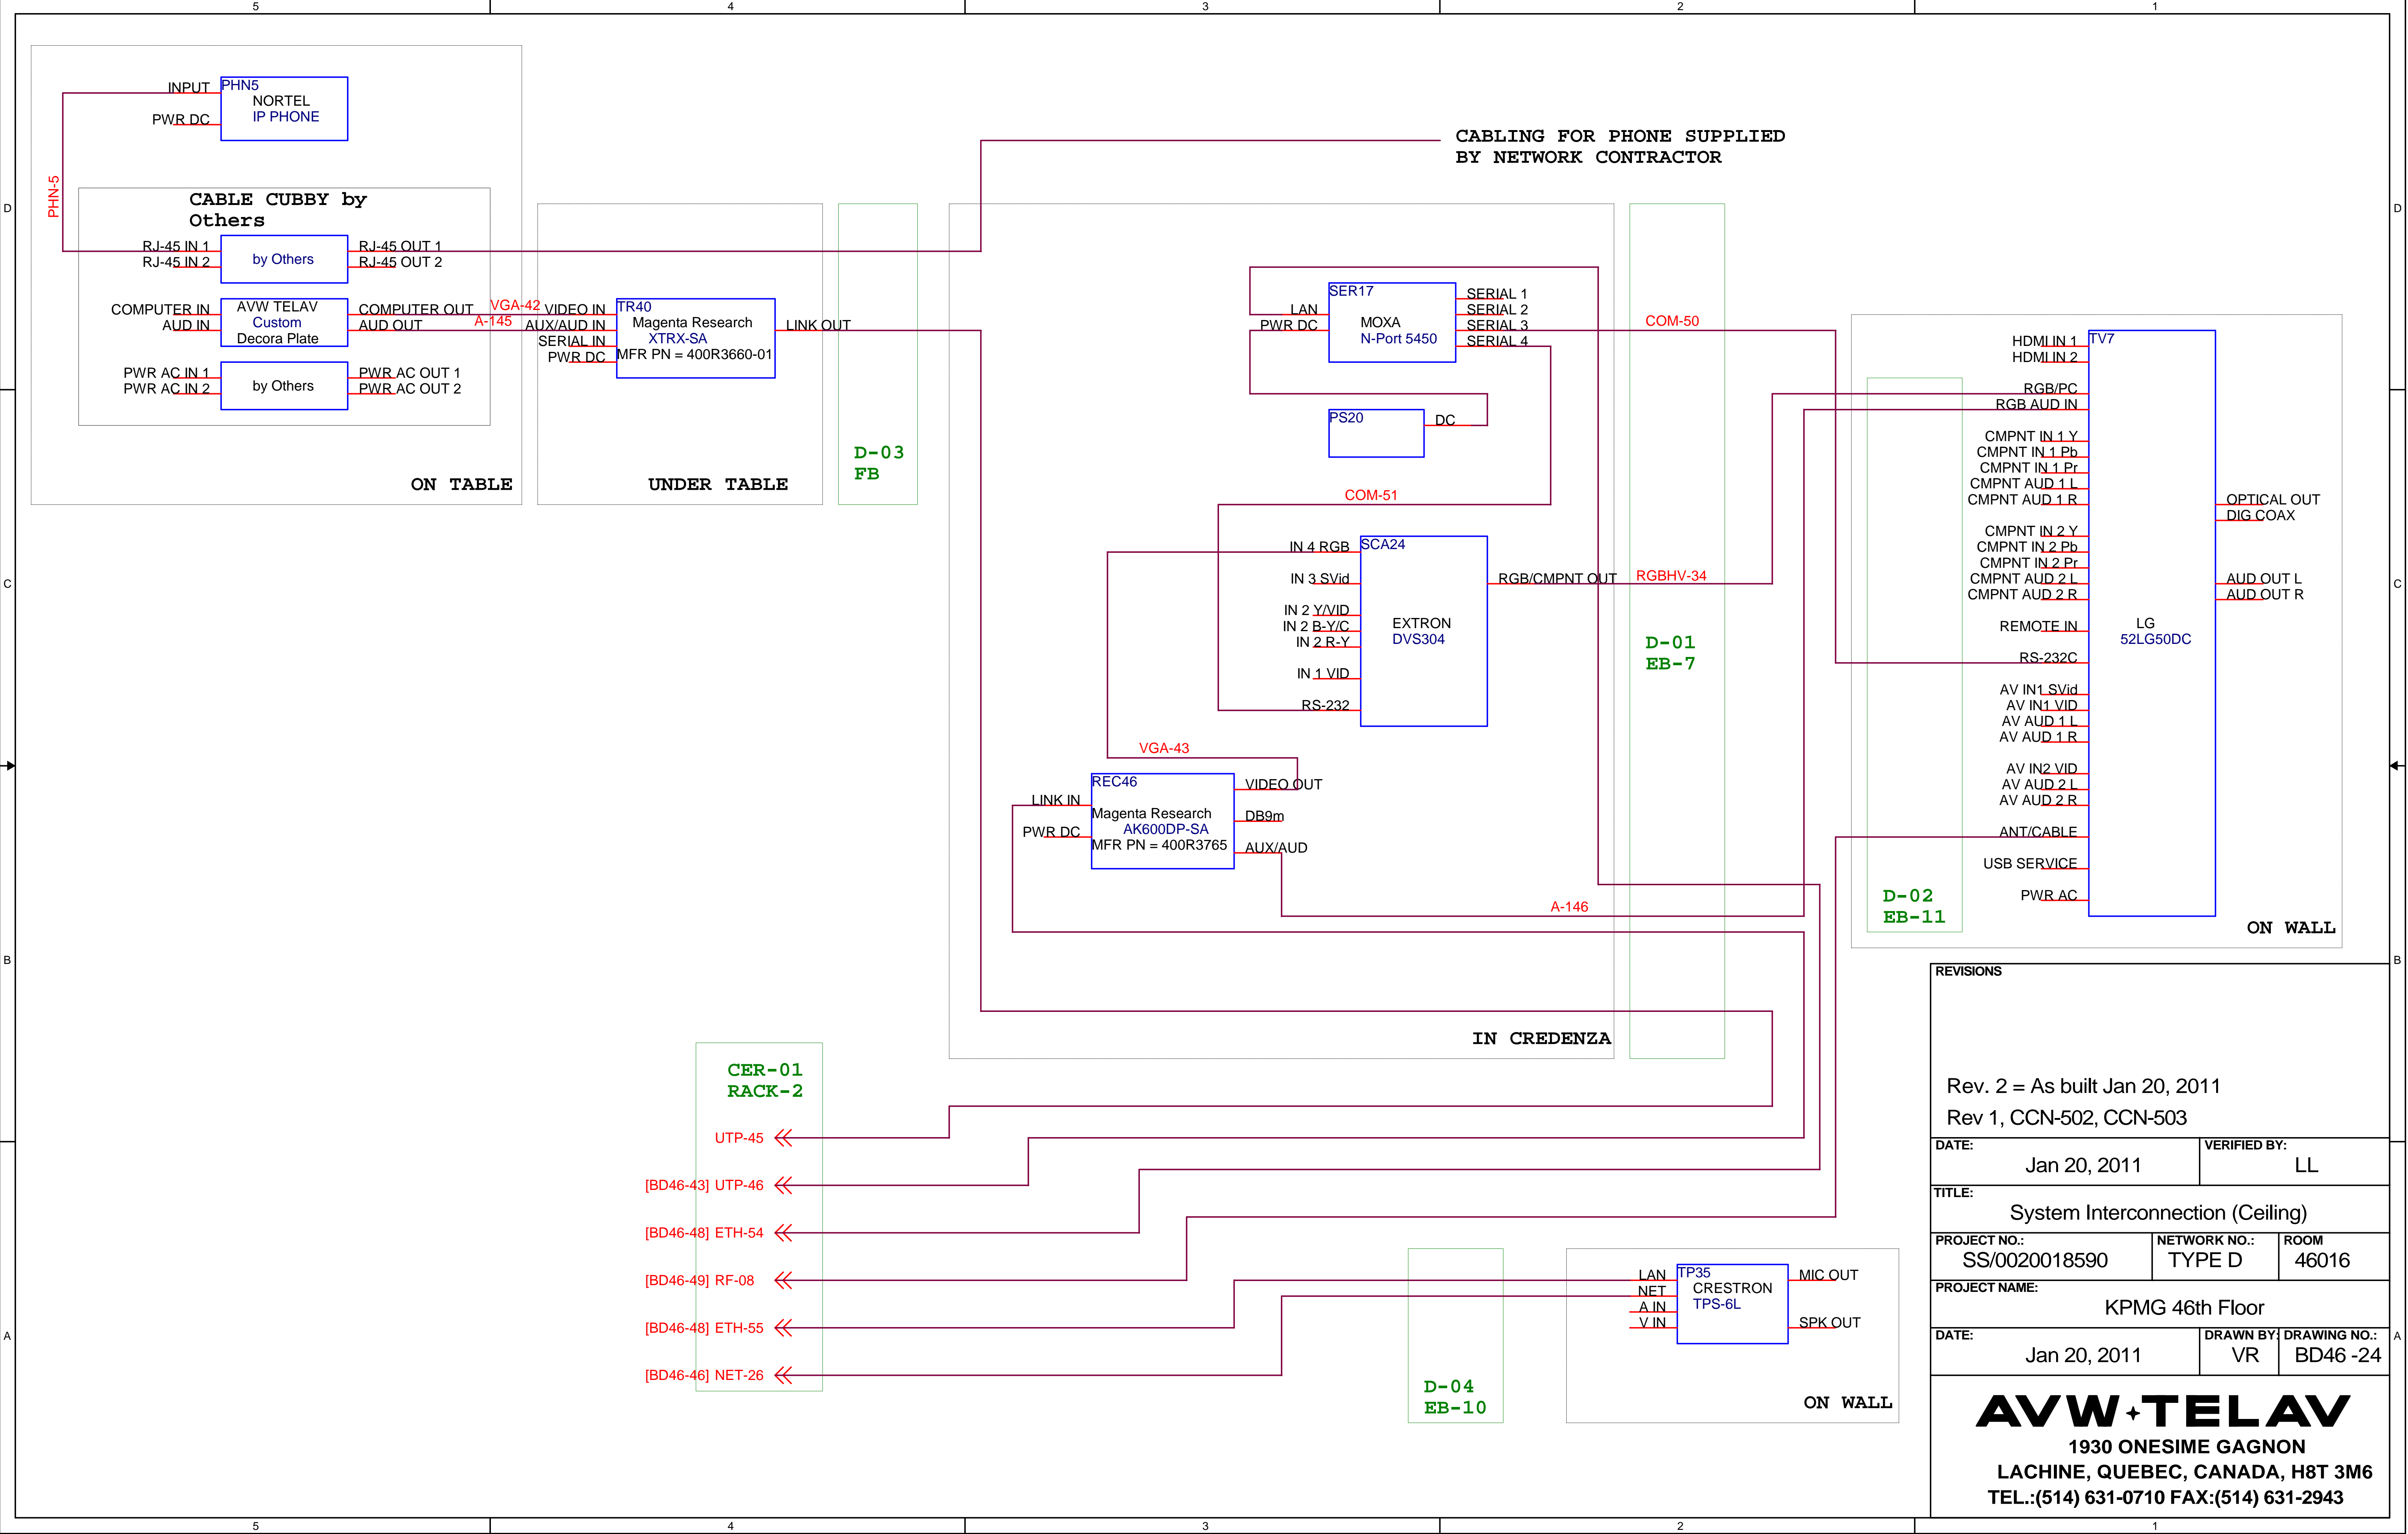

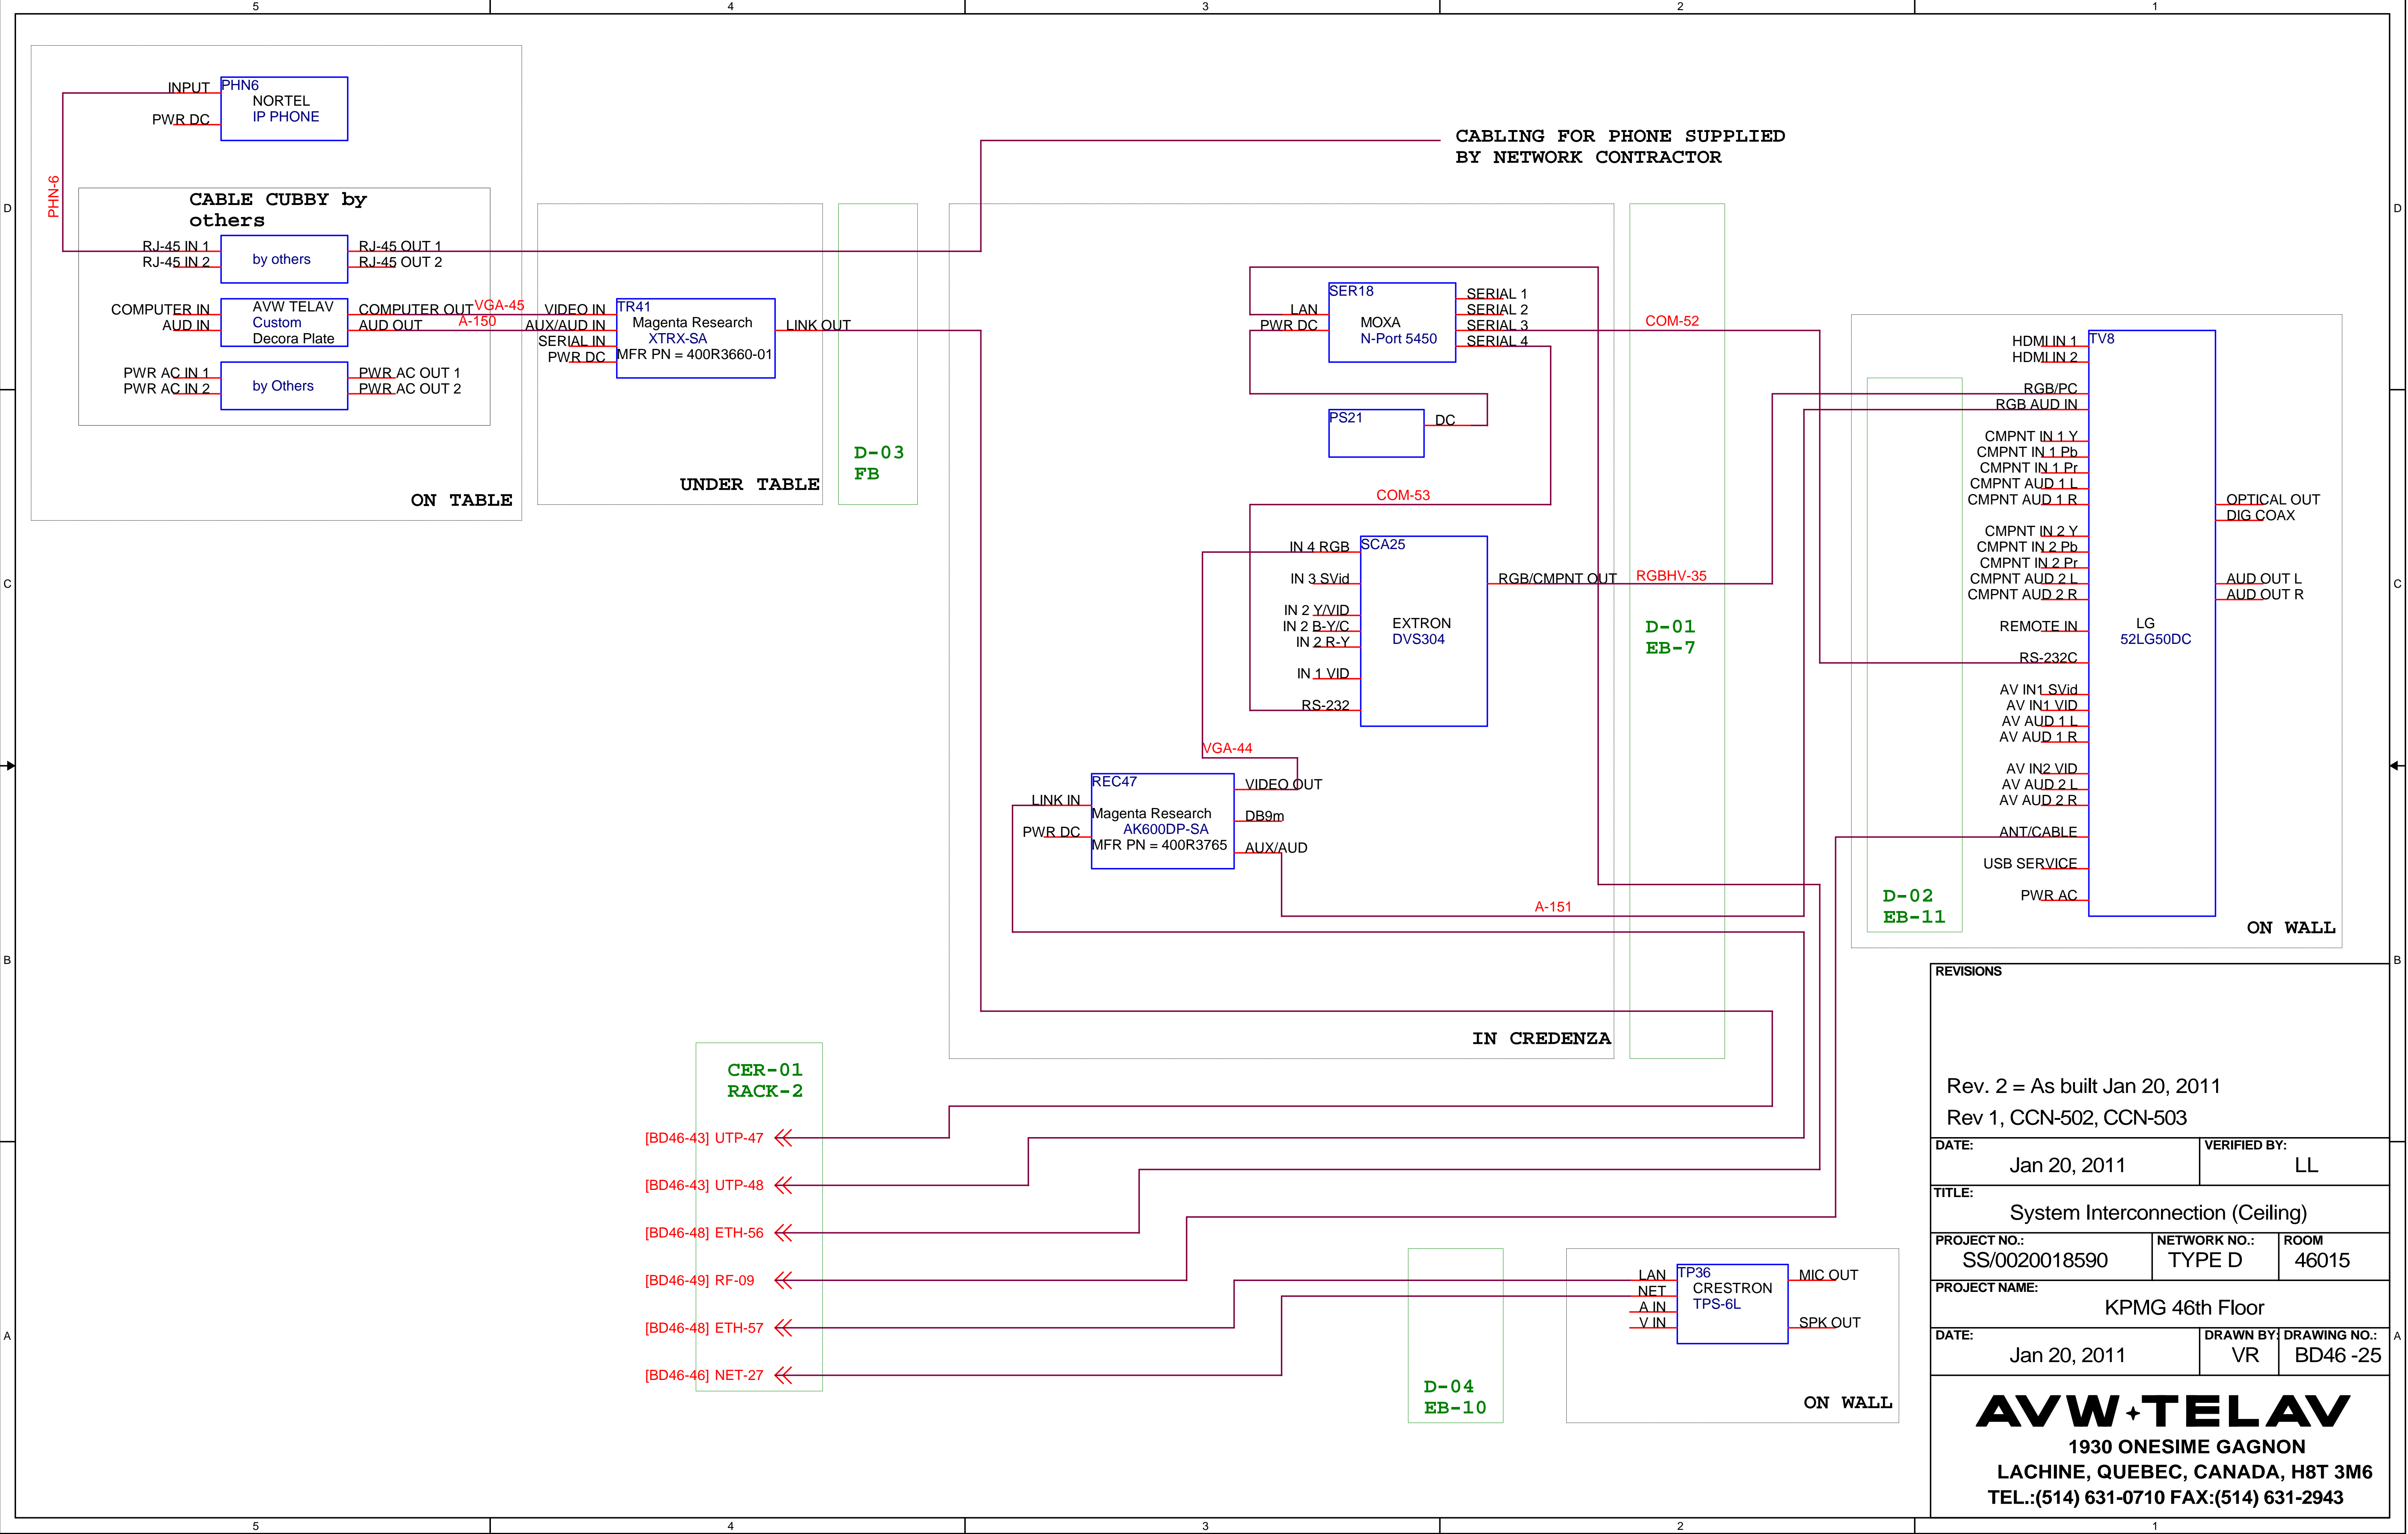

REVISIONS

Rev. 2 = As built Jan 20, 2011
Rev 1, CCN-502, CCN-503

DATE:Jan 20, 2011

VERIFIED BY:LL

TITLE:
System Interconnection (Ceiling)

PROJECT NO.:SS/0020018590

NETWORK NO.:TYPE D

ROOM46015

PROJECT NAME:
KPMG 46th Floor


DATE:Jan 20, 2011

DRAWN BY:VR

DRAWING NO.:BD46 -25

AVW+TELAV

1930 ONESIME GAGNON
LACHINE, QUEBEC, CANADA, H8T 3M6
TEL.:(514) 631-0710 FAX:(514) 631-2943

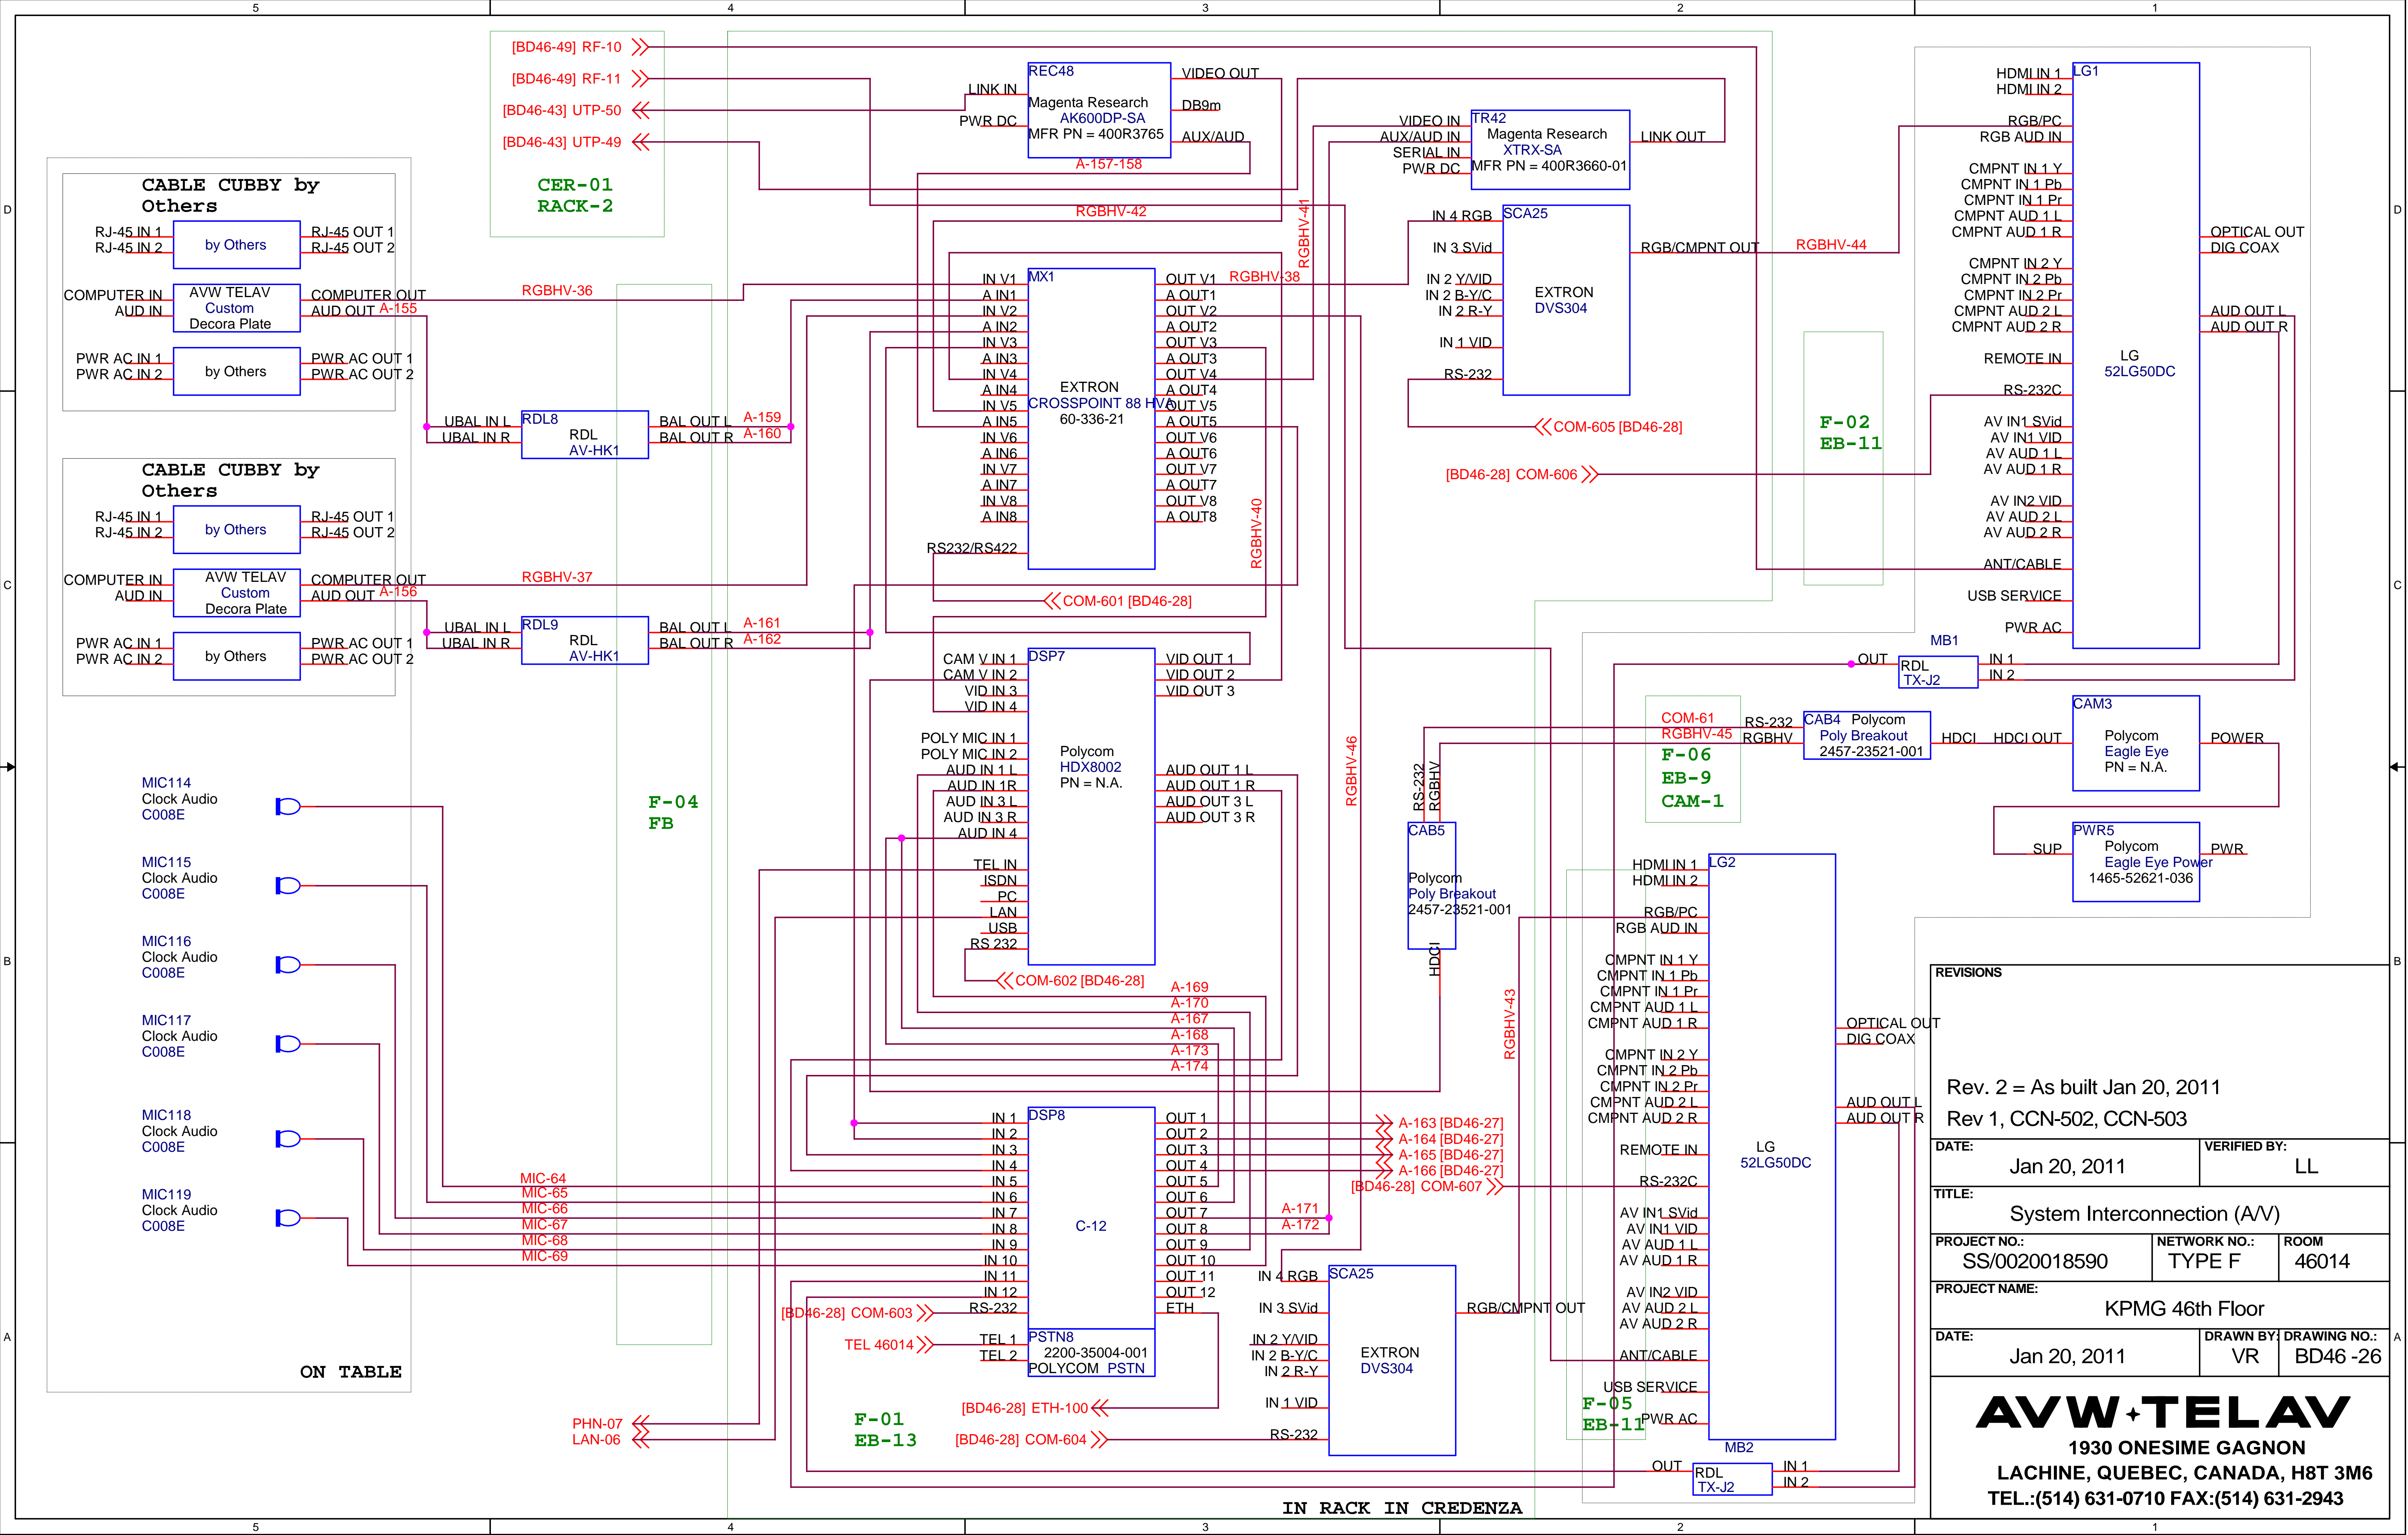


REVISIONS

Rev. 2 = As built Jan 20, 2011
Rev 1, CCN-502, CCN-503


| | | | |
|--|---------------|-----------------|----------|
| DATE: | Jan 20, 2011 | VERIFIED BY: | LL |
| TITLE: System Interconnection (A/V) | | | |
| PROJECT NO.: | SS/0020018590 | NETWORK NO.: | TYPE F |
| PROJECT NAME: | | KPMG 46th Floor | |
| DATE: | Jan 20, 2011 | DRAWN BY: | VR |
| | | DRAWING NO.: | BD46 -26 |

AVW+TELAV





1930 ONESIME GAGNON
LACHINE, QUEBEC, CANADA, H8T 3M6
TEL.:(514) 631-0710 FAX:(514) 631-2943

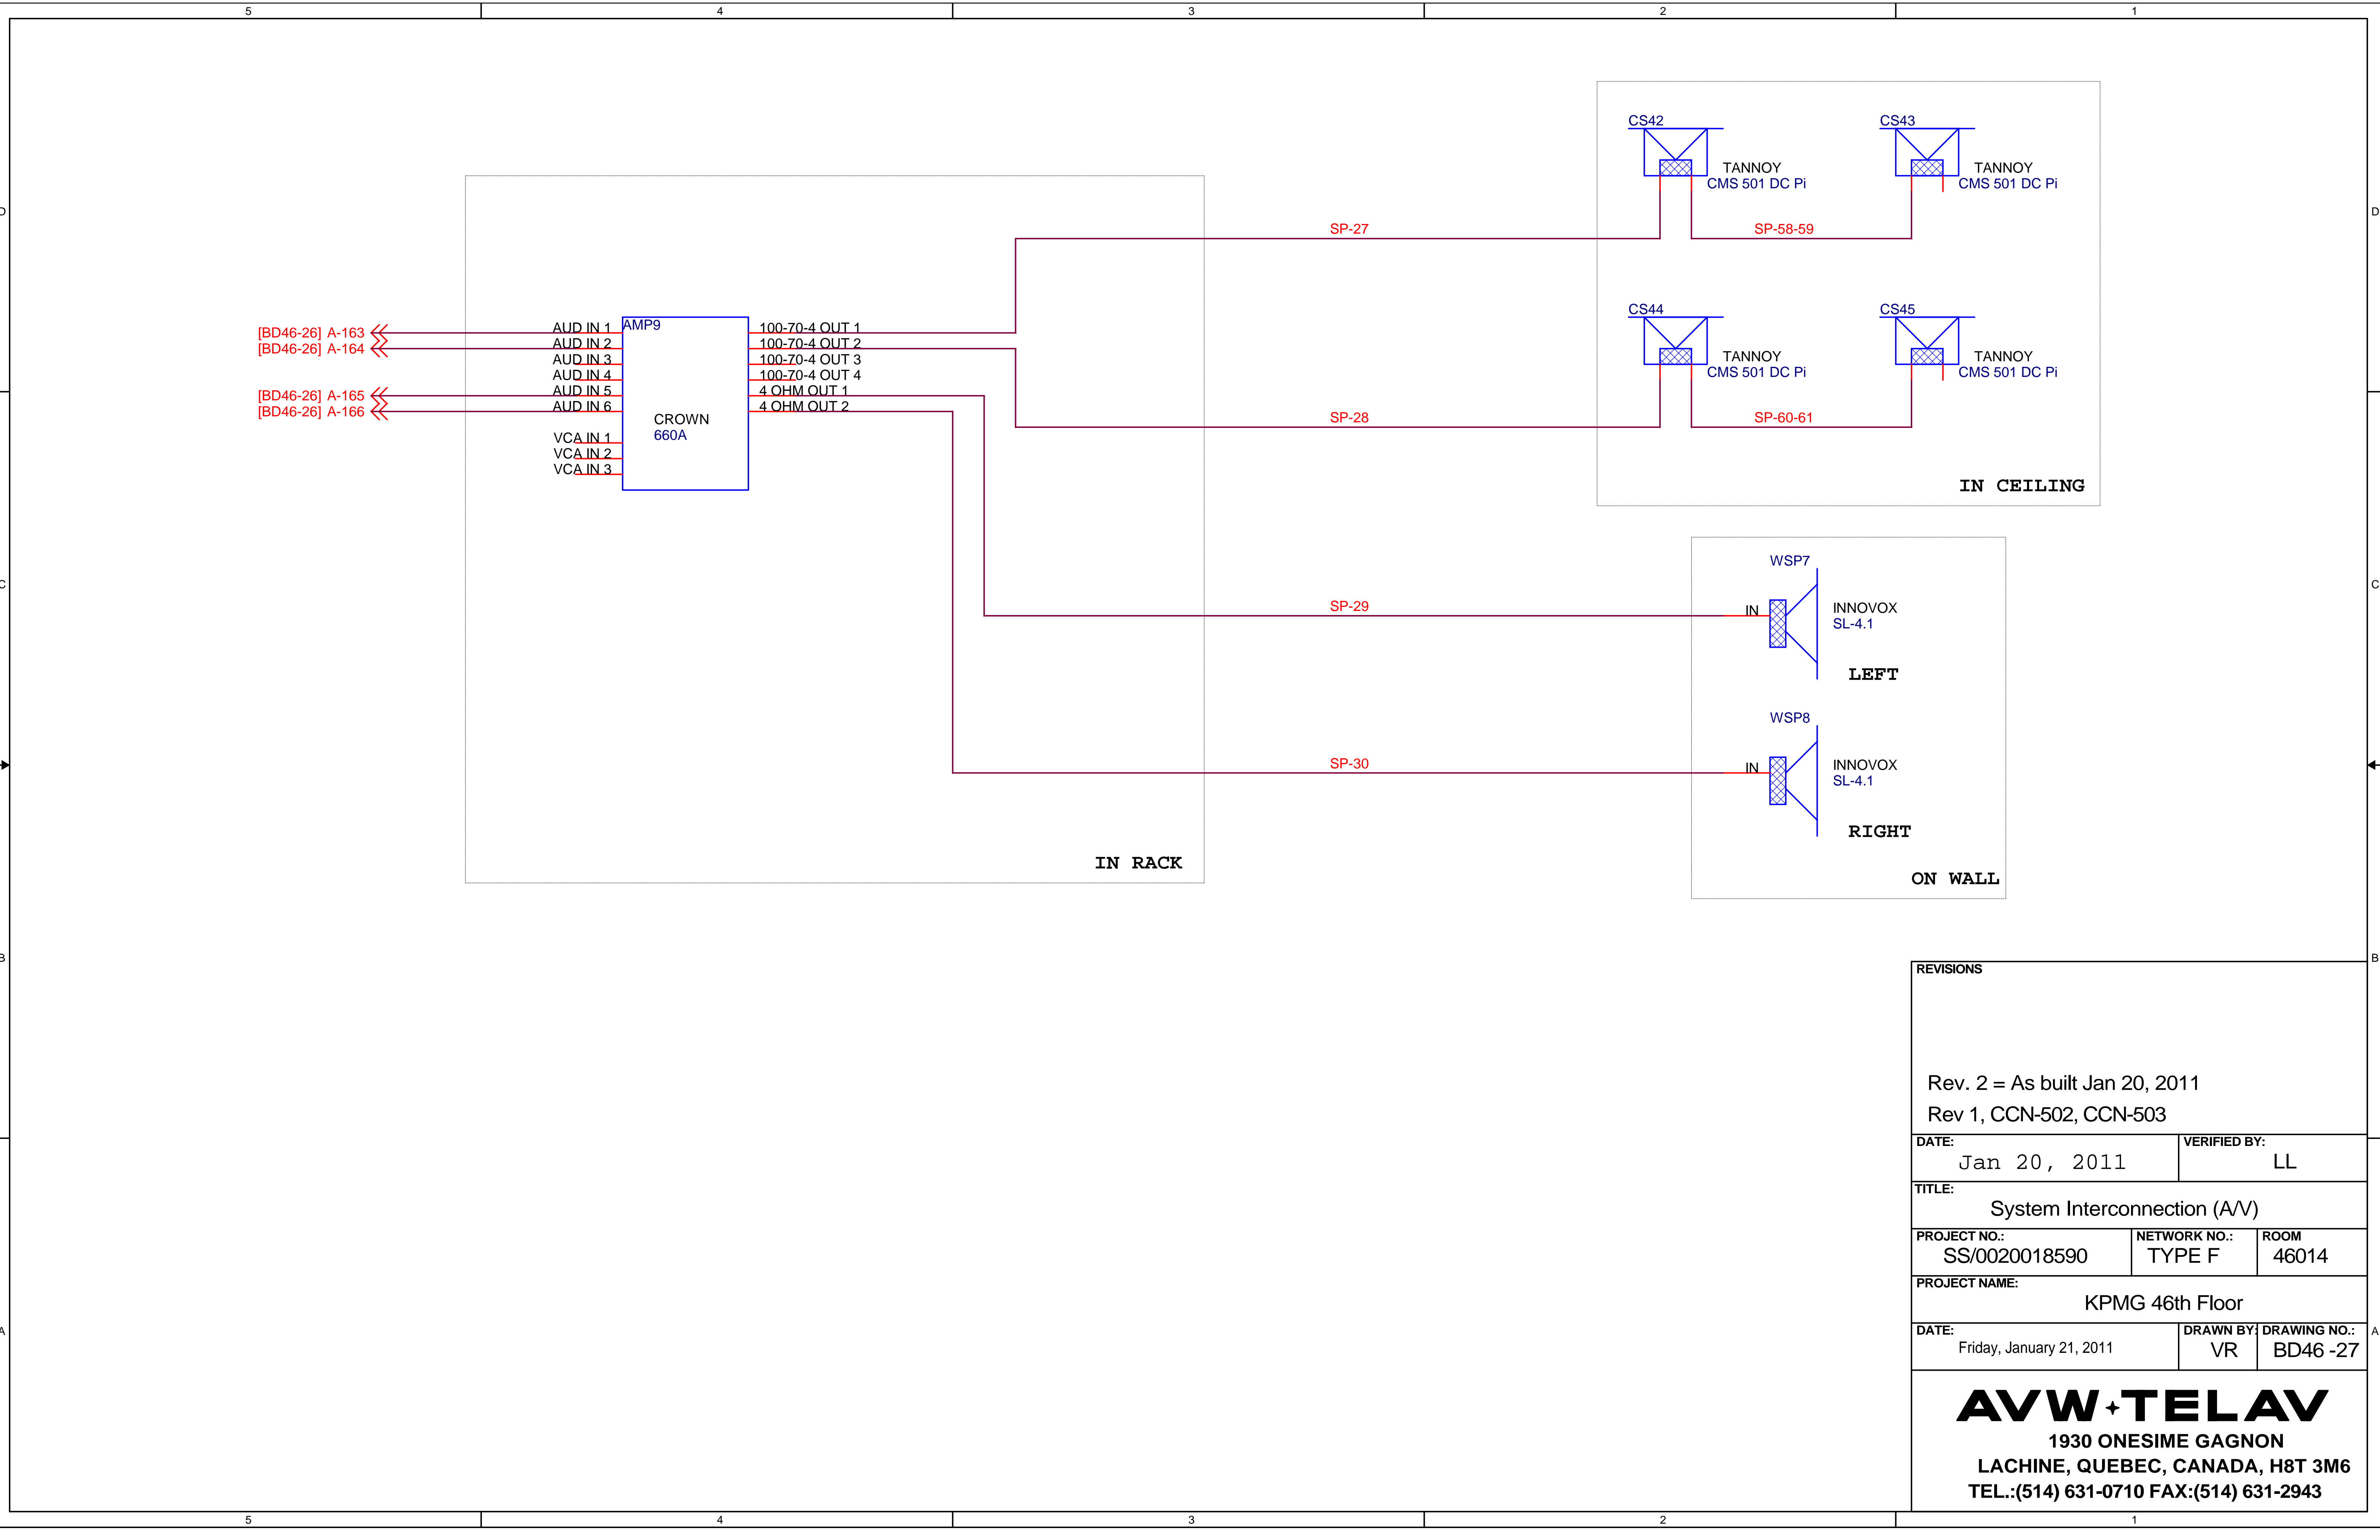



| REVISIONS | | |
|---|------------------------|--------------------------|
| Rev. 2 = As built Jan 20, 2011 Rev 1, CCN-502, CCN-503 | | |
| DATE: Jan 20, 2011 | | VERIFIED BY: LL |
| TITLE: System Interconnection (A/V) | | |
| PROJECT NO.: SS/0020018590 | NETWORK NO.: TYPE F | ROOM 46014 |
| PROJECT NAME: KPMG 46th Floor | | |
| DATE: Friday, January 21, 2011 | | DRAWN BY: VR |
| | | DRAWING NO.: BD46 -27 |
| AVW+TELAV 1930 ONESIME GAGNON LACHINE, QUEBEC, CANADA, H8T 3M6 TEL.:(514) 631-0710 FAX:(514) 631-2943 | | |

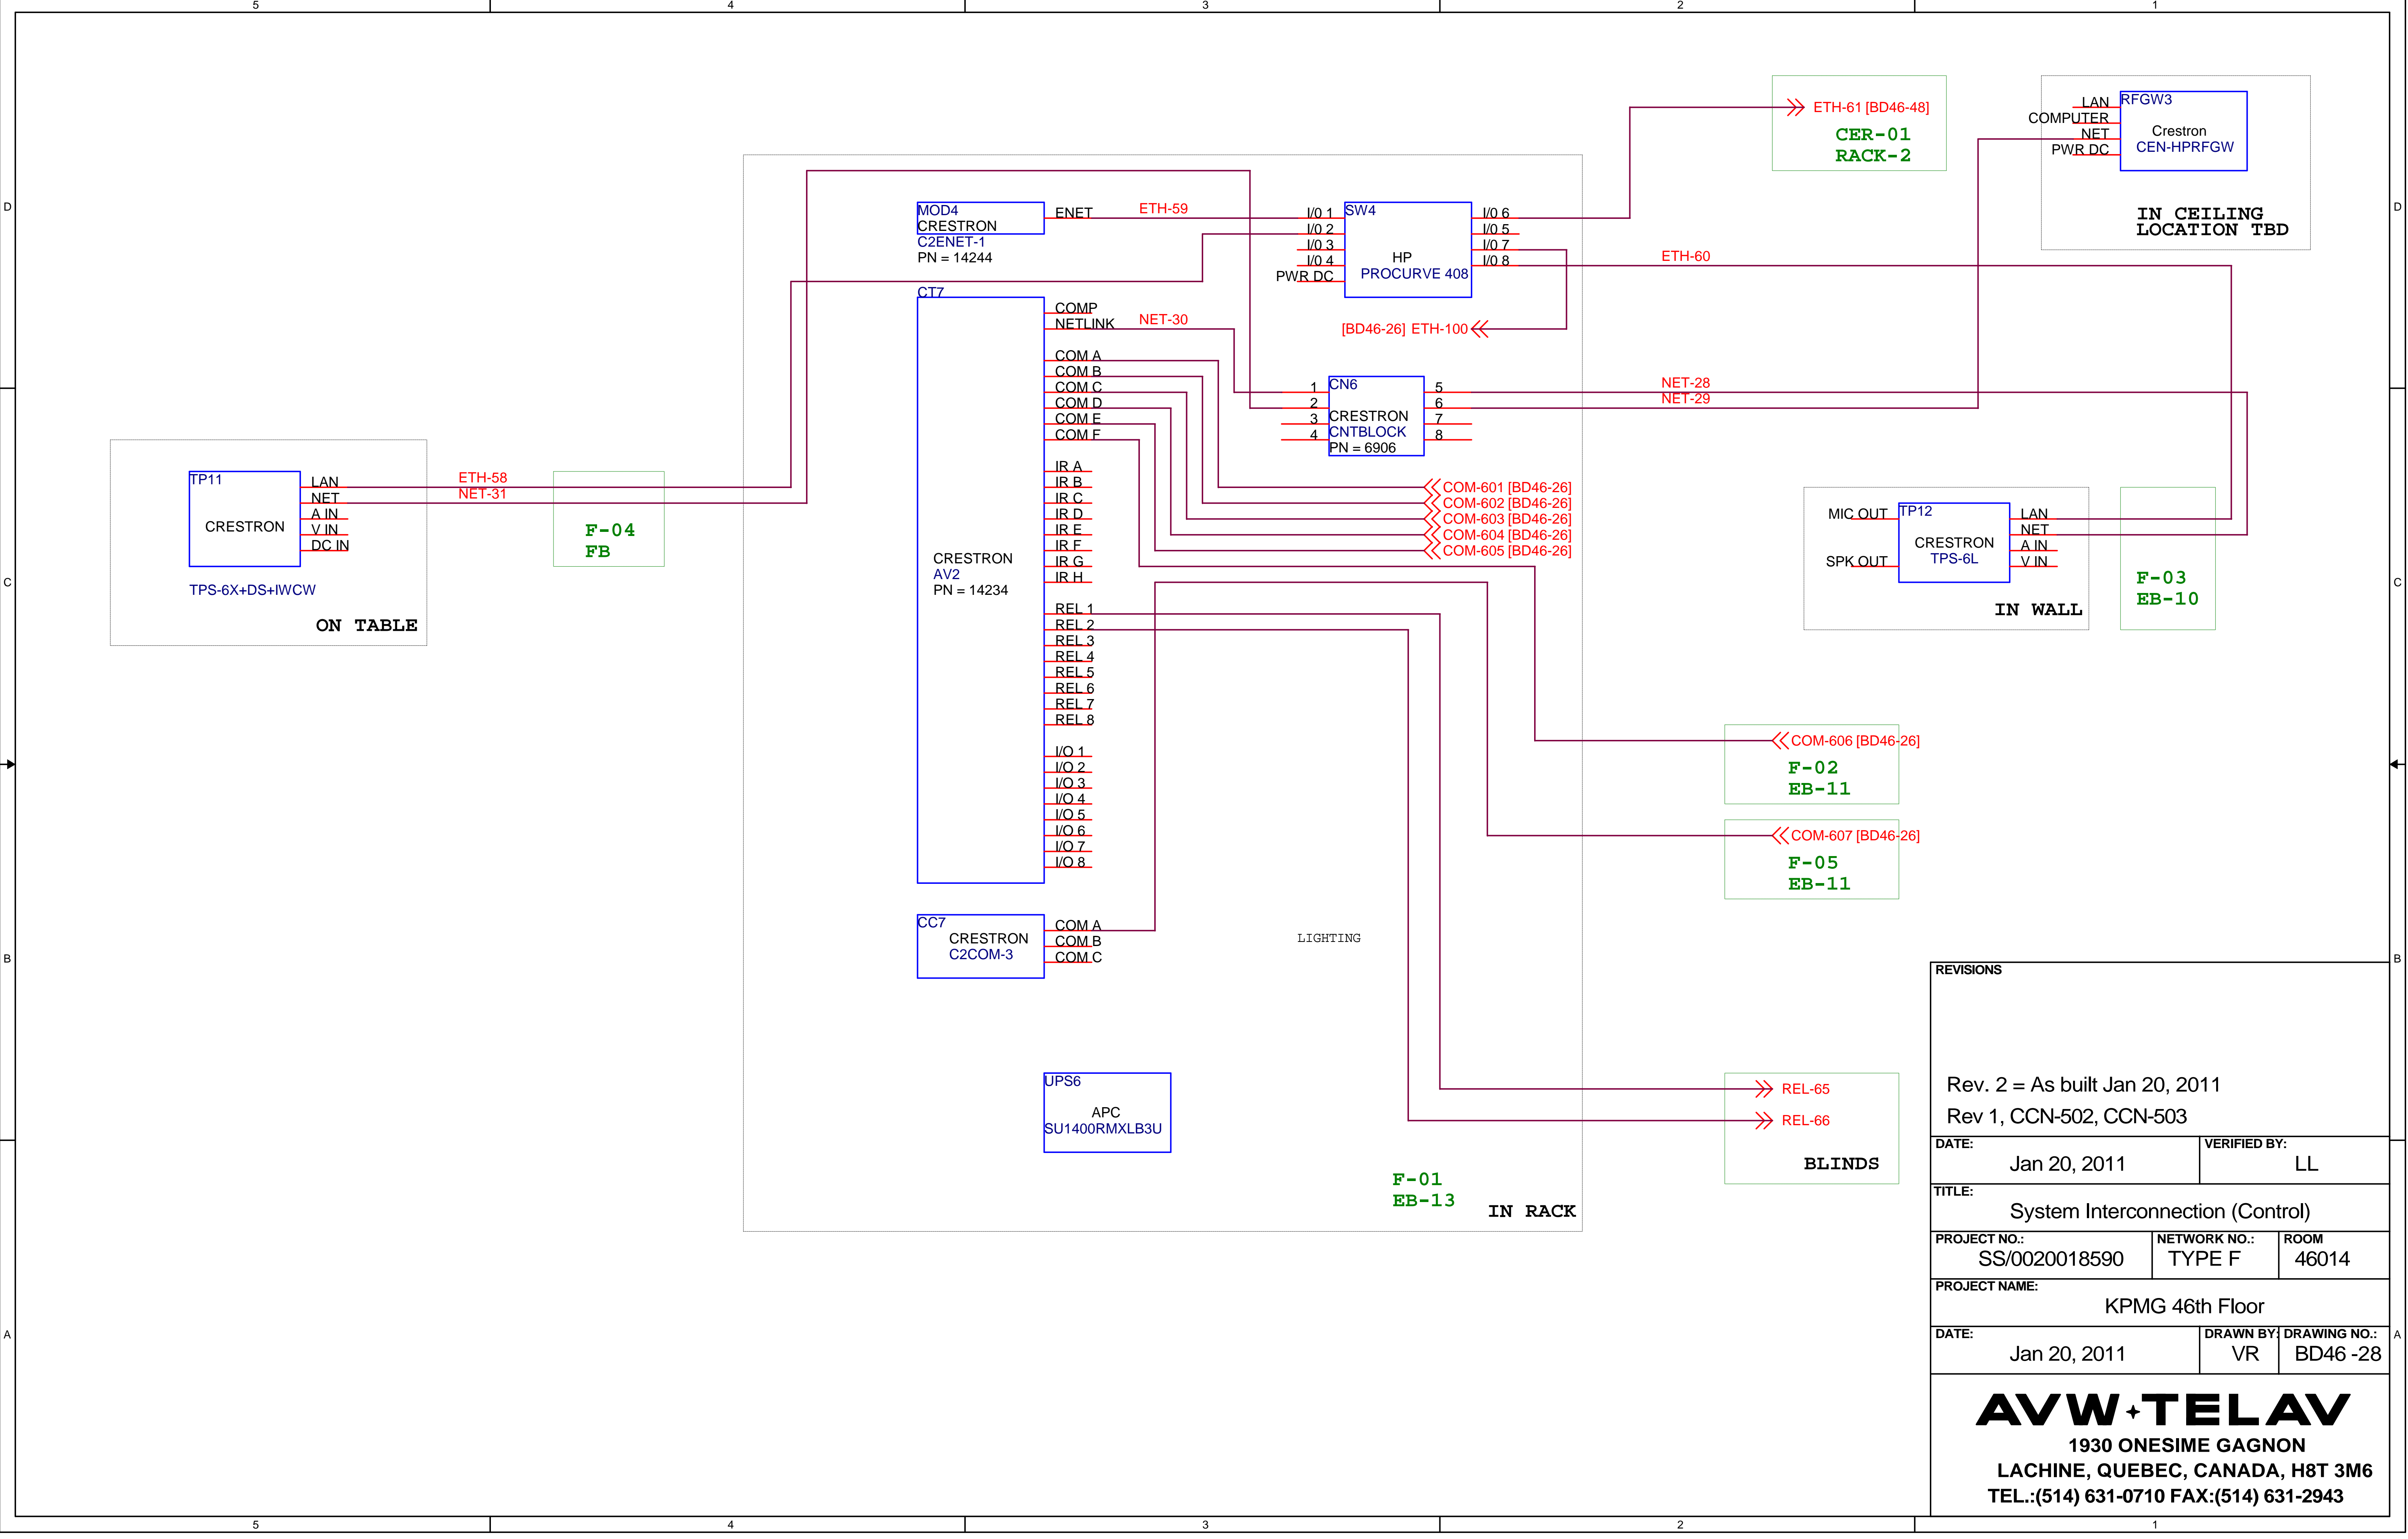


| REVISIONS | | |
|---|---------------------|-----------------------|
| Rev. 2 = As built Jan 20, 2011 Rev 1, CCN-502, CCN-503 | | |
| DATE: | Jan 20, 2011 | VERIFIED BY: LL |
| TITLE: System Interconnection (Control) | | |
| PROJECT NO.: SS/0020018590 | NETWORK NO.: TYPE F | ROOM 46014 |
| PROJECT NAME: KPMG 46th Floor | | |
| DATE: | Jan 20, 2011 | DRAWN BY: VR |
| | | DRAWING NO.: BD46 -28 |
| AVW+TELAV 1930 ONESIME GAGNON LACHINE, QUEBEC, CANADA, H8T 3M6 TEL.:(514) 631-0710 FAX:(514) 631-2943 | | |

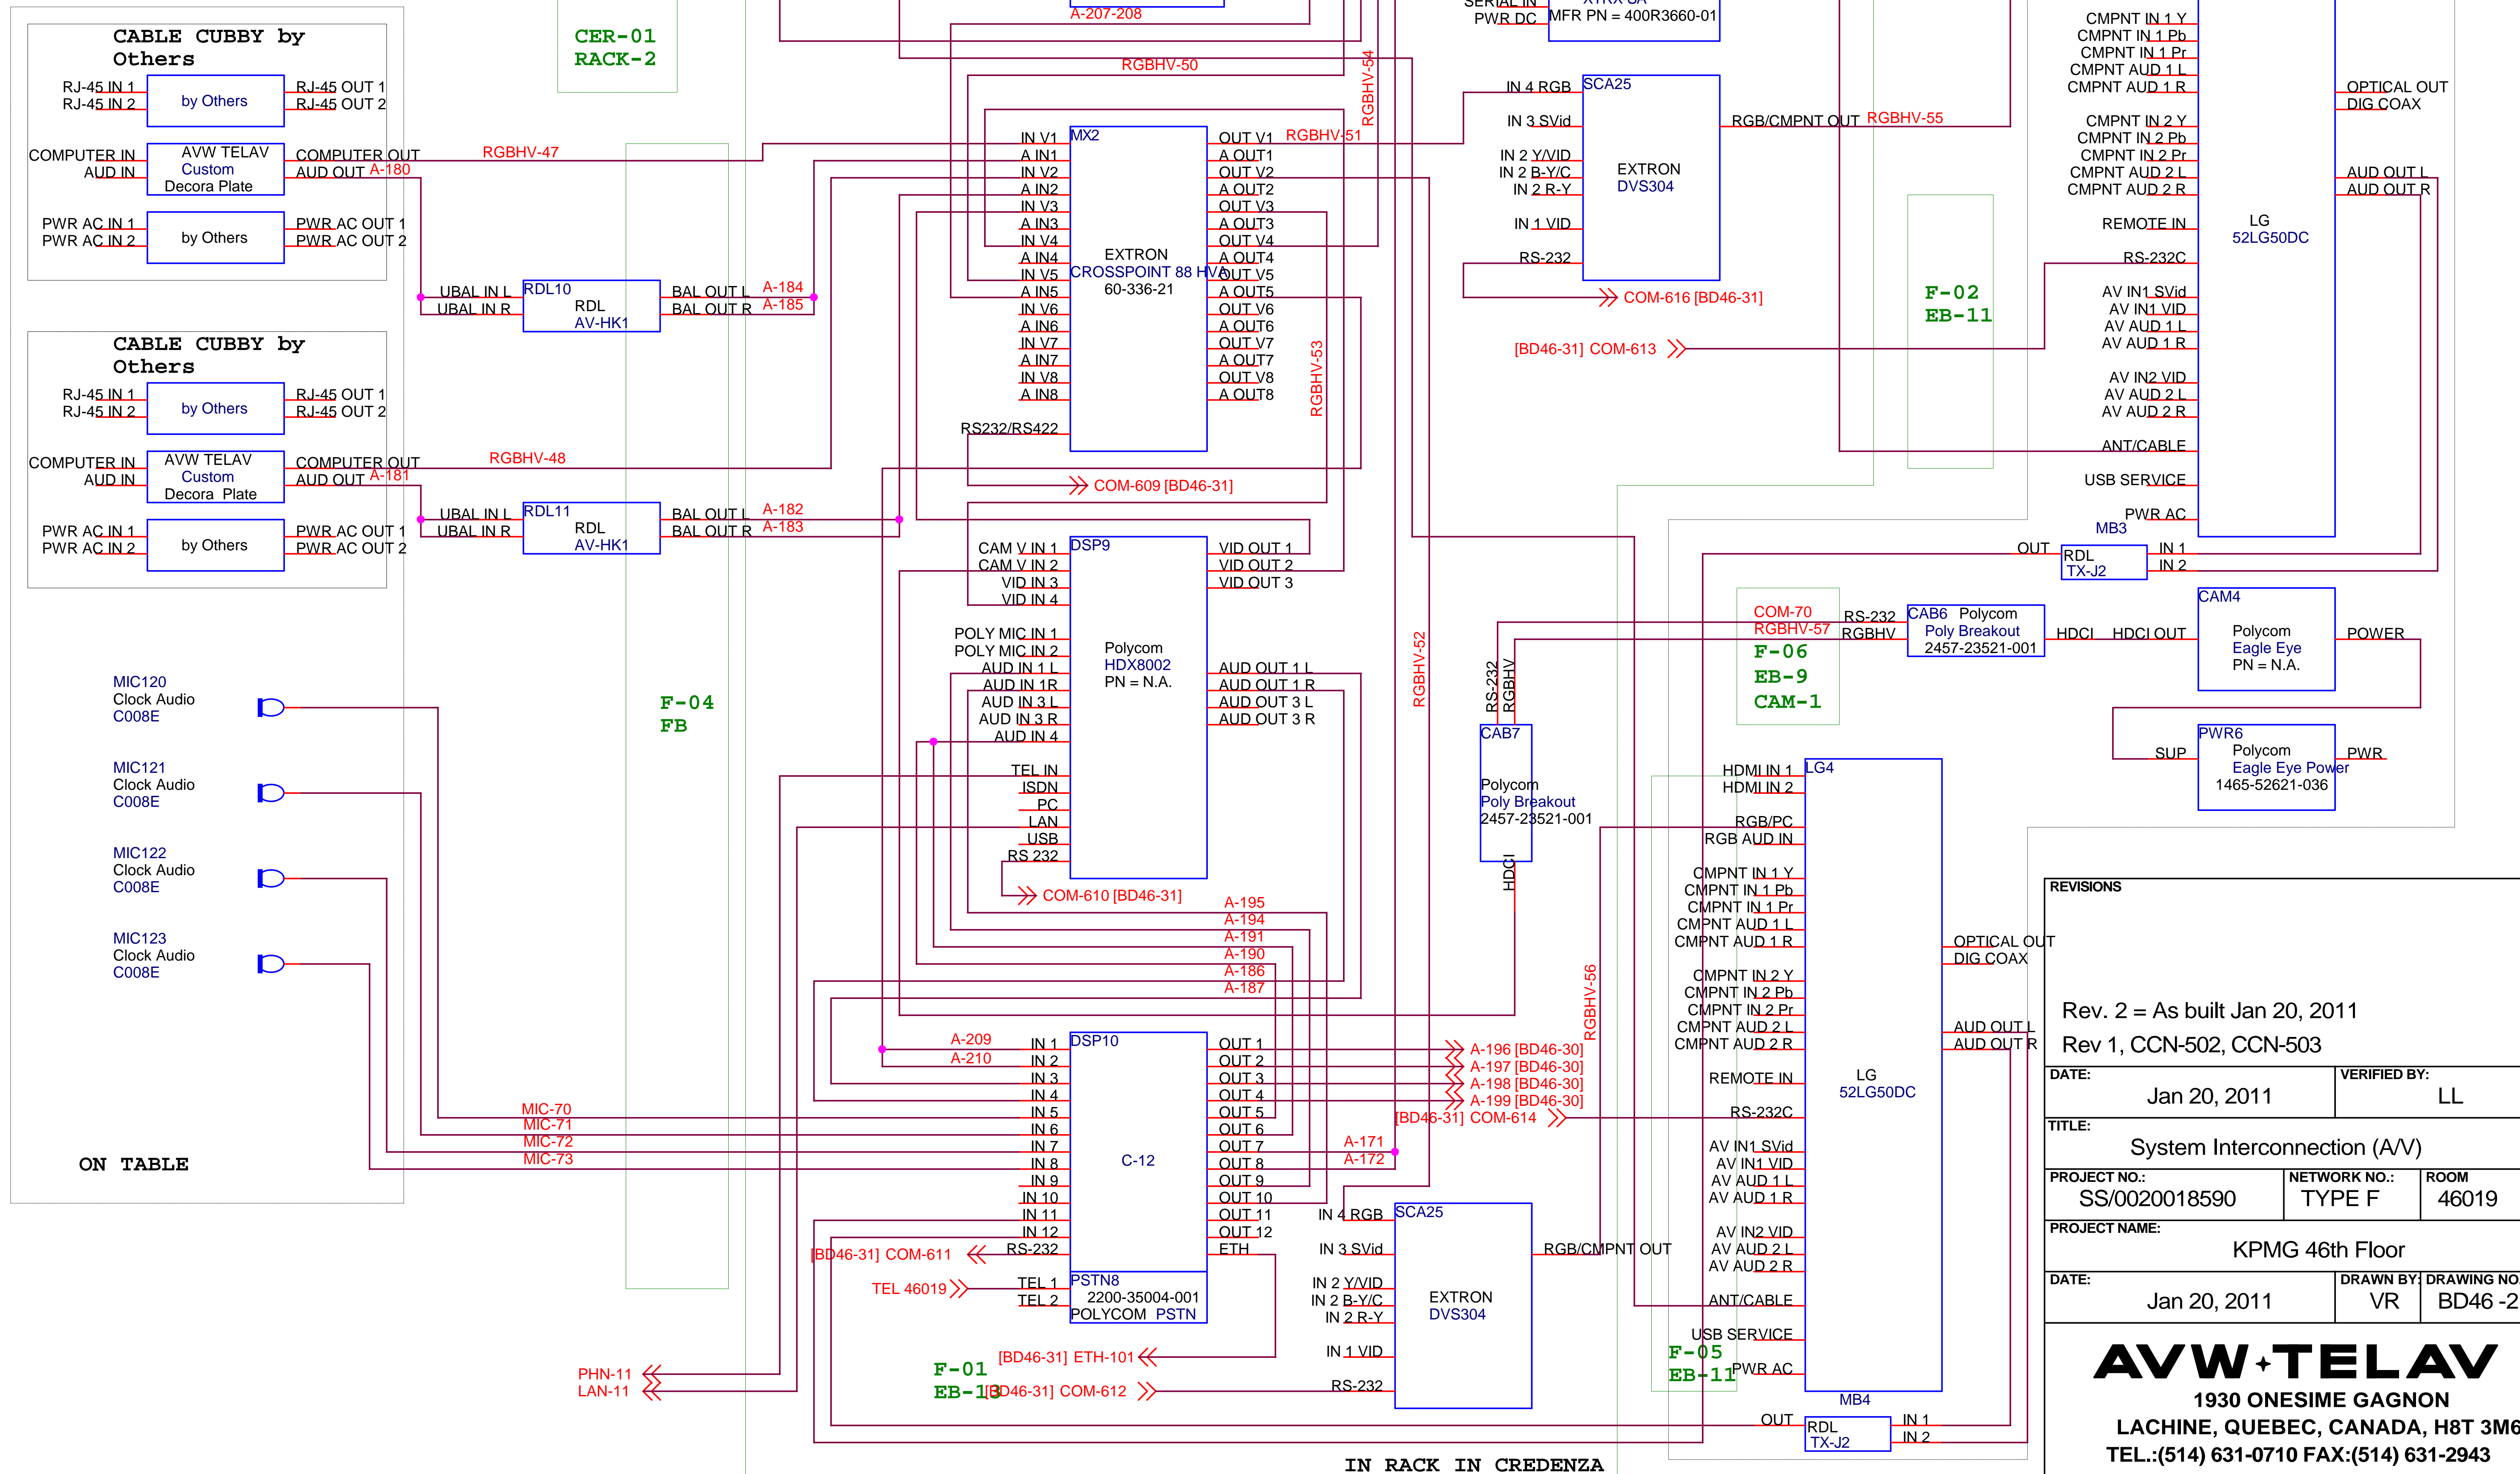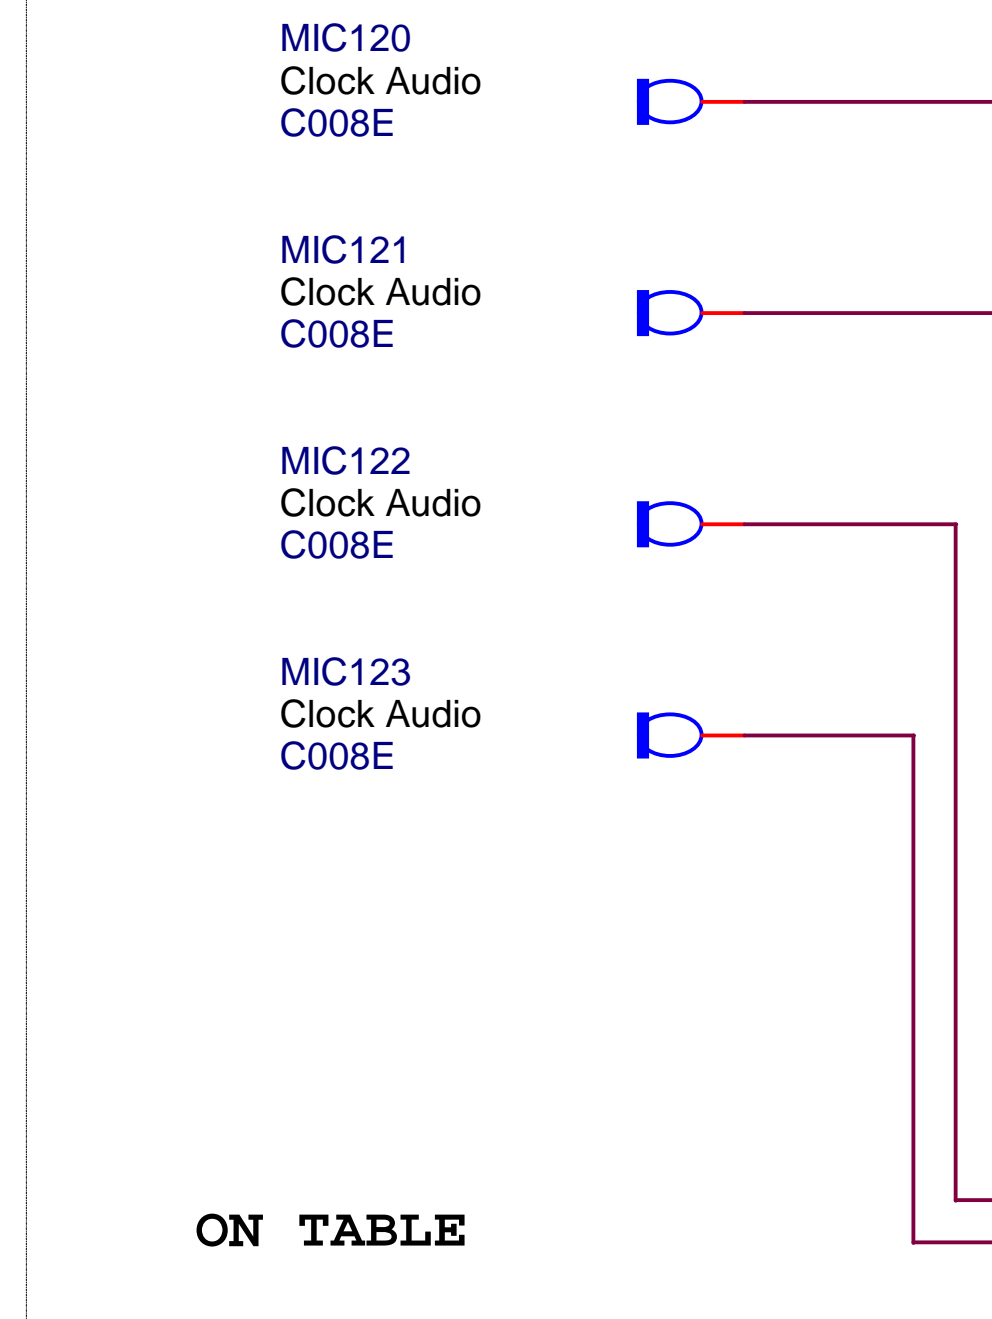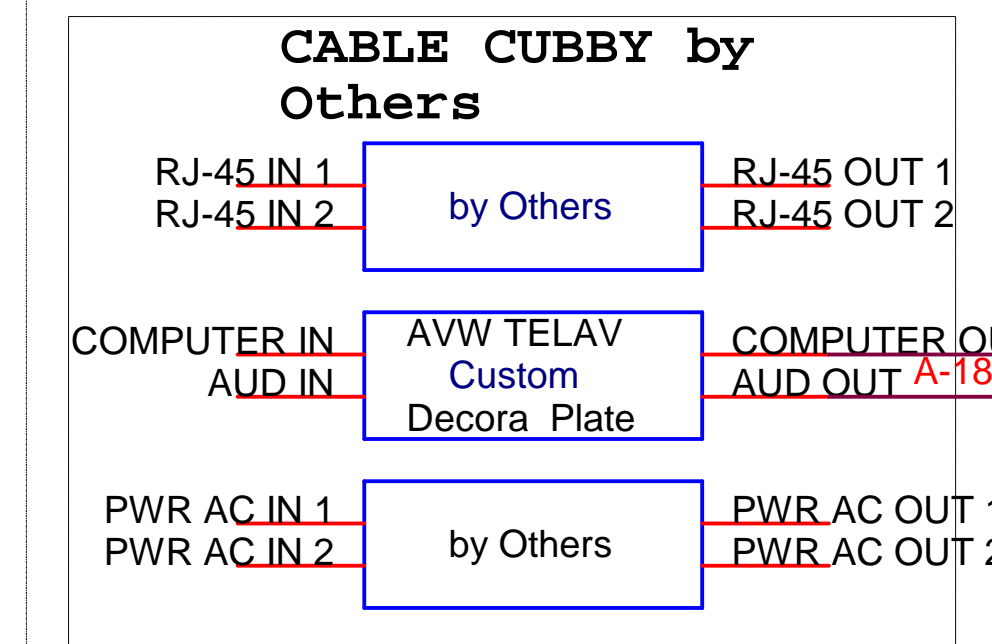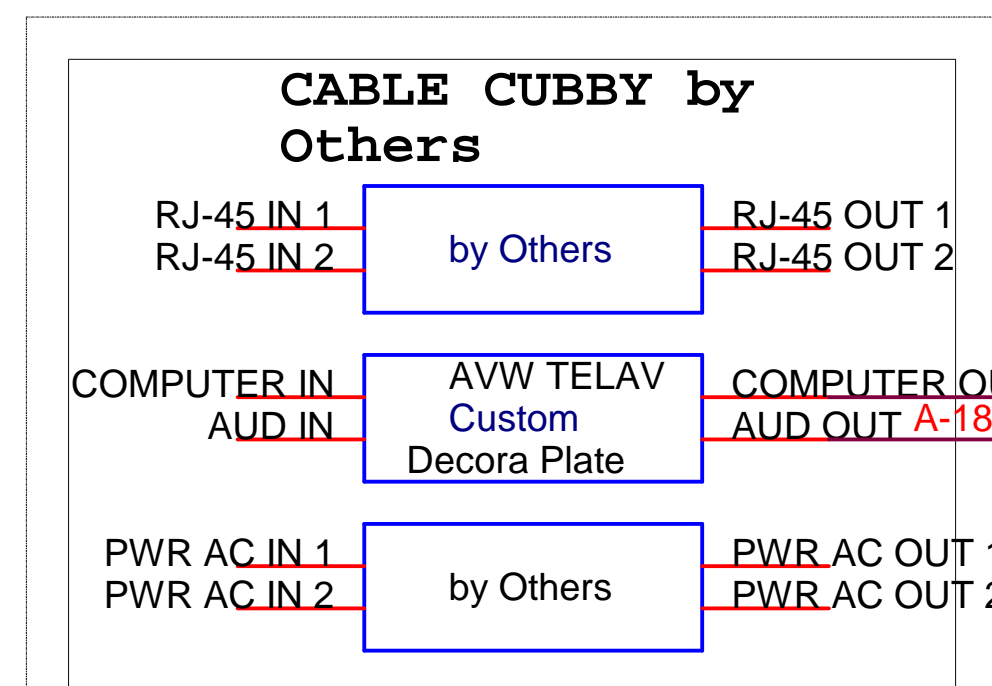


| | | | |
|---|--|----------------------------|------------------------------|
| <div style="display: flex; justify-content: space-between; align-items: flex-start;"> <div style="width: 40%;"> <p>REVISIONS</p> </div> <div style="width: 55%;"> <p>T</p> </div> </div> | | | |
| <p>Rev. 2 = As built Jan 20, 2011</p> <p>Rev 1, CCN-502, CCN-503</p> | | | |
| <p>DATE: Jan 20, 2011</p> | | <p>VERIFIED BY: LL</p> | |
| <p>TITLE: System Interconnection (A/V)</p> | | | |
| <p>PROJECT NO.: SS/0020018590</p> | | <p>NETWORK NO.: TYPE F</p> | <p>ROOM 46019</p> |
| <p>PROJECT NAME: KPMG 46th Floor</p> | | | |
| <p>DATE: Jan 20, 2011</p> | | <p>DRAWN BY: VR</p> | <p>DRAWING NO.: BD46 -29</p> |
| <div style="font-size: 2em; font-weight: bold; margin-bottom: 10px;"> AVW+TELAV </div> <div style="font-size: 1.2em; font-weight: bold; margin-bottom: 10px;"> 1930 ONESIME GAGNON </div> <div style="font-size: 1.1em; font-weight: bold; margin-bottom: 10px;"> LACHINE, QUEBEC, CANADA, H8T 3M6 </div> <div style="font-size: 1.1em; font-weight: bold;"> TEL:.(514) 631-0710 FAX:.(514) 631-2943 </div> | | | |

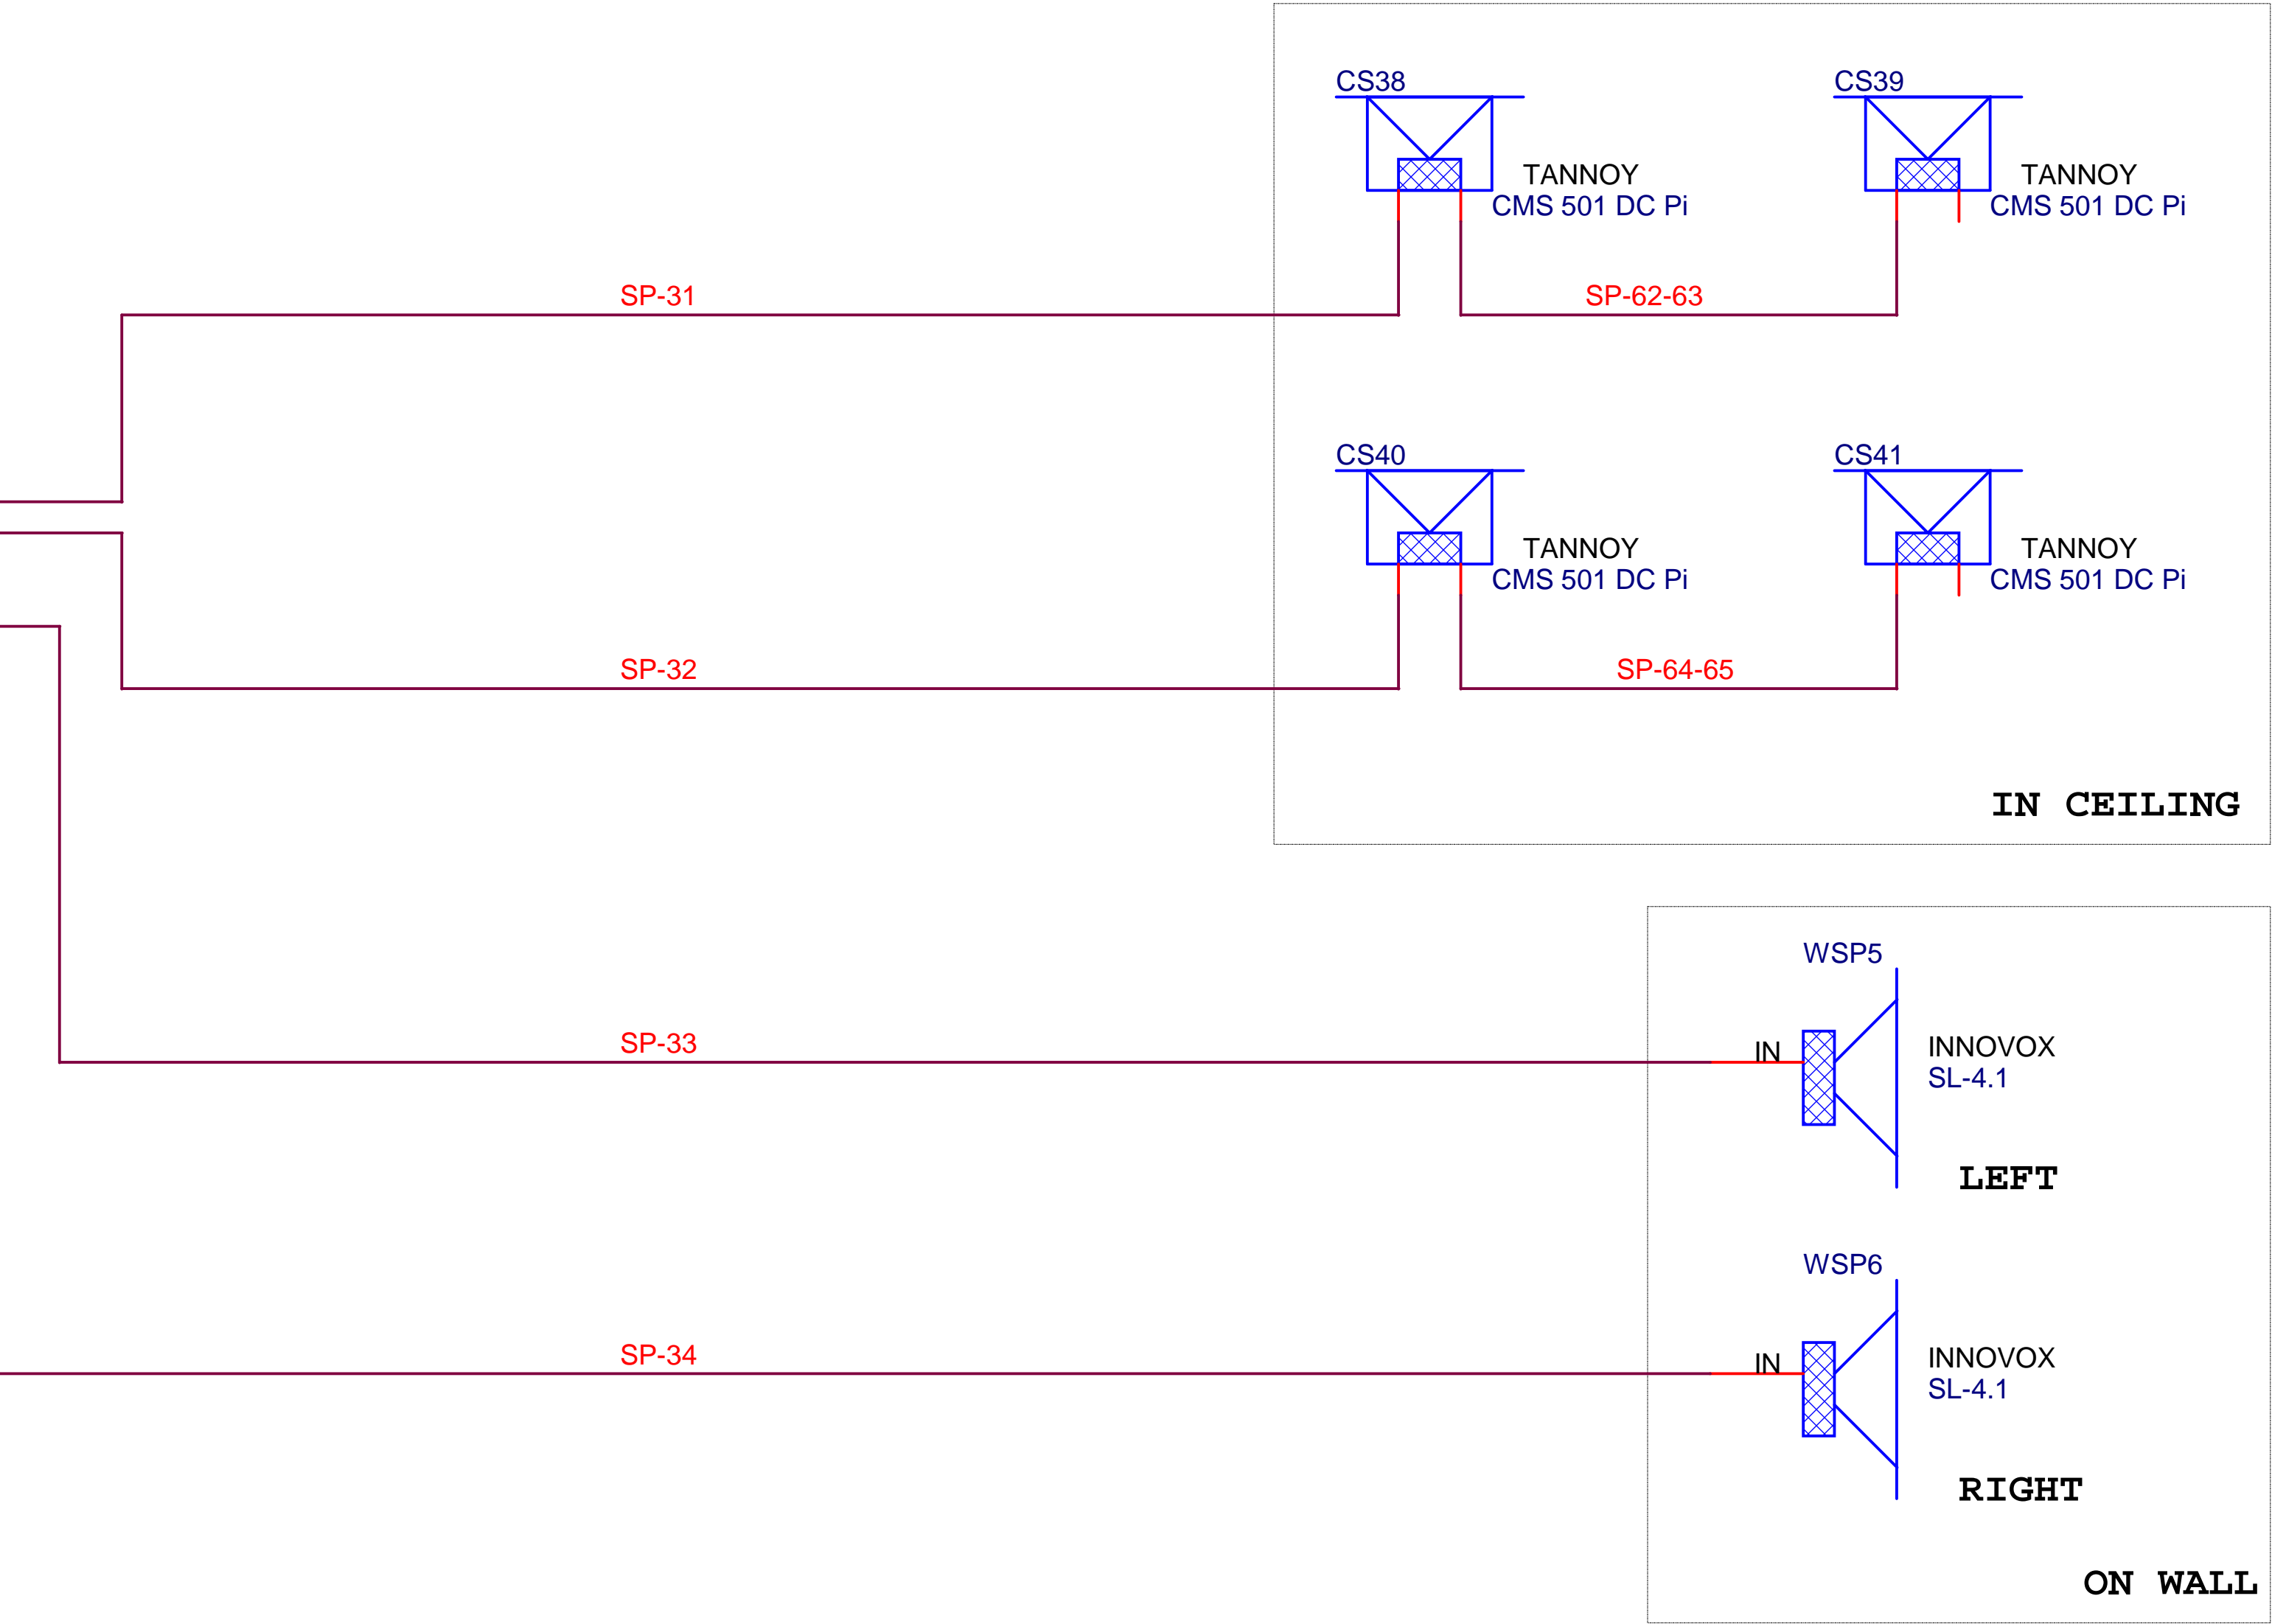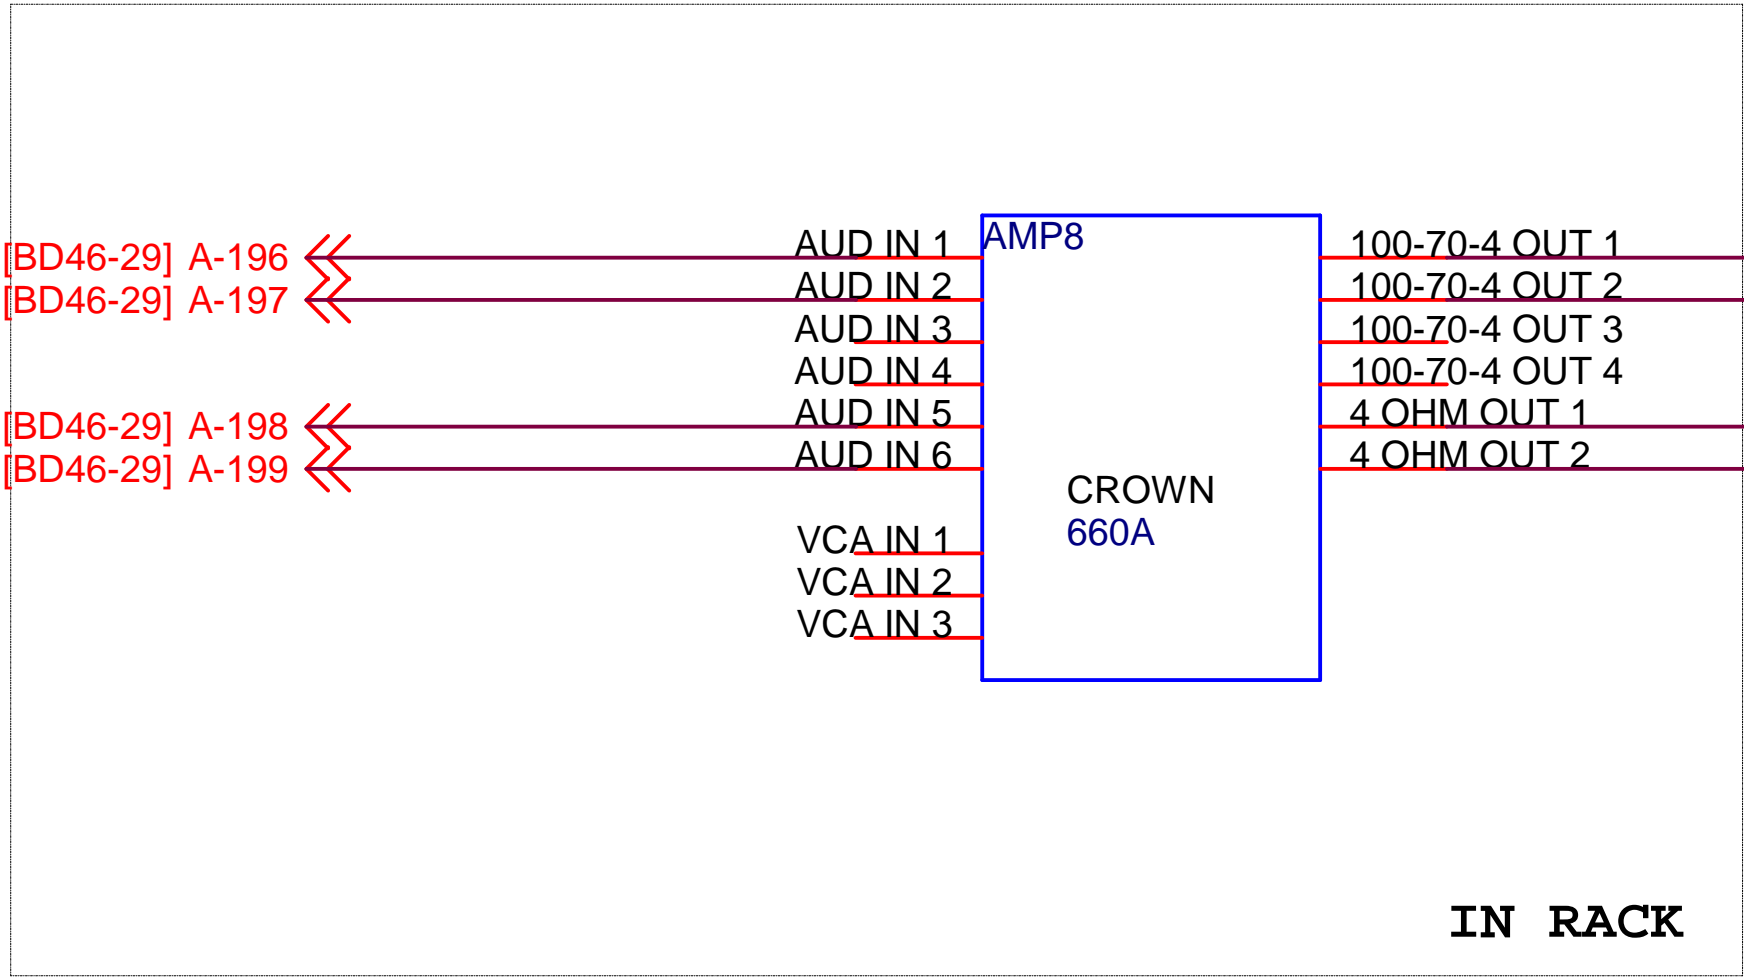


| REVISIONS | | |
|---|---------------|---------------------|
| Rev. 2 = As built Jan 20, 2011 | | |
| Rev 1, CCN-502, CCN-503 | | |
| DATE: | Jan 20, 2011 | VERIFIED BY: LL |
| TITLE: System Interconnection (A/V) | | |
| PROJECT NO.: | SS/0020018590 | NETWORK NO.: TYPE F |
| PROJECT NAME: KPMG 46th Floor | | |
| DATE: | Jan 20, 2011 | DRAWN BY: VR |
| DRAWING NO.: BD46 -30 | | |
| AVW+TELAV 1930 ONESIME GAGNON LACHINE, QUEBEC, CANADA, H8T 3M6 TEL.:(514) 631-0710 FAX:(514) 631-2943 | | |

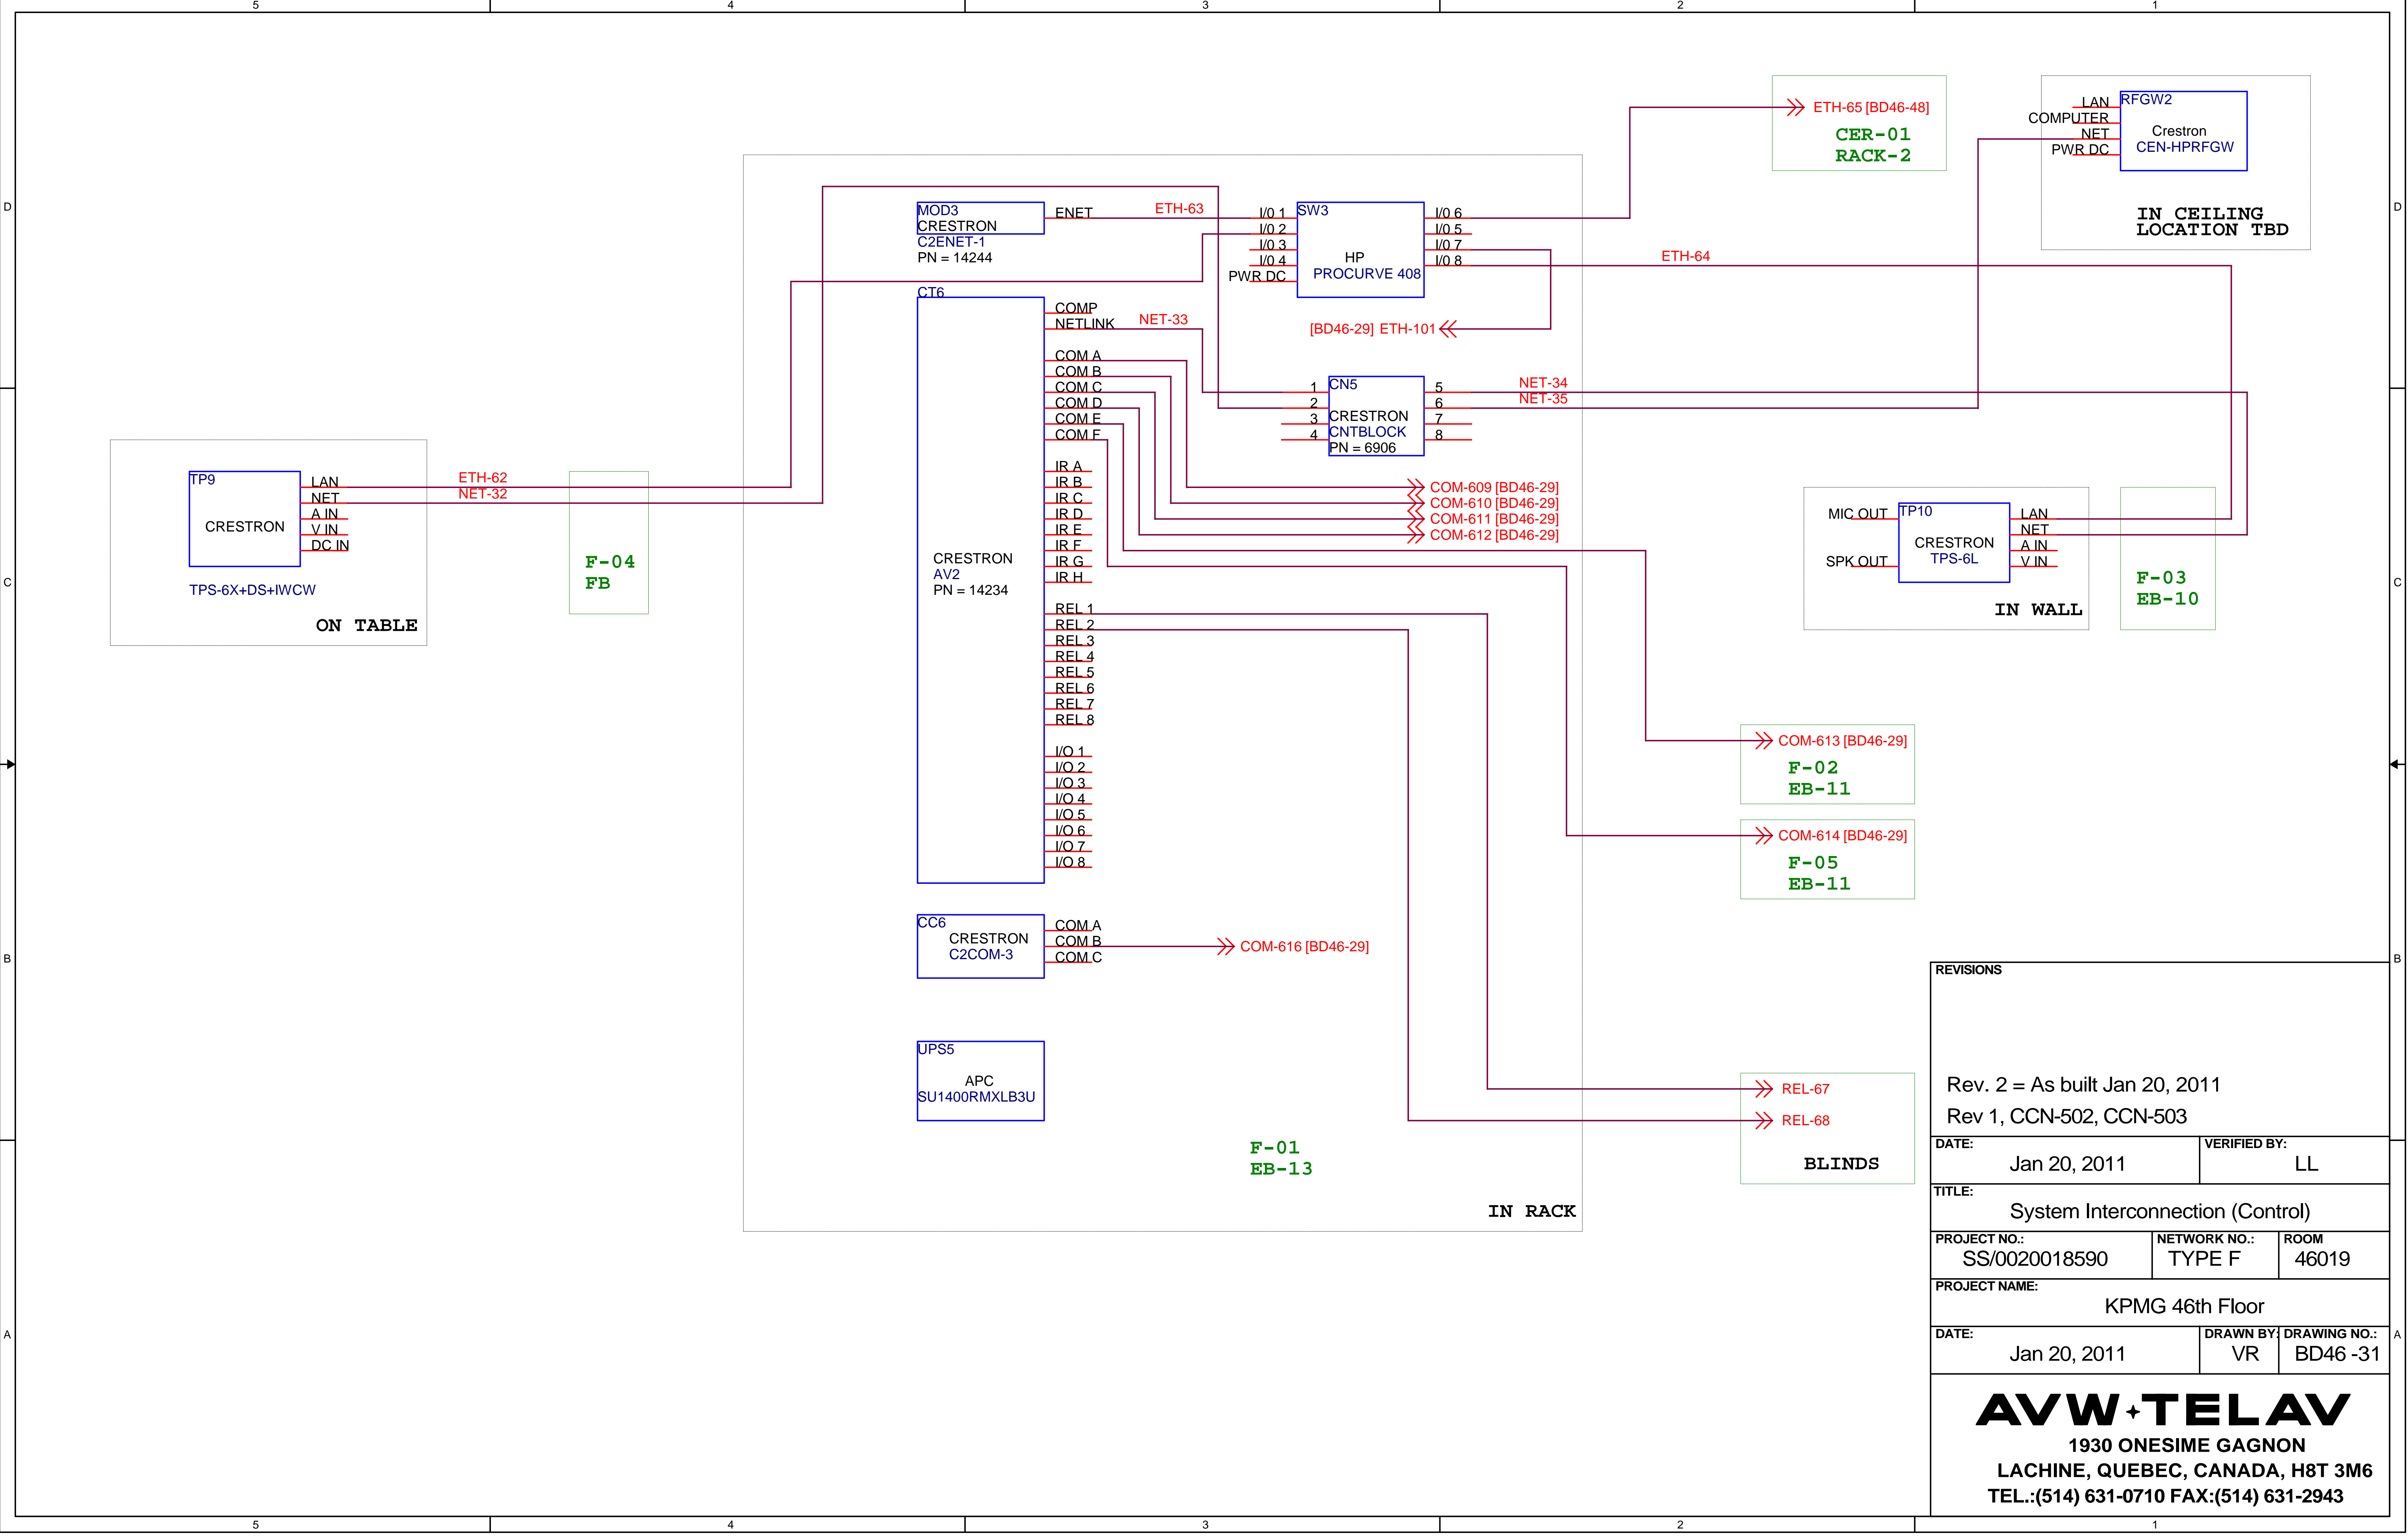



| REVISIONS | | |
|---|------------------------|---------------------------------------|
| Rev. 2 = As built Jan 20, 2011 Rev 1, CCN-502, CCN-503 | | |
| DATE: | Jan 20, 2011 | VERIFIED BY: LL |
| TITLE: System Interconnection (Control) | | |
| PROJECT NO.: SS/0020018590 | NETWORK NO.: TYPE F | ROOM 46019 |
| PROJECT NAME: KPMG 46th Floor | | |
| DATE: | Jan 20, 2011 | DRAWN BY: VR DRAWING NO.: BD46 -31 |
| AVW+TELAV 1930 ONESIME GAGNON LACHINE, QUEBEC, CANADA, H8T 3M6 TEL.:(514) 631-0710 FAX:(514) 631-2943 | | |

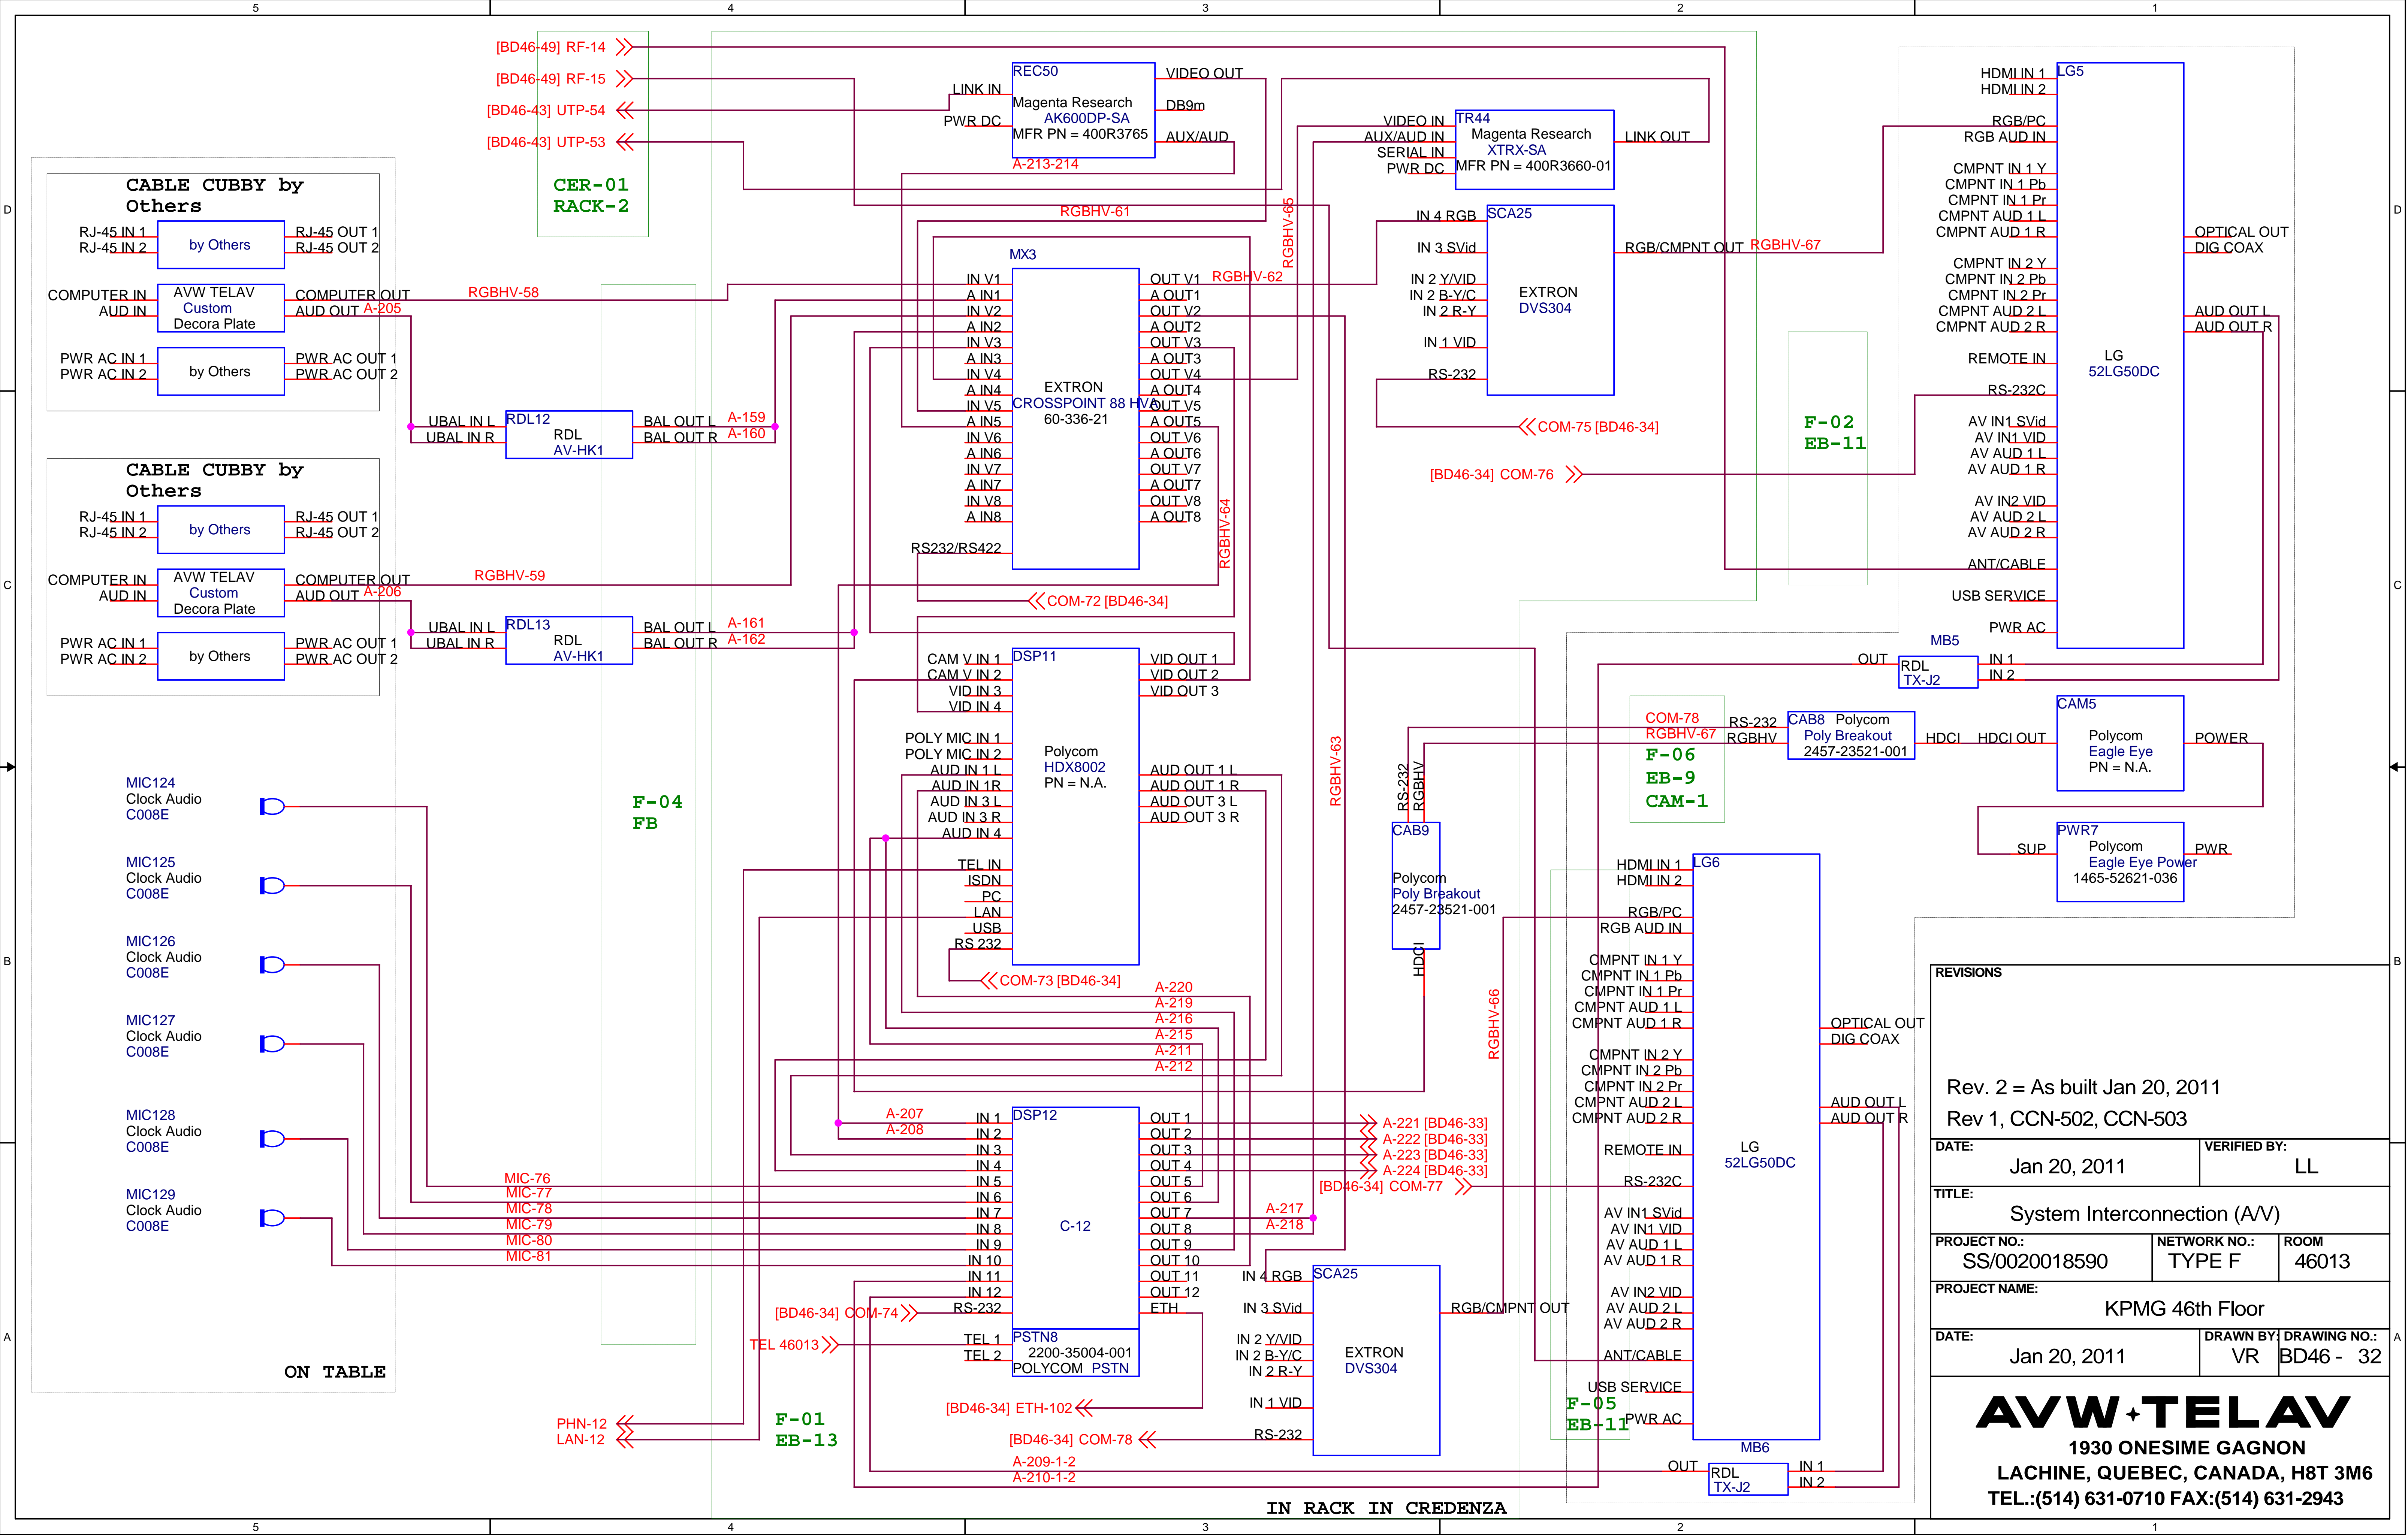


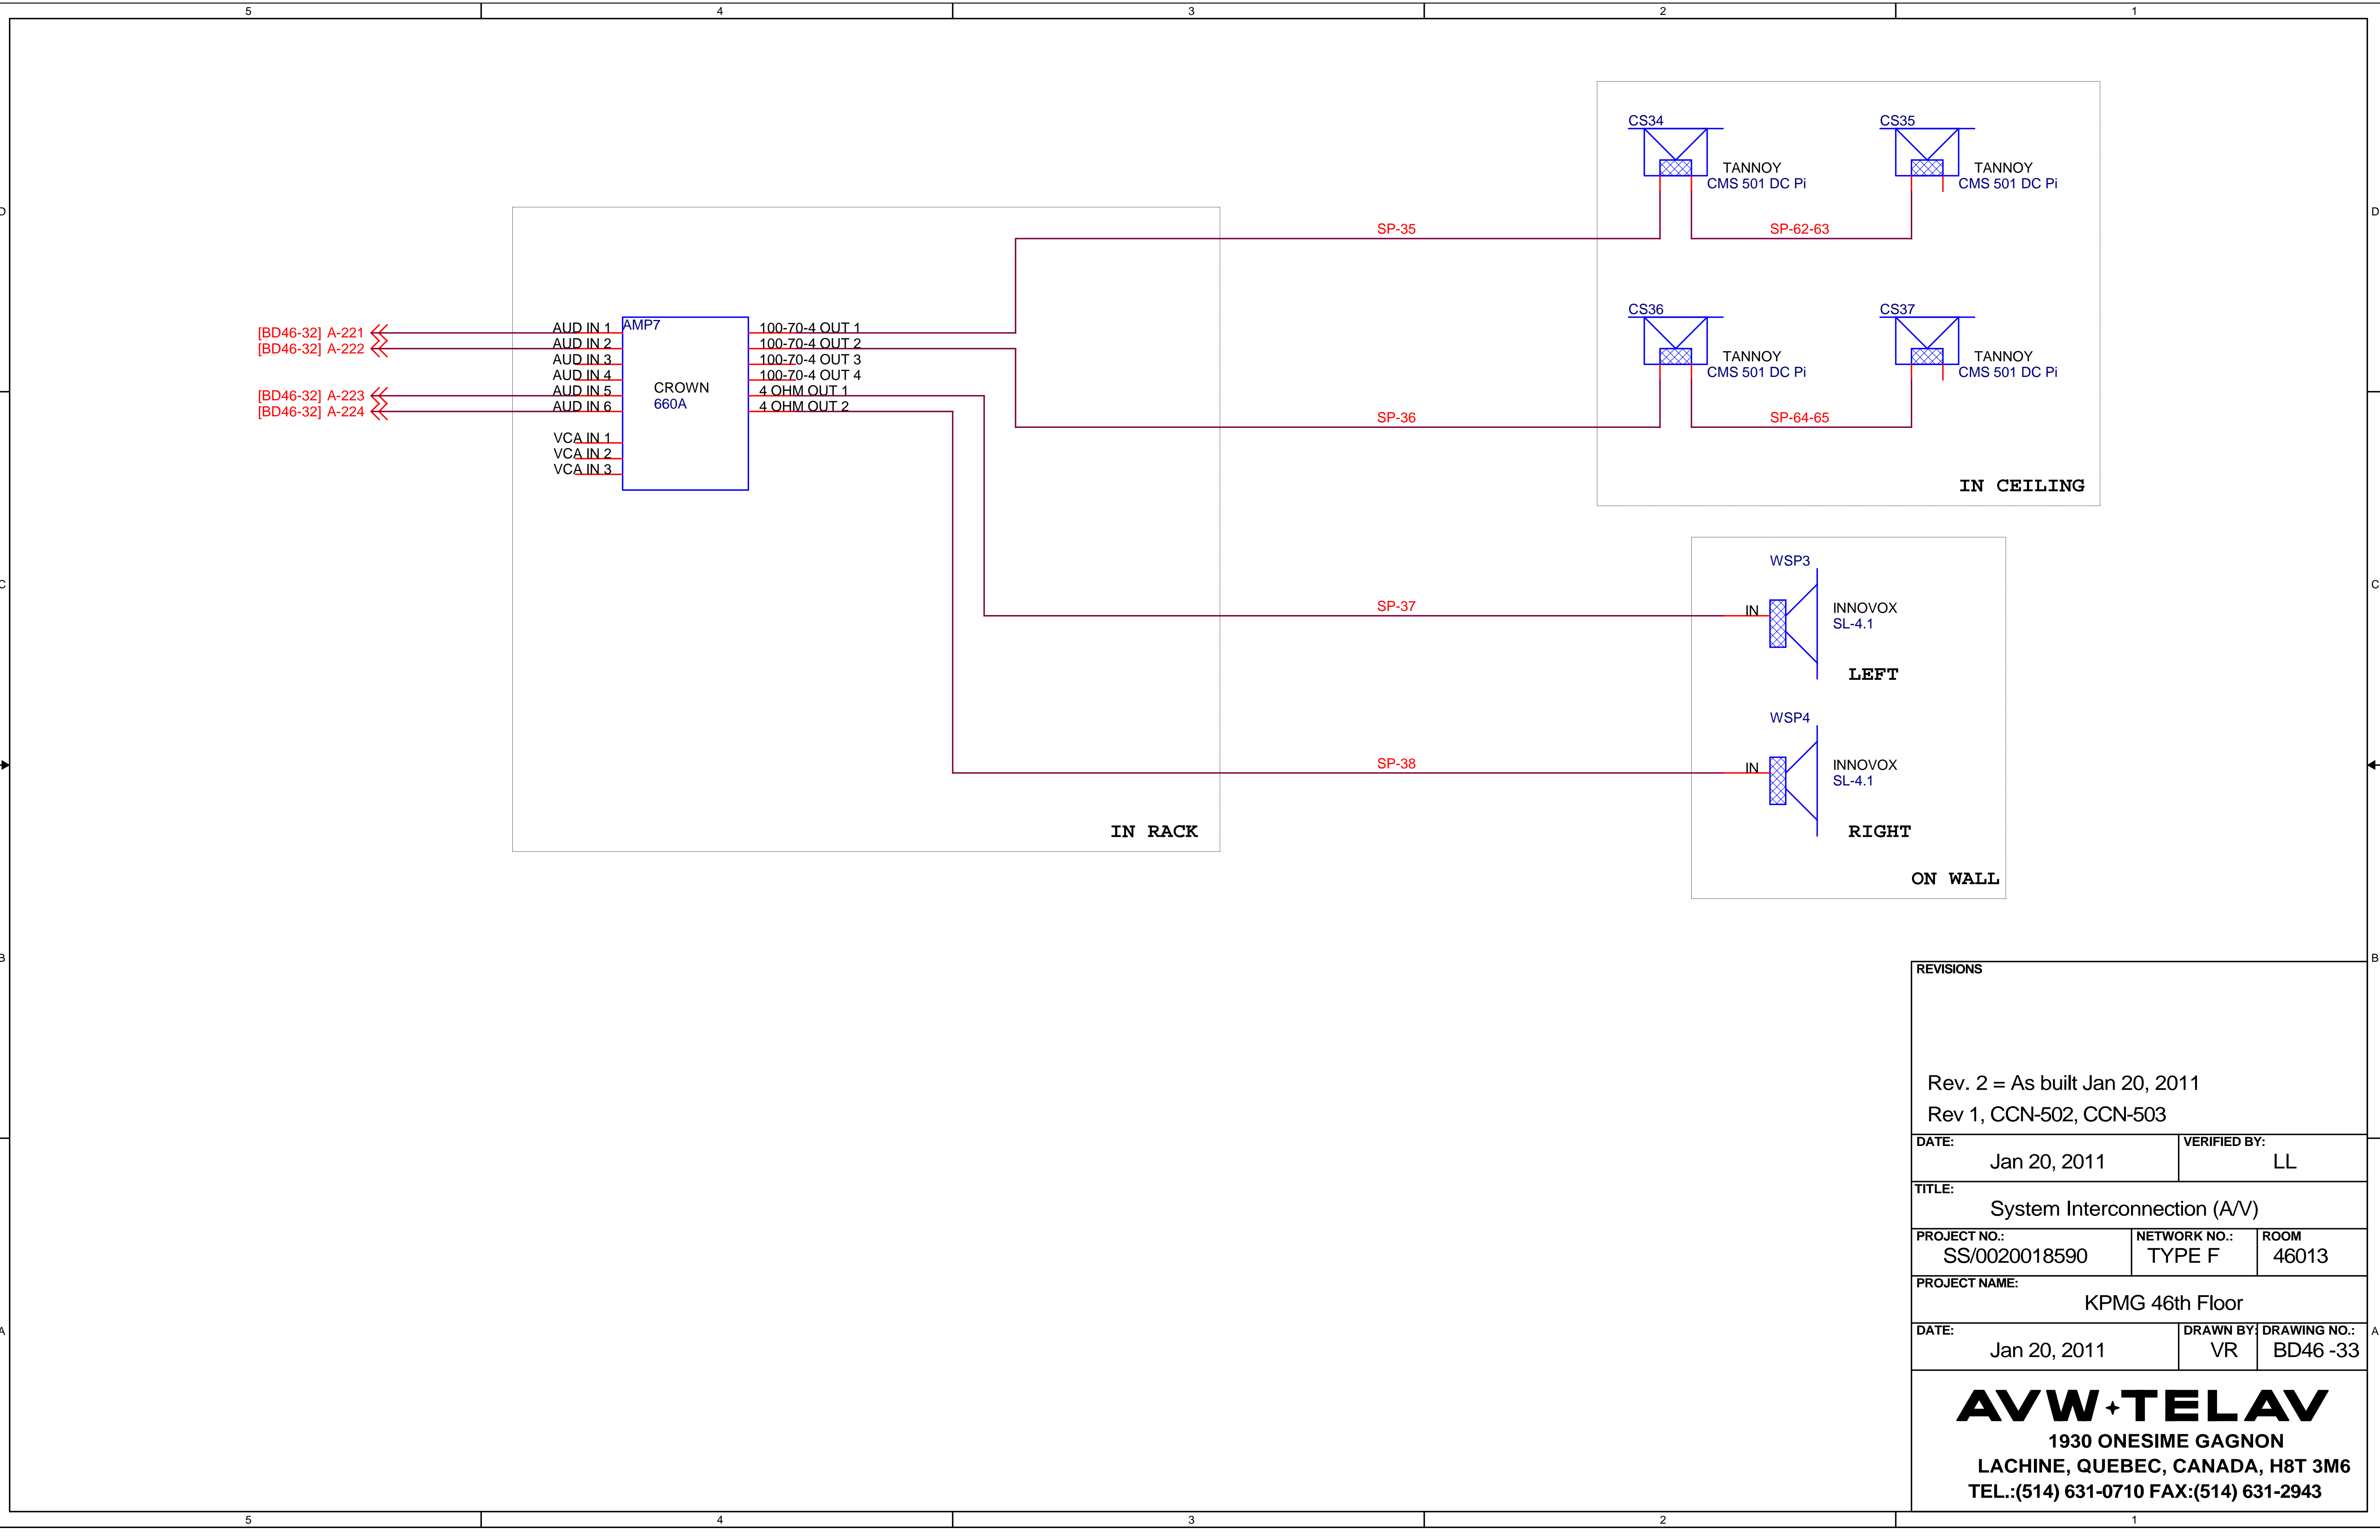


| REVISIONS | | |
|---|---------------|------------------------|
| Rev. 2 = As built Jan 20, 2011 Rev 1, CCN-502, CCN-503 | | |
| DATE: | Jan 20, 2011 | VERIFIED BY: LL |
| TITLE: System Interconnection (A/V) | | |
| PROJECT NO.: | SS/0020018590 | NETWORK NO.: TYPE F |
| PROJECT NAME: KPMG 46th Floor | | |
| DATE: | Jan 20, 2011 | DRAWN BY: VR |
| DRAWING NO.: BD46 -33 | | |
| AVW+TELAV 1930 ONESIME GAGNON LACHINE, QUEBEC, CANADA, H8T 3M6 TEL.:(514) 631-0710 FAX:(514) 631-2943 | | |

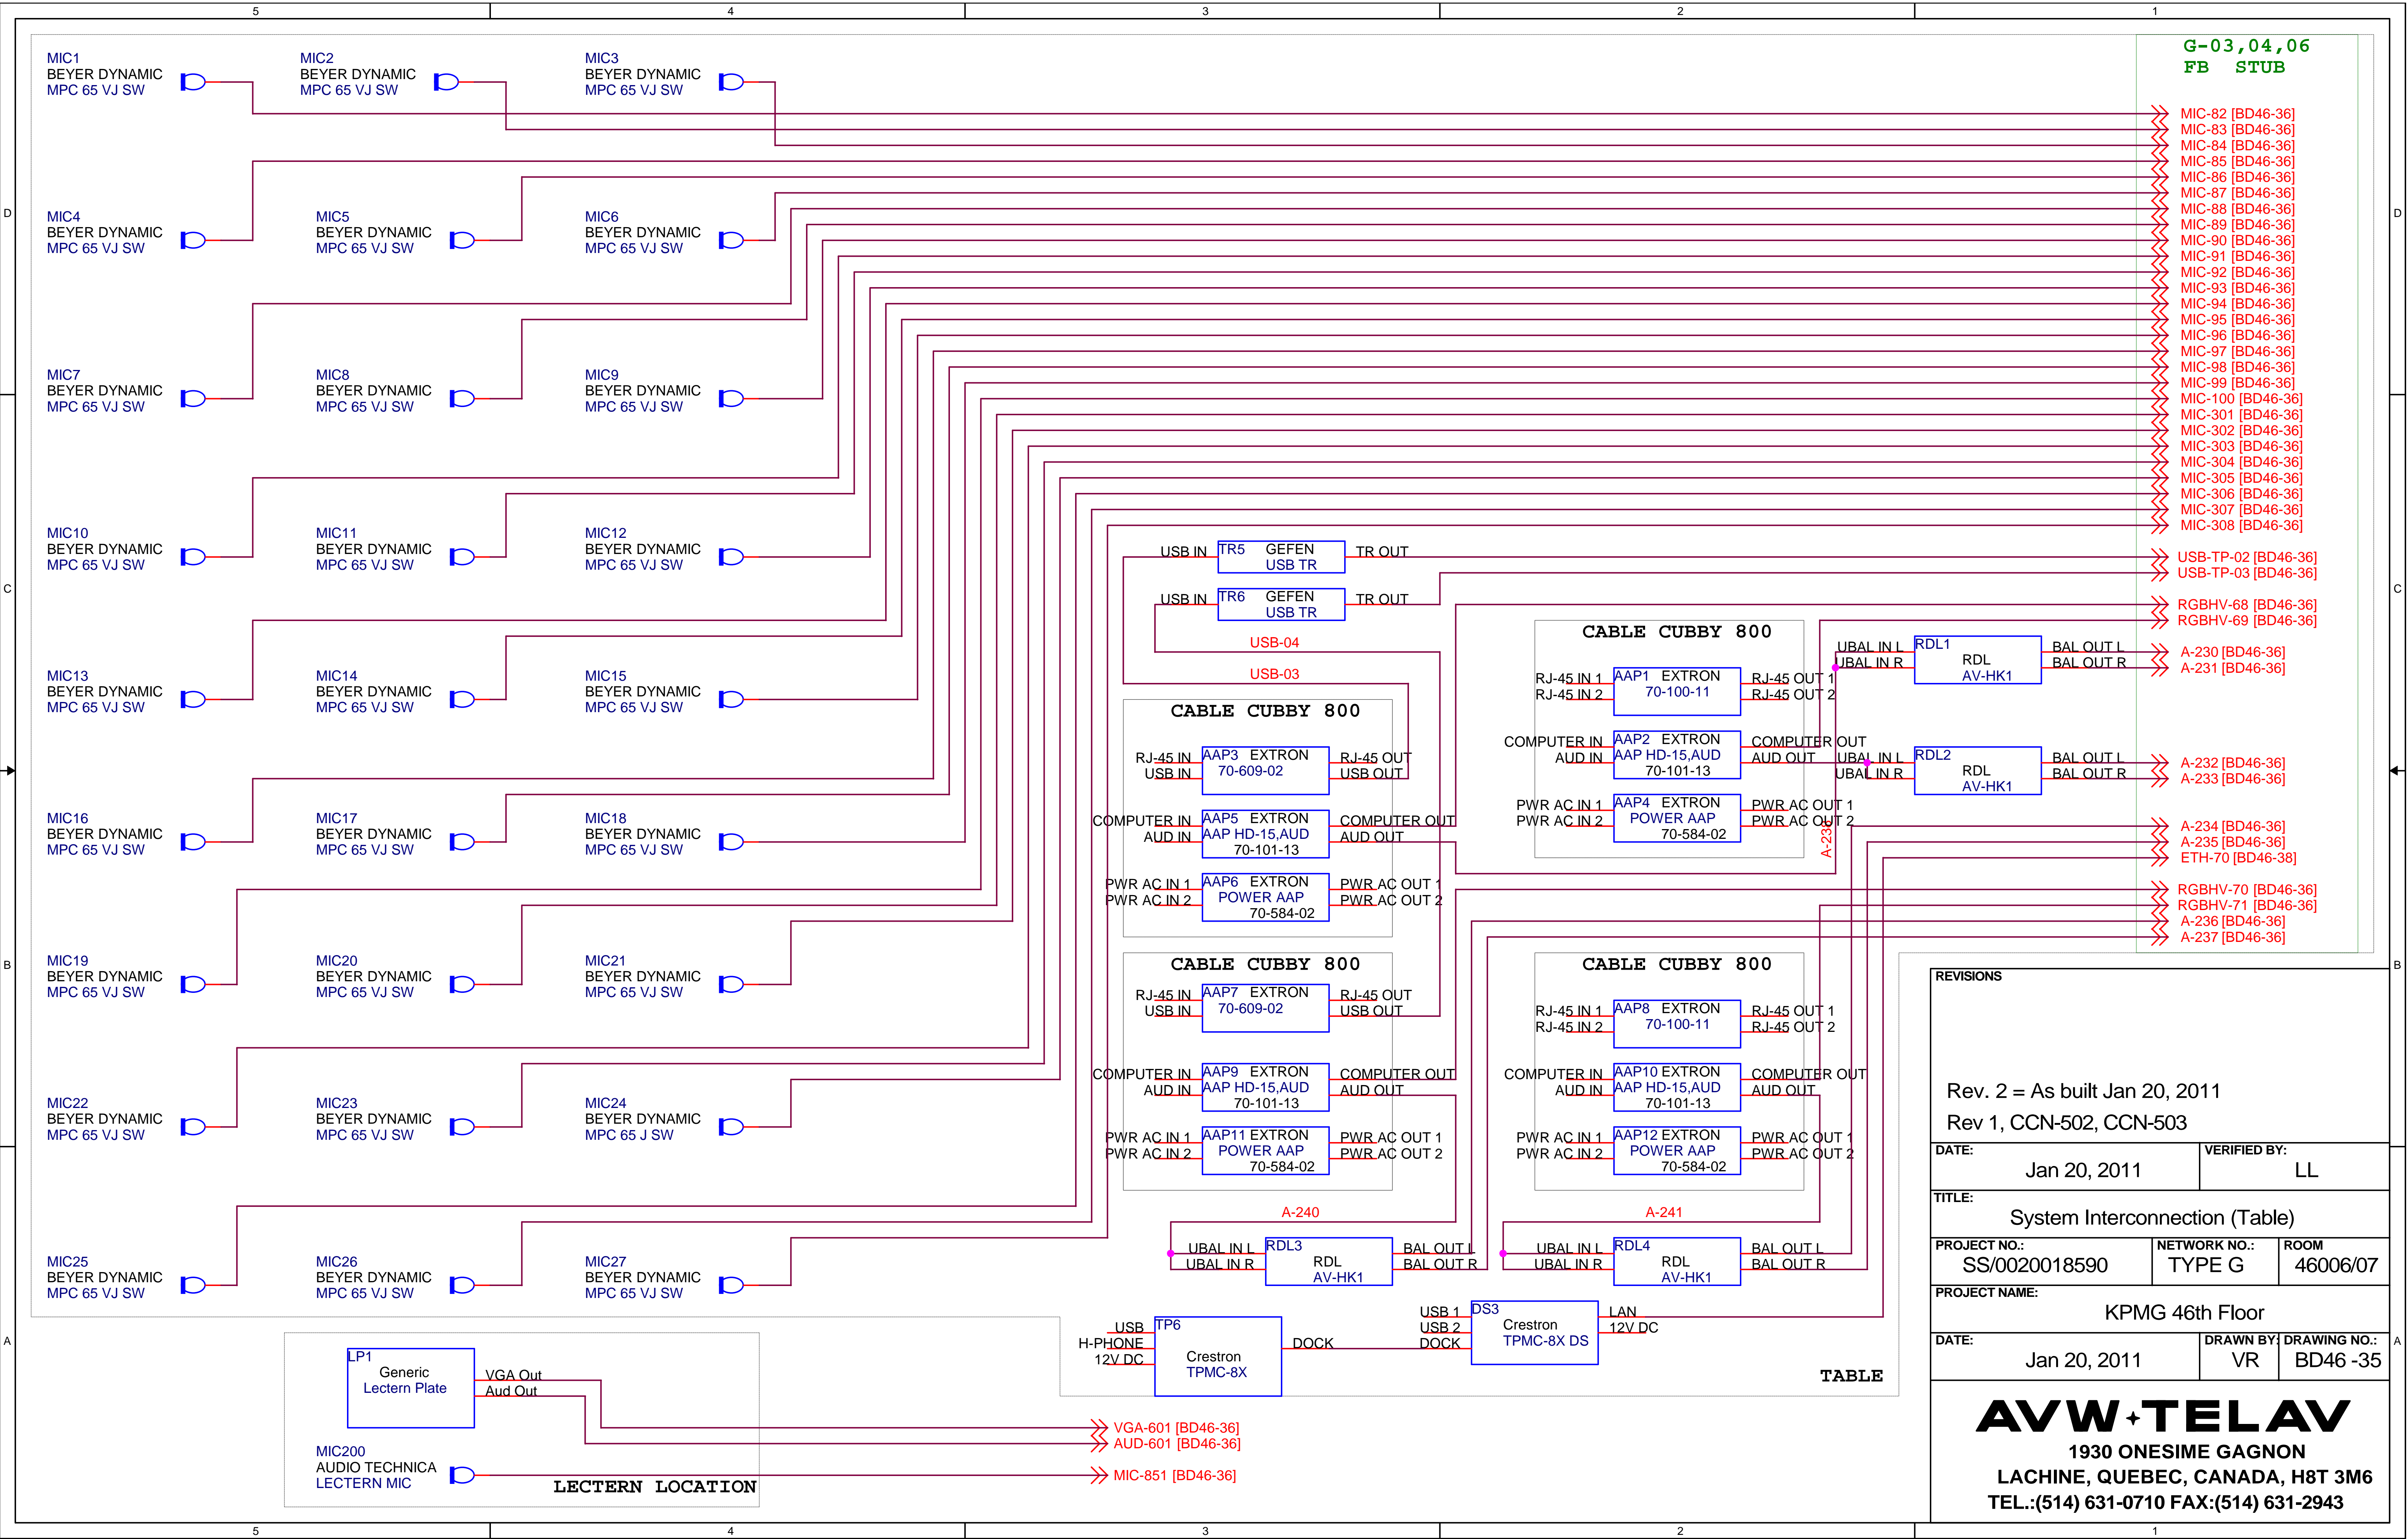

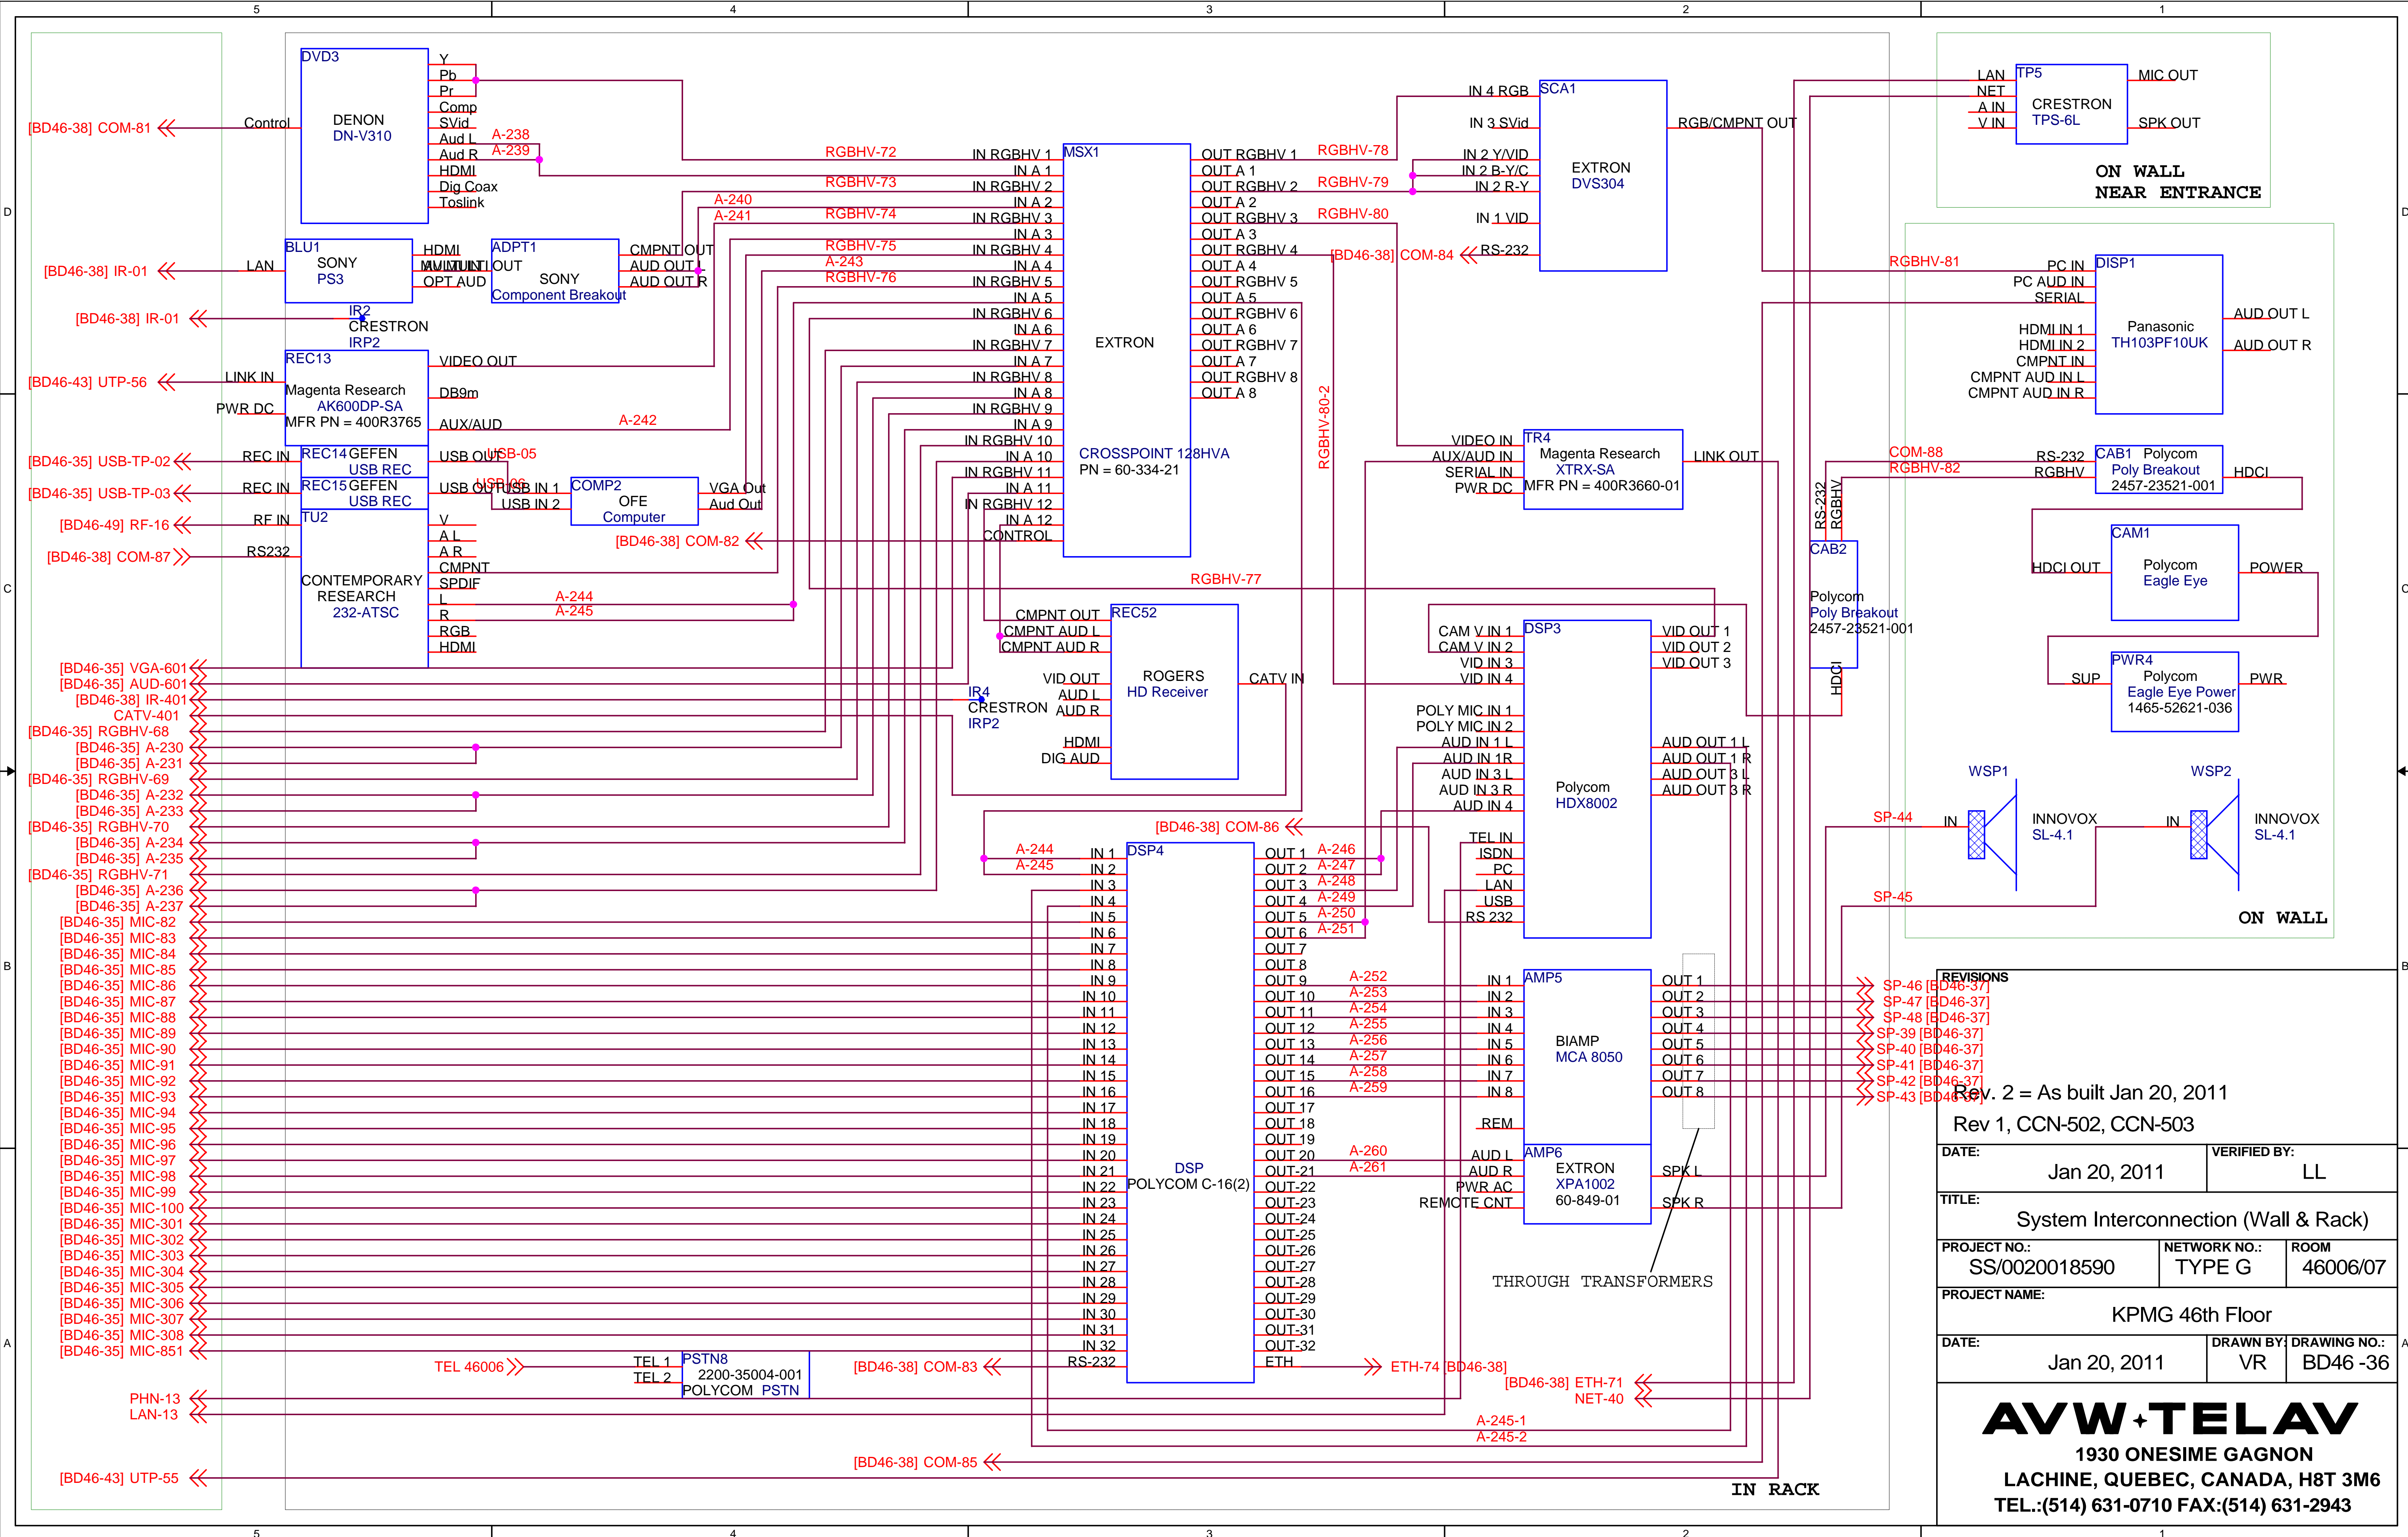


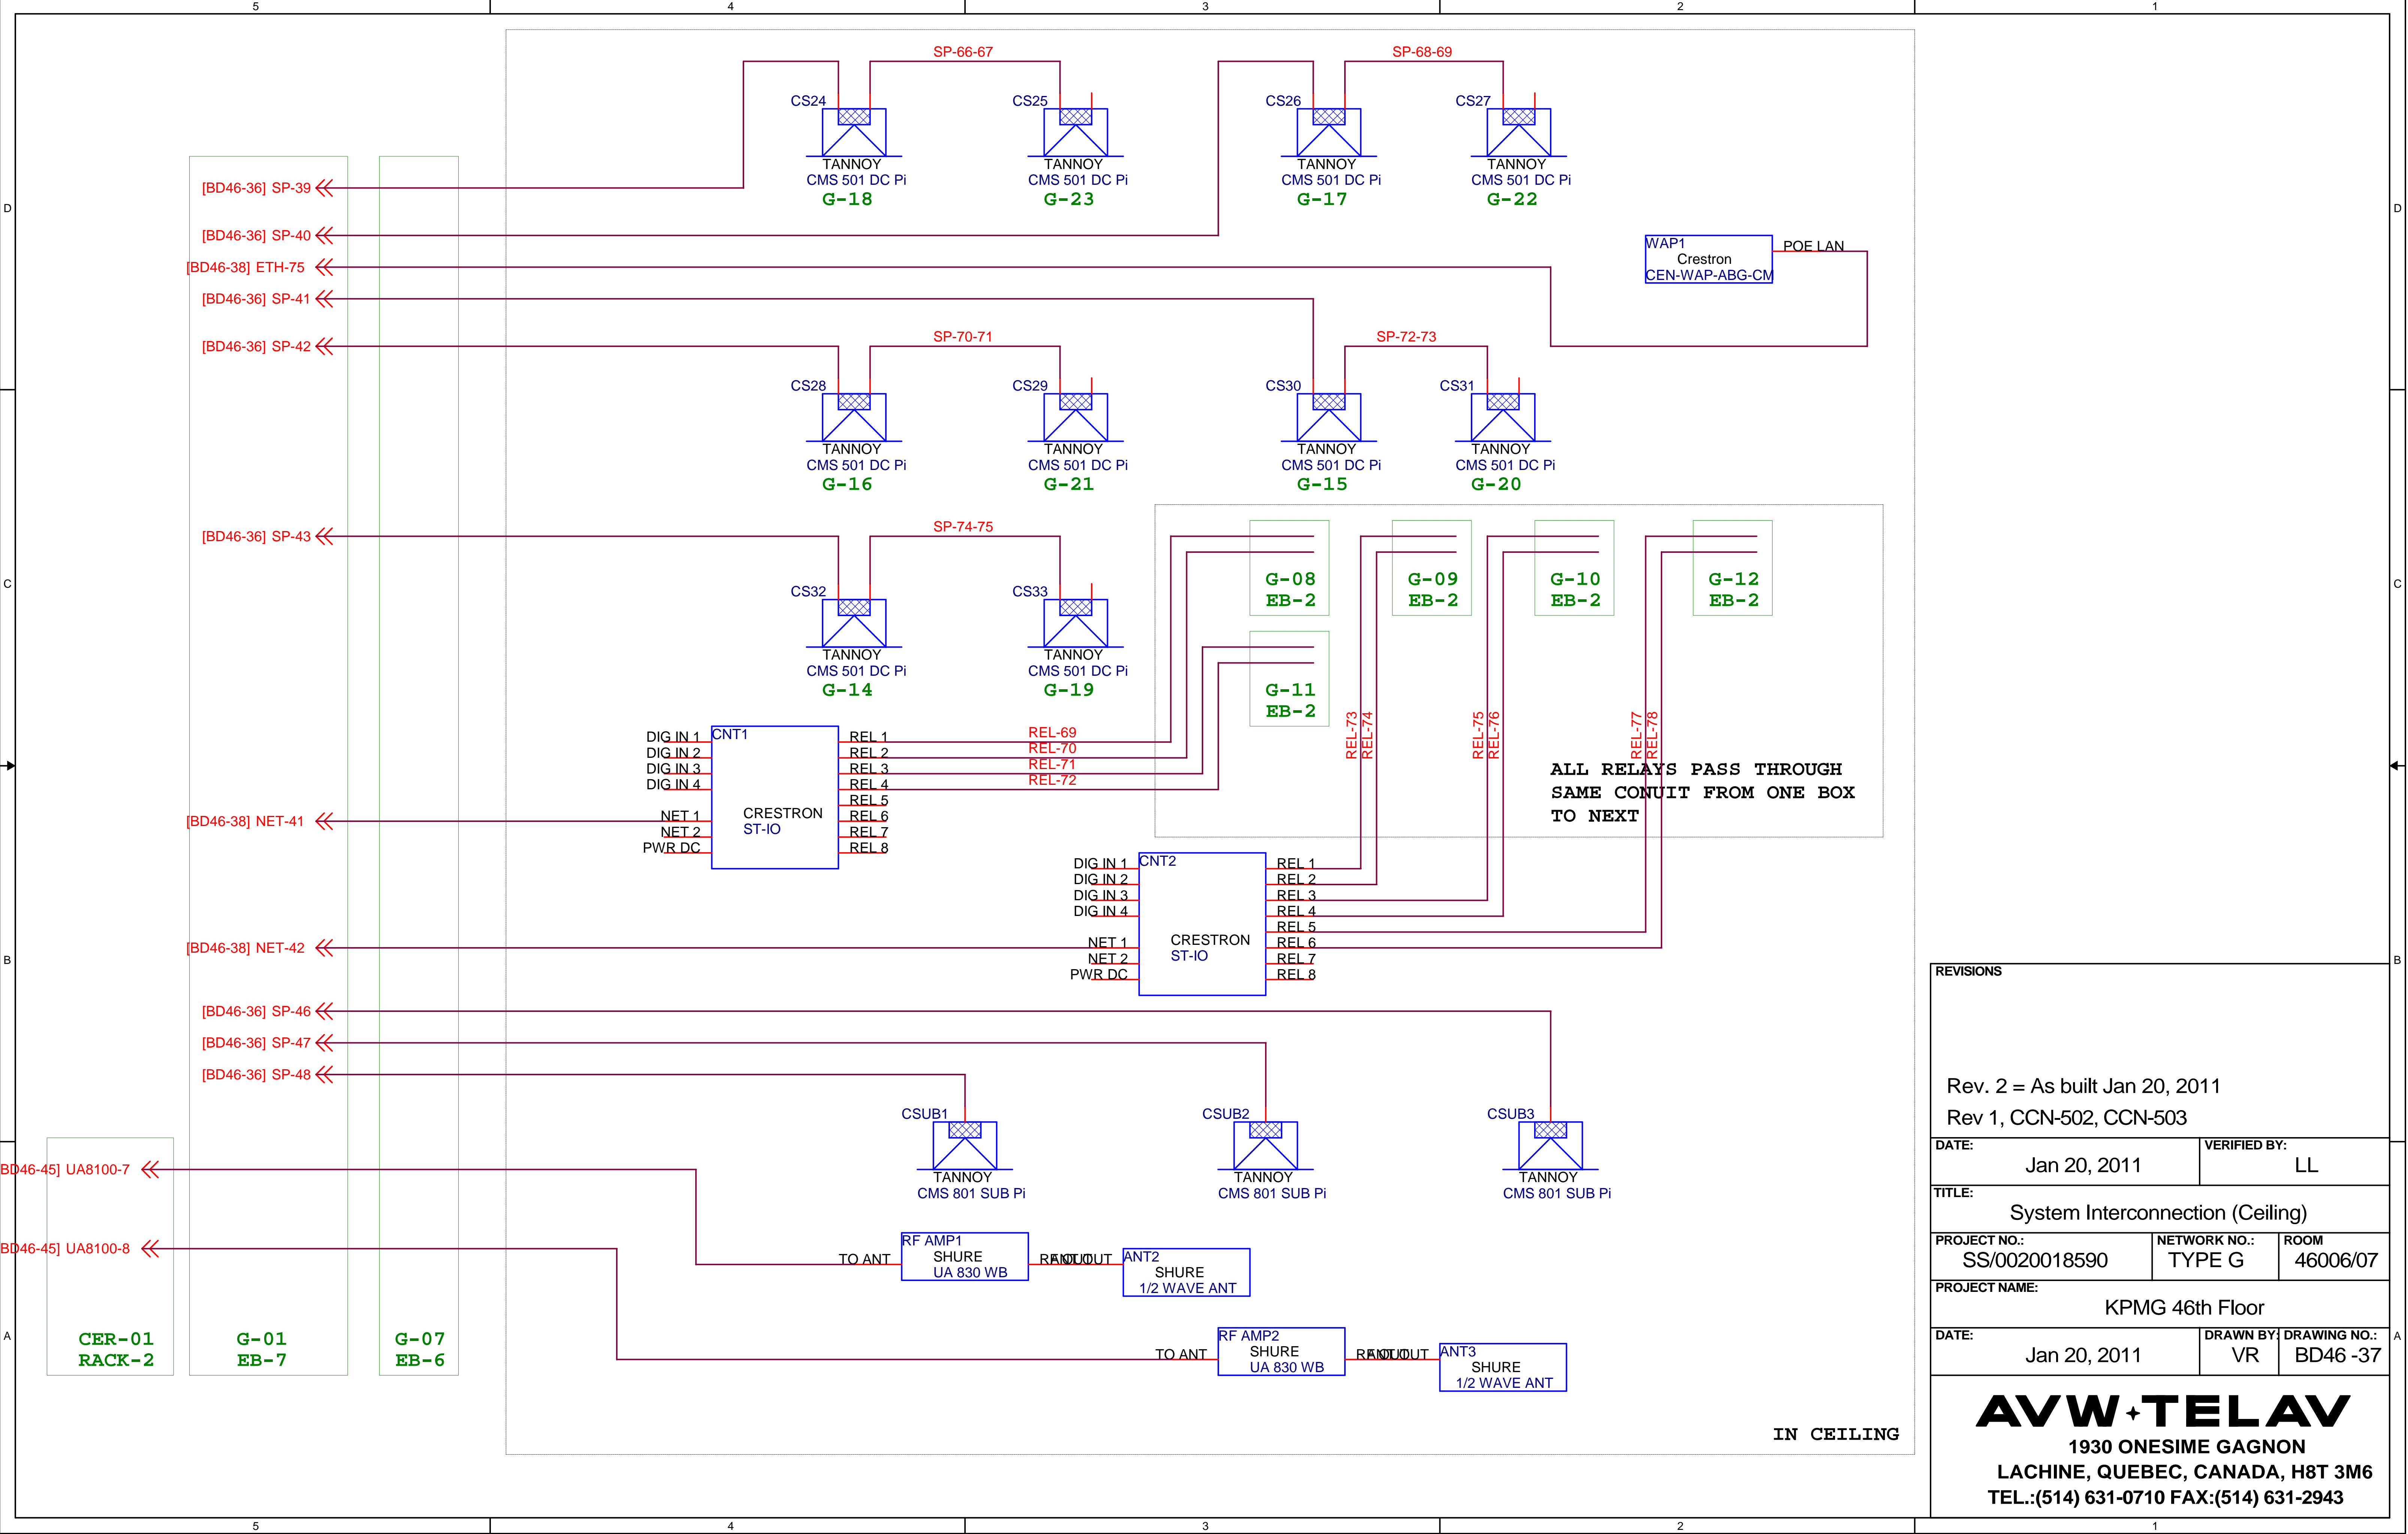


| REVISIONS | | |
|---|---------------|------------------------|
| Rev. 2 = As built Jan 20, 2011 Rev 1, CCN-502, CCN-503 | | |
| DATE: | Jan 20, 2011 | VERIFIED BY: LL |
| TITLE: System Interconnection (Ceiling) | | |
| PROJECT NO.: | SS/0020018590 | NETWORK NO.: TYPE G |
| PROJECT NAME: KPMG 46th Floor | | |
| DATE: | Jan 20, 2011 | DRAWN BY: VR |
| DRAWING NO.: BD46 -37 | | |
| AVW+TELAV 1930 ONESIME GAGNON LACHINE, QUEBEC, CANADA, H8T 3M6 TEL.:(514) 631-0710 FAX:(514) 631-2943 | | |

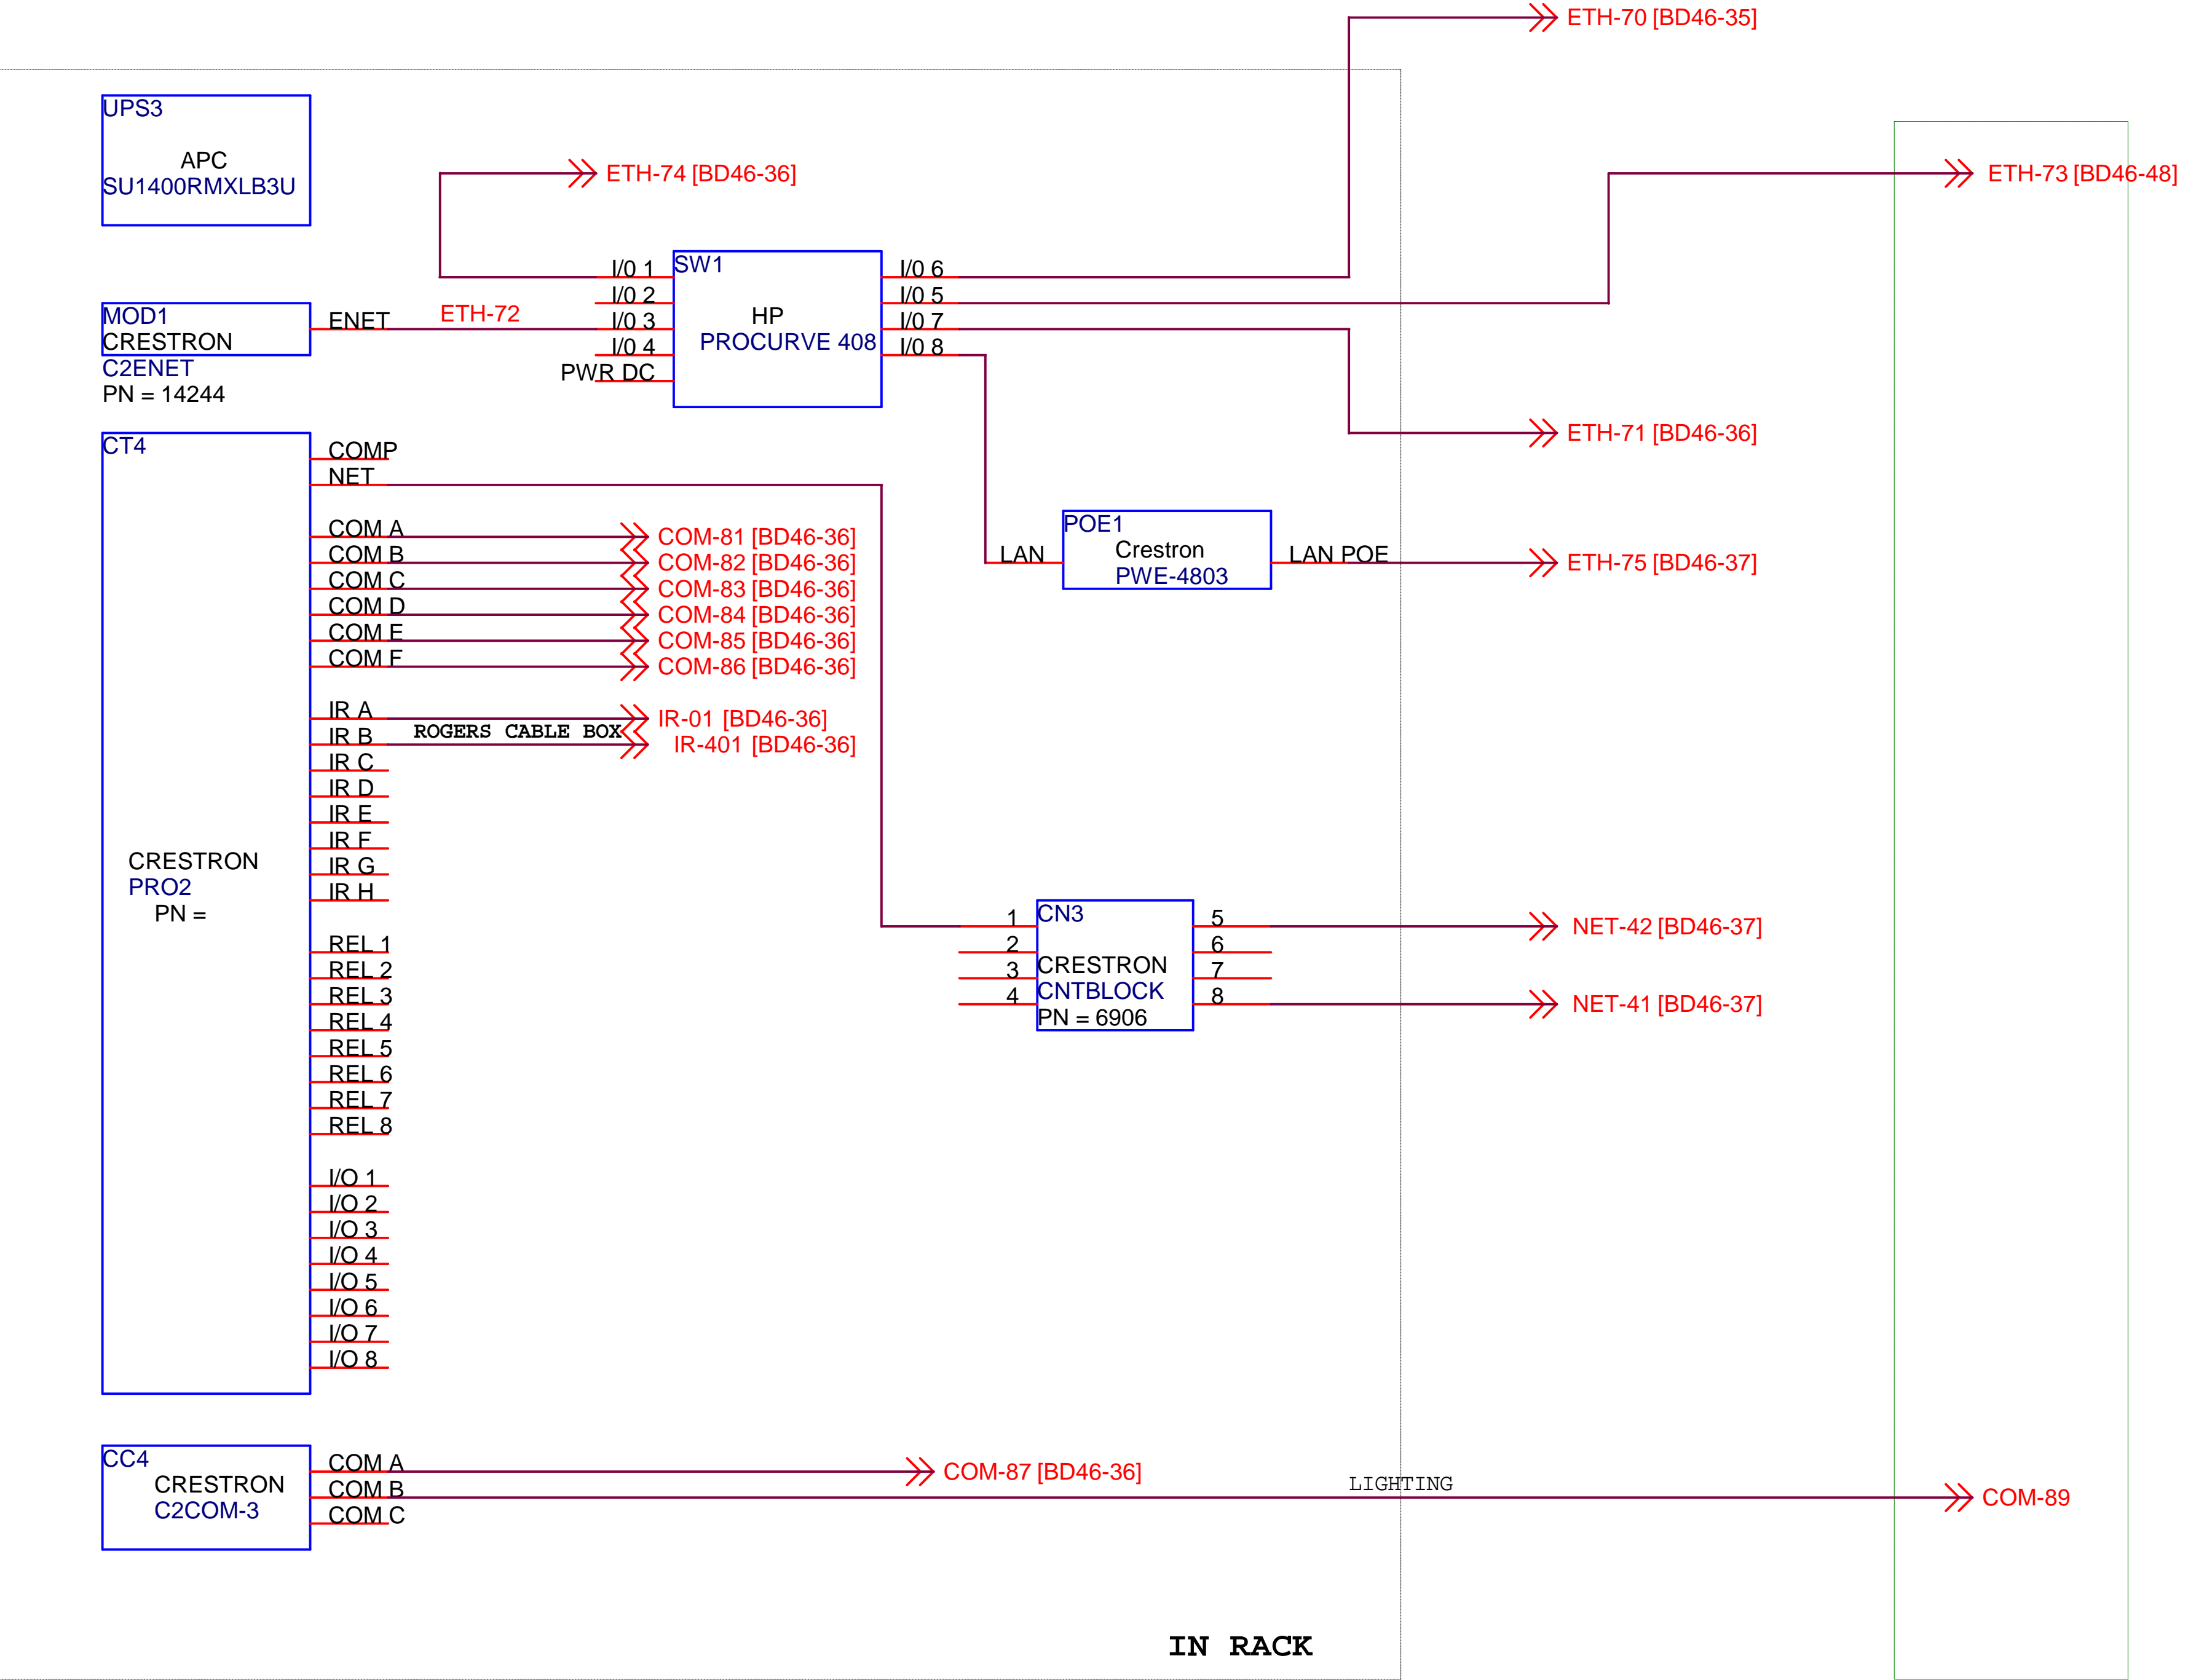


| REVISIONS | | |
|---|---------------|------------------------|
| Rev. 2 = As built Jan 20, 2011 Rev 1, CCN-502, CCN-503 | | |
| DATE: | Jan 20, 2011 | VERIFIED BY: LL |
| TITLE: System Interconnection (Ceiling) | | |
| PROJECT NO.: | SS/0020018590 | NETWORK NO.: TYPE G |
| PROJECT NAME: KPMG 46th Floor | | |
| DATE: | Jan 20, 2011 | DRAWN BY: VR |
| DRAWING NO.: BD46 -38 | | |
| AVW+TELAV 1930 ONESIME GAGNON LACHINE, QUEBEC, CANADA, H8T 3M6 TEL.:(514) 631-0710 FAX:(514) 631-2943 | | |

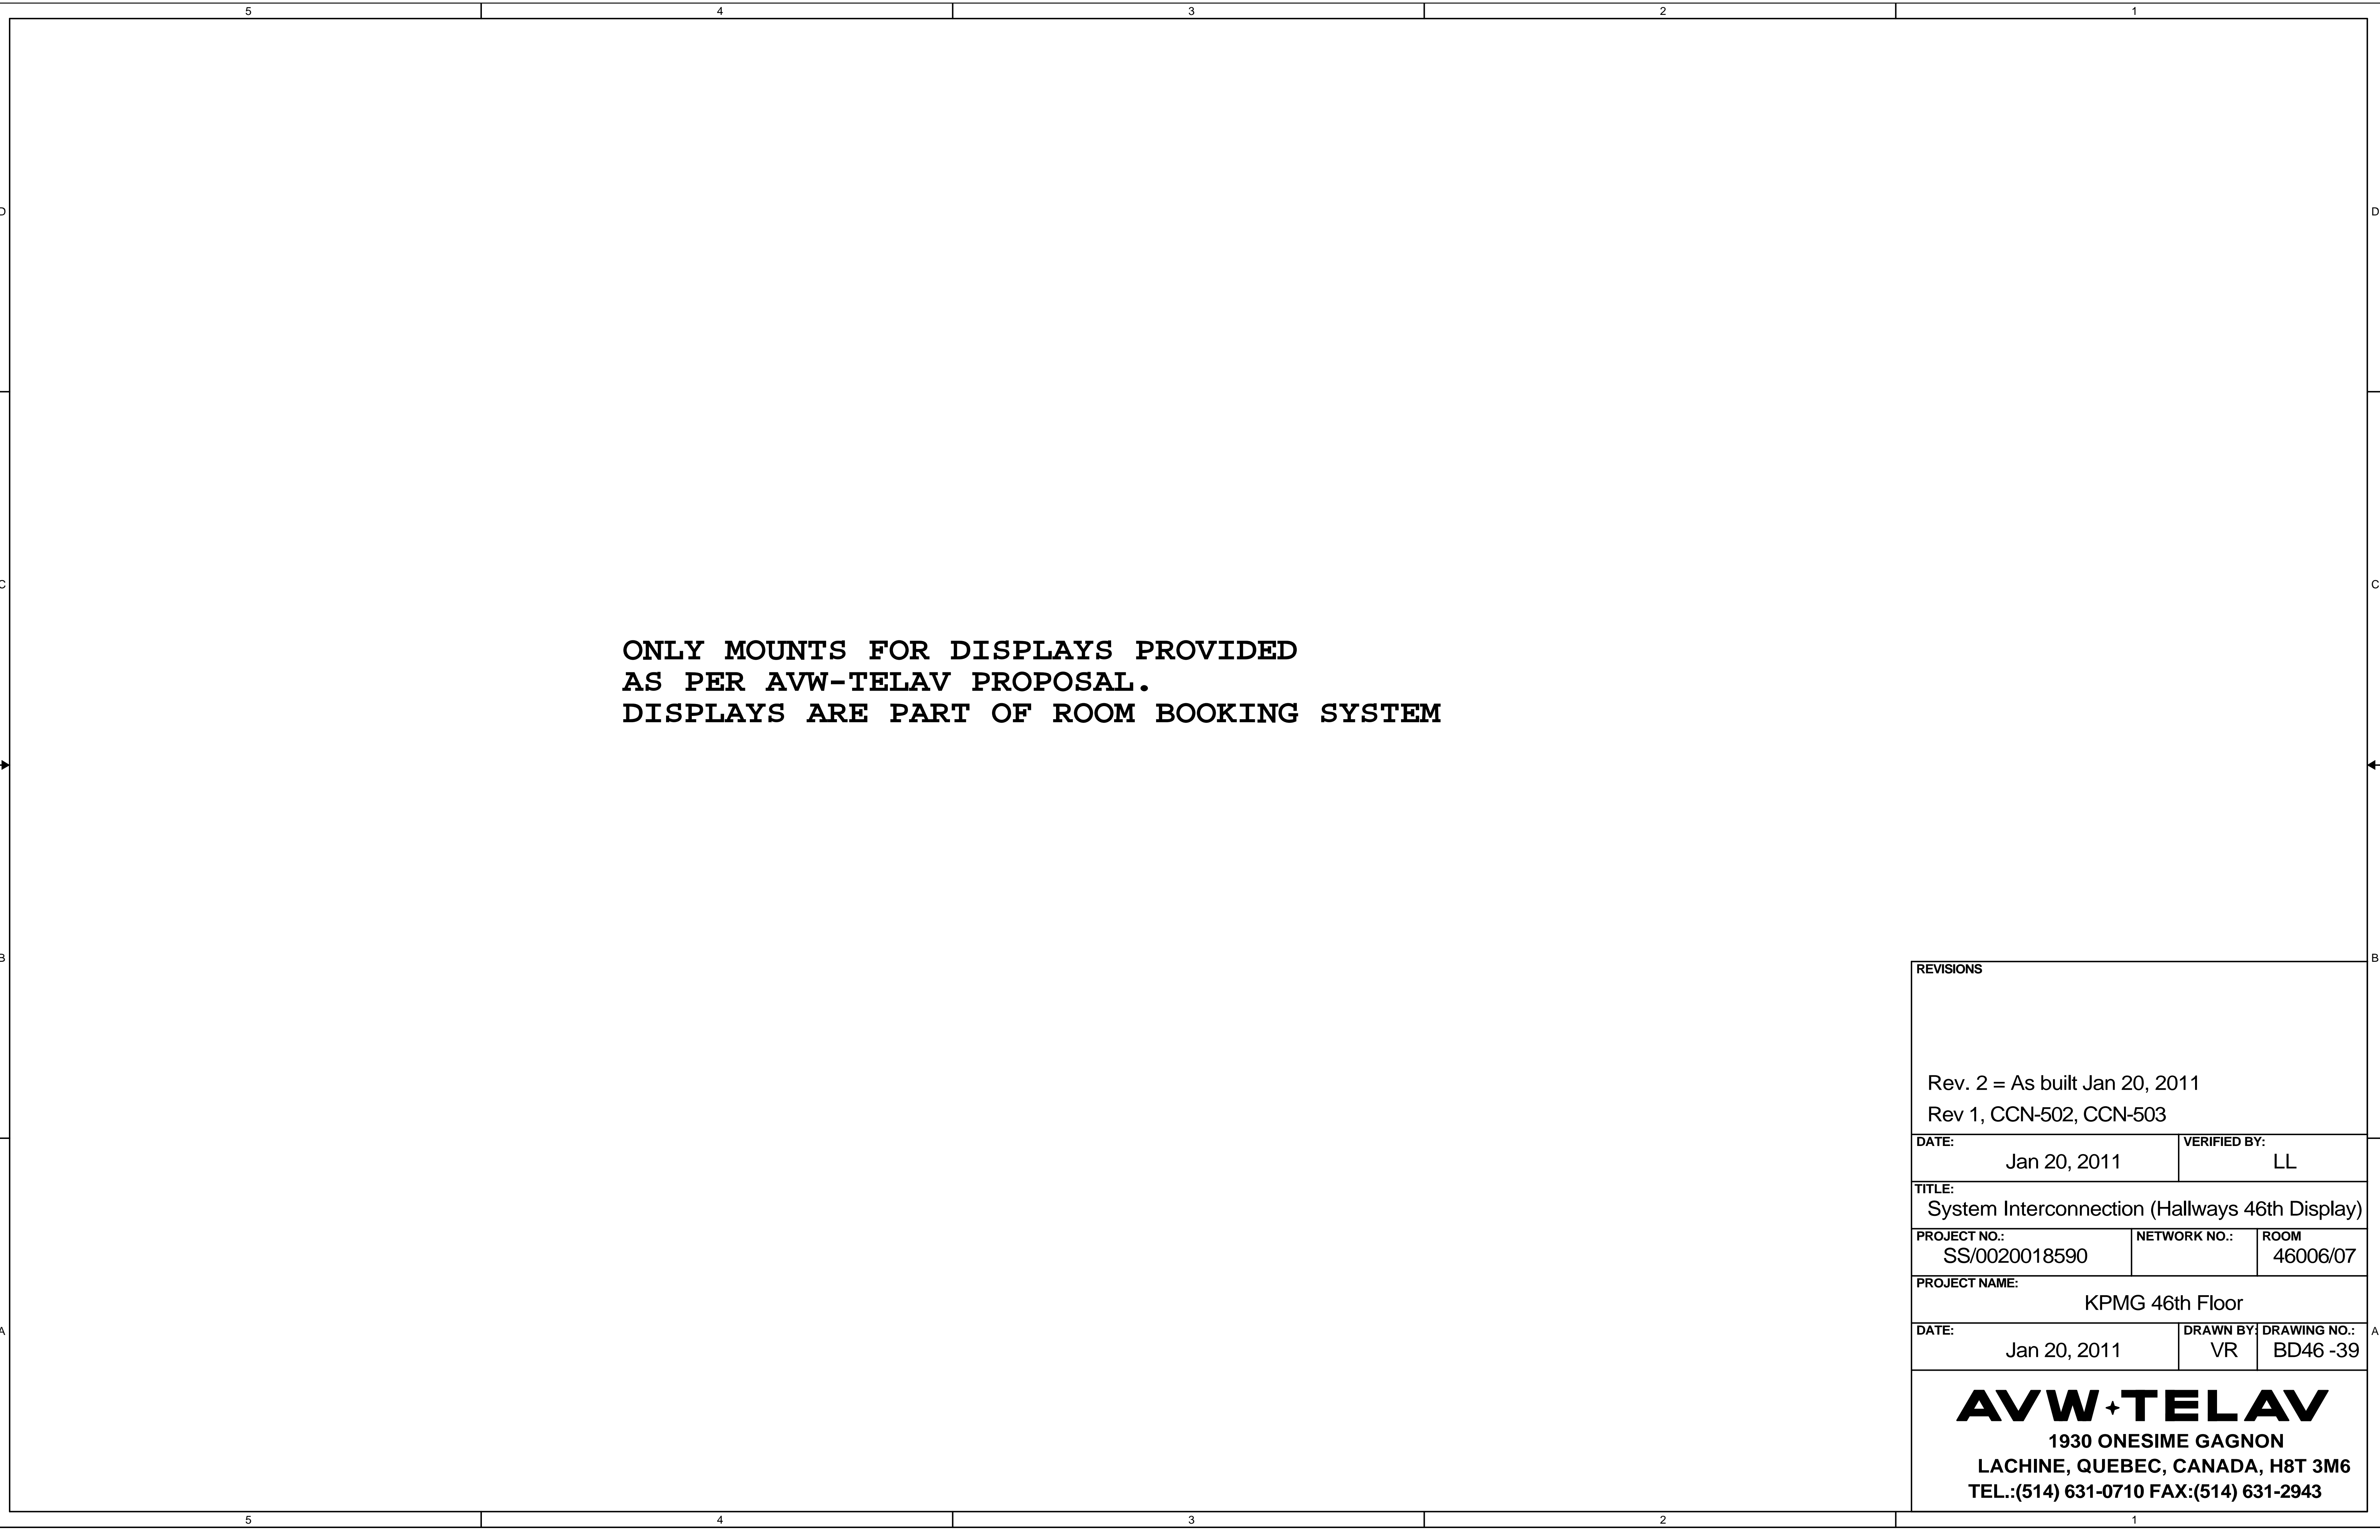

| | | |
|---|--|--------------------------|
| REVISIONS | | |
| Rev. 2 = As built Jan 20, 2011 Rev 1, CCN-502, CCN-503 | | |
| DATE: | Jan 20, 2011 | VERIFIED BY: LL |
| TITLE: | System Interconnection (Hallways 46th Display) | |
| PROJECT NO.: | SS/0020018590 | ROOM 46006/07 |
| PROJECT NAME: | KPMG 46th Floor | |
| DATE: | Jan 20, 2011 | DRAWN BY: VR |
| | | DRAWING NO.: BD46 -39 |
| <div>AVW+TELAV</div> <div>1930 ONESIME GAGNON</div> <div>LACHINE, QUEBEC, CANADA, H8T 3M6</div> <div>TEL.:(514) 631-0710 FAX:(514) 631-2943</div> | | |

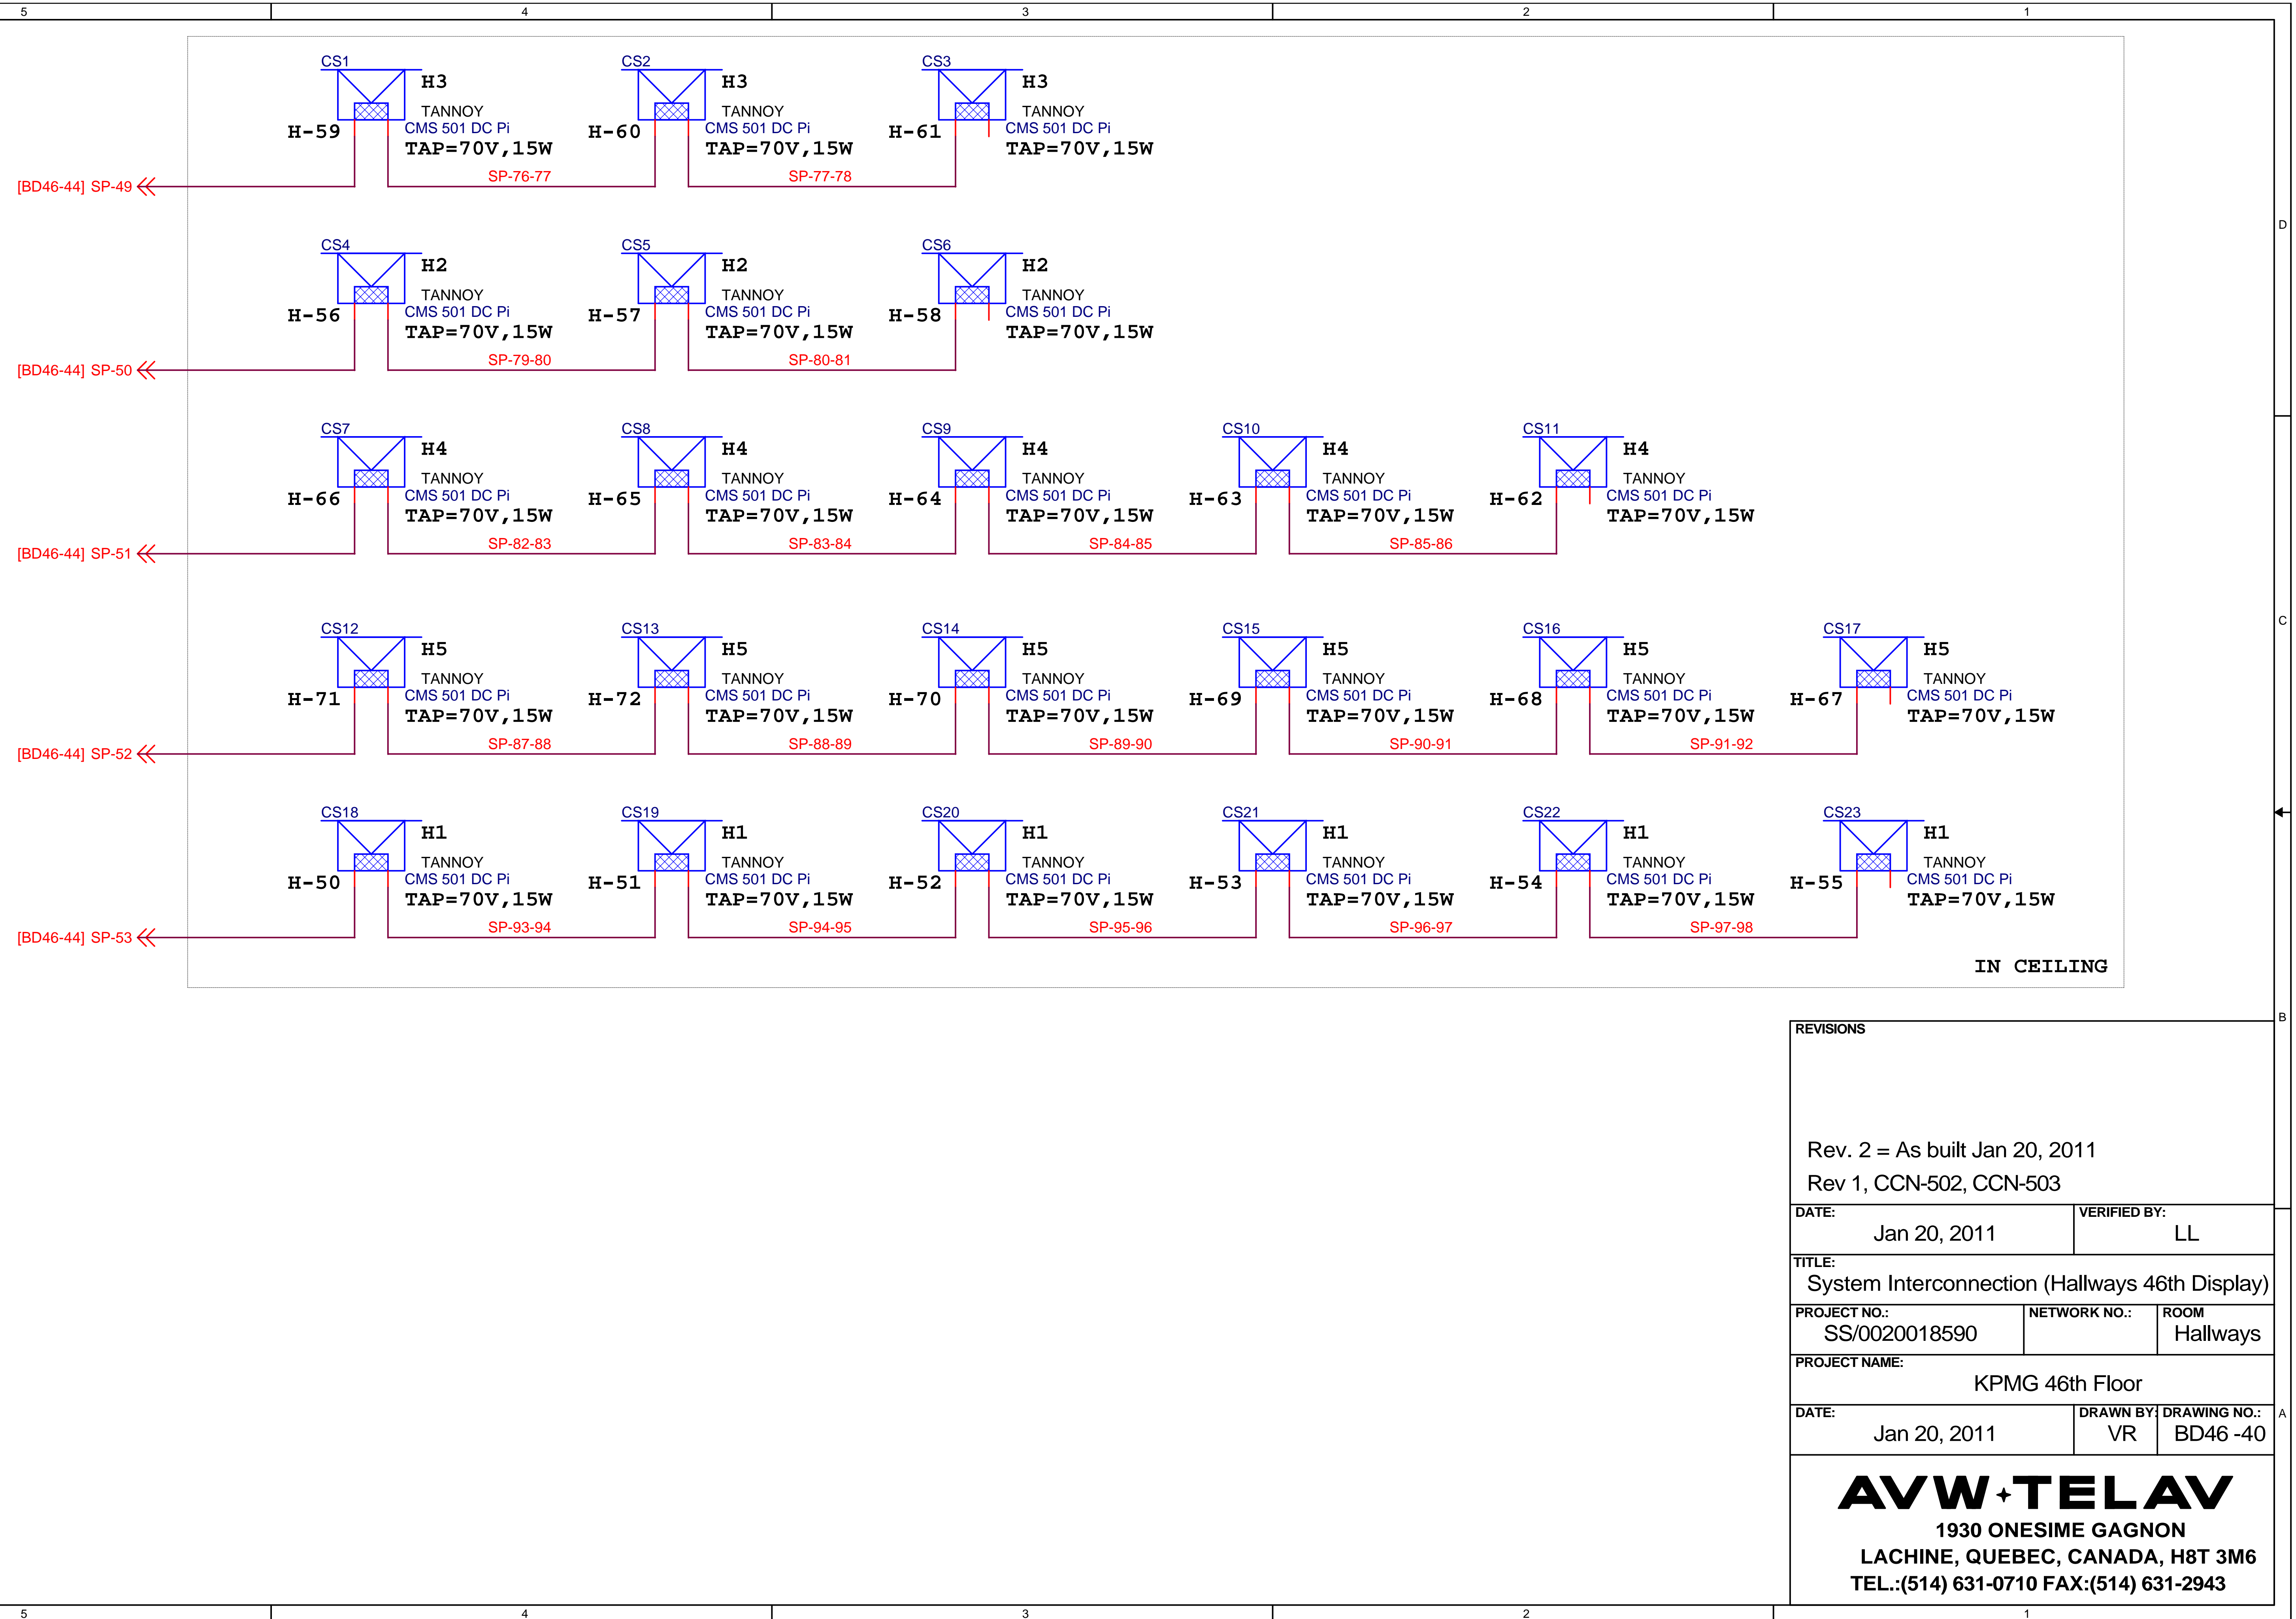


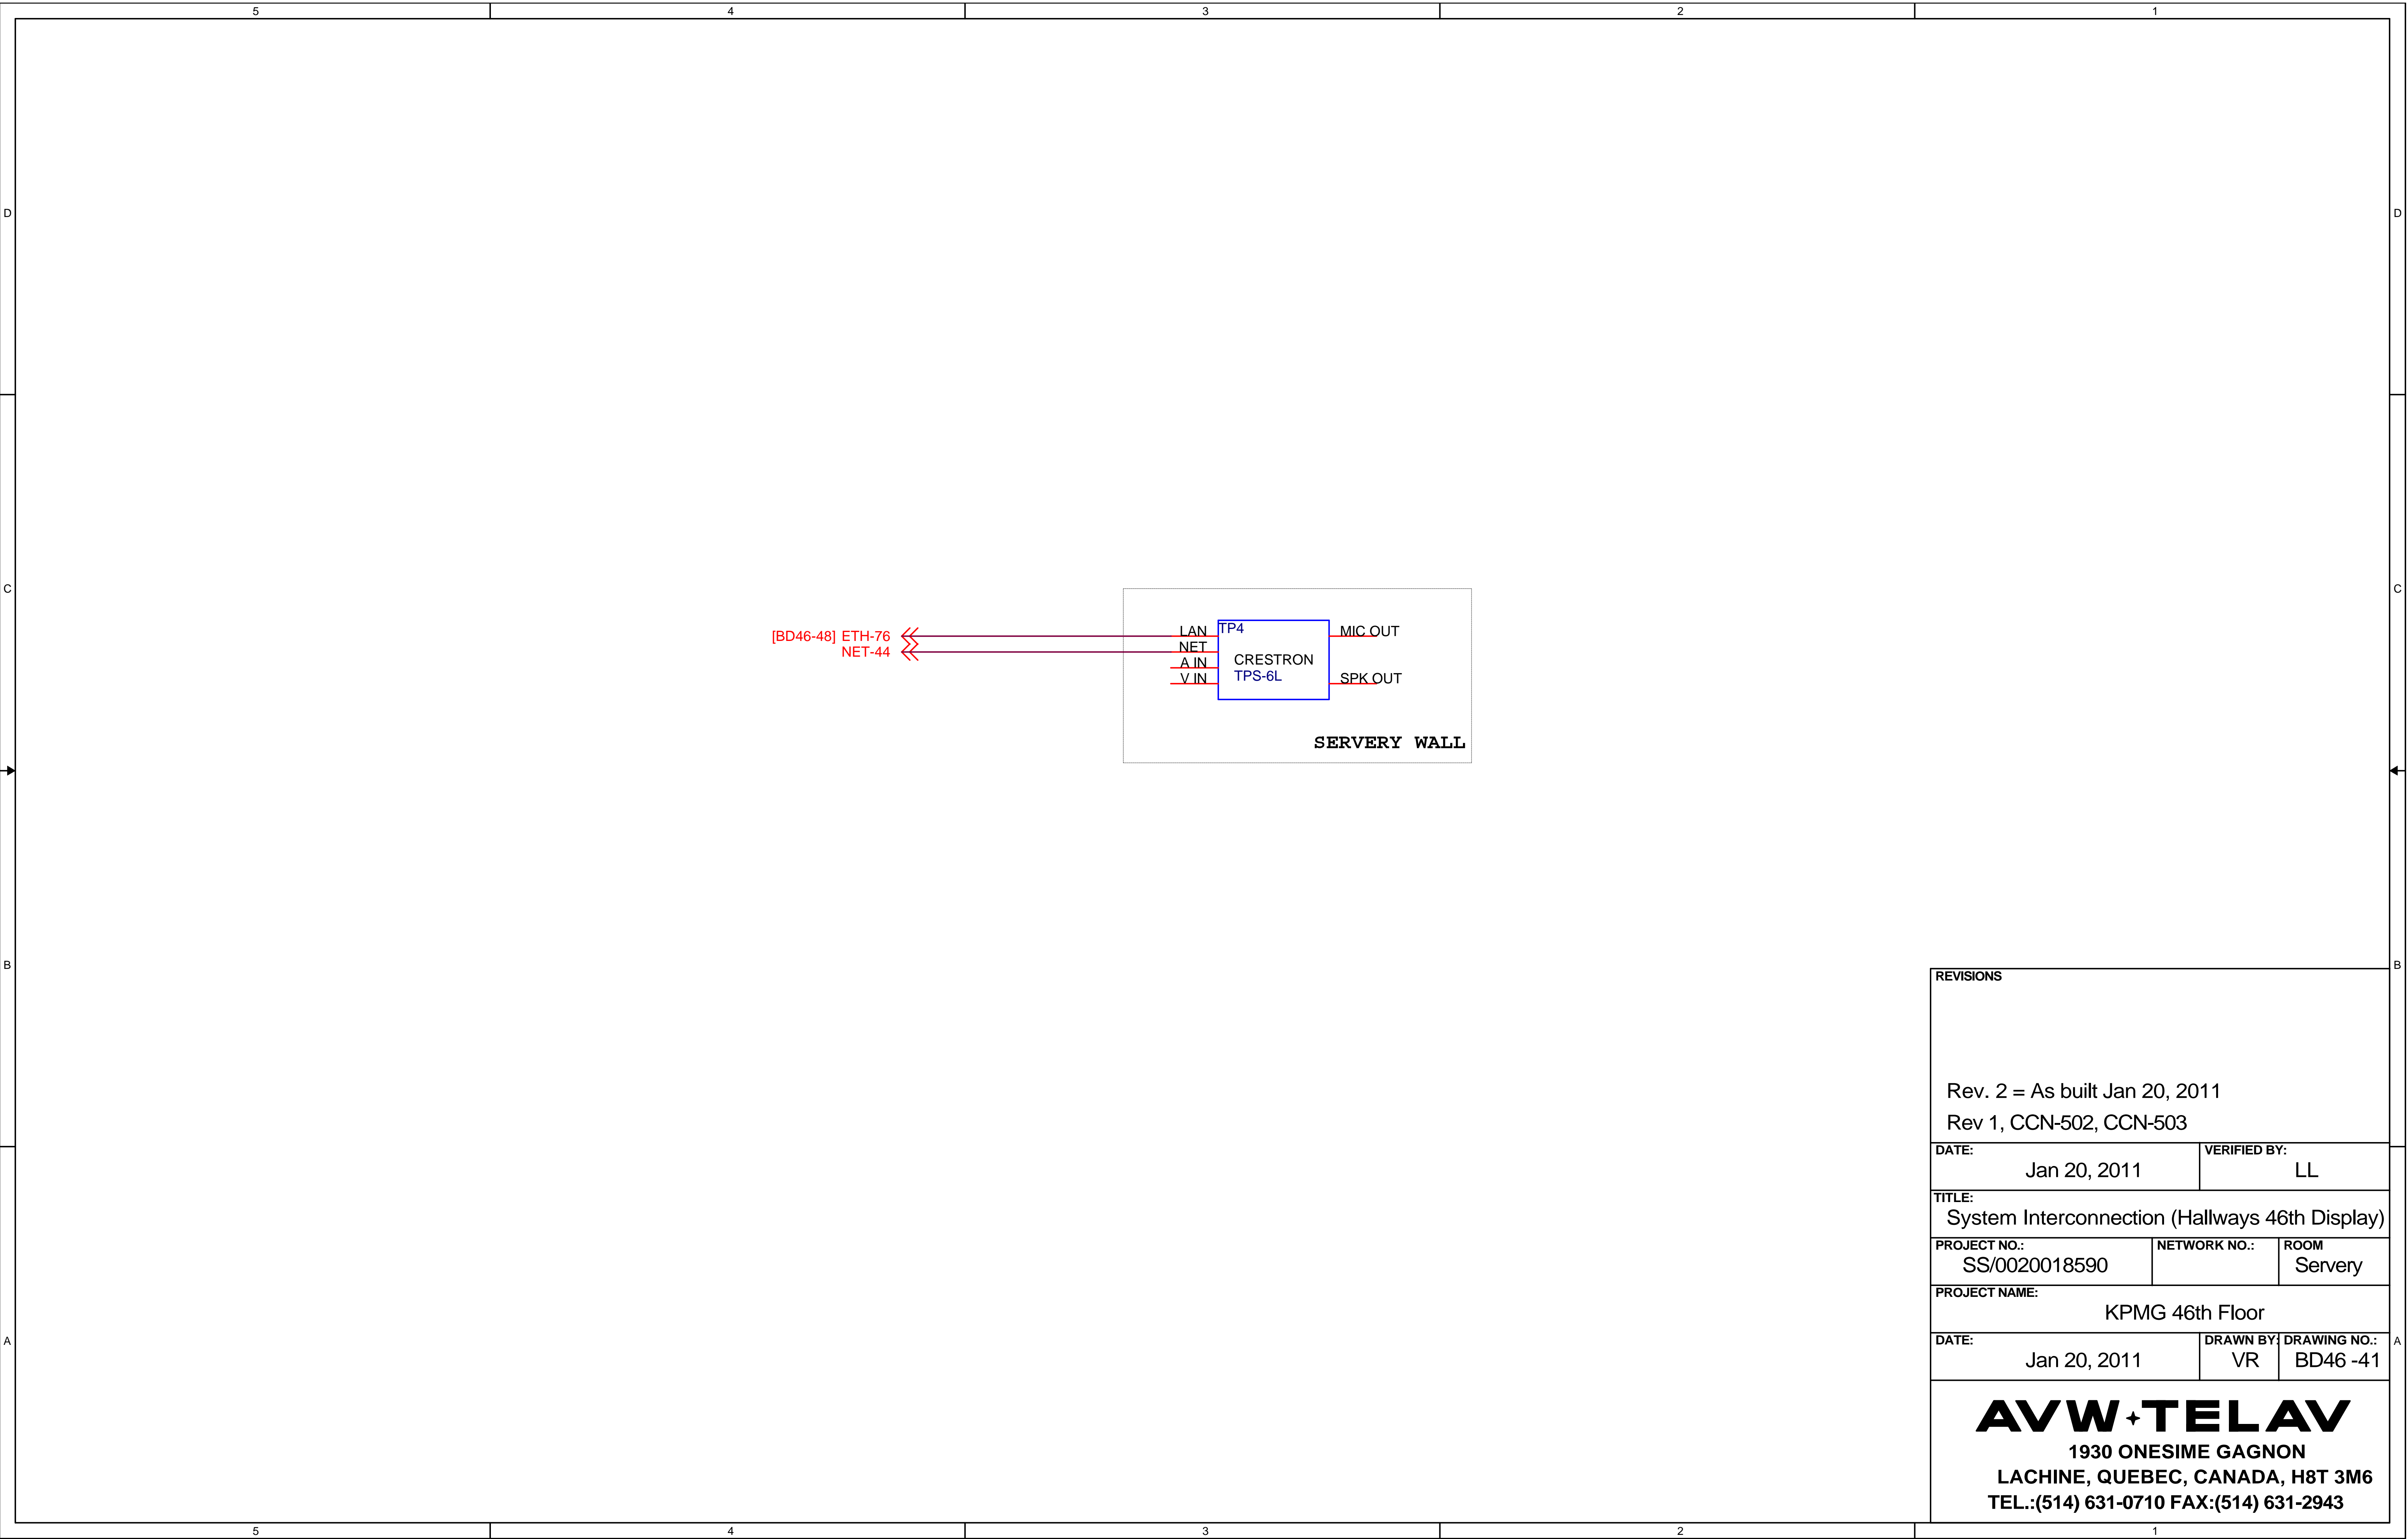


[BD46-48] ETH-76


NET-44

| | | |
|---|--|---------------------------------------|
| REVISIONS | | |
| Rev. 2 = As built Jan 20, 2011 | | |
| Rev 1, CCN-502, CCN-503 | | |
| DATE: | Jan 20, 2011 | VERIFIED BY: LL |
| TITLE: | System Interconnection (Hallways 46th Display) | |
| PROJECT NO.: | SS/0020018590 | ROOM Servery |
| PROJECT NAME: | KPMG 46th Floor | |
| DATE: | Jan 20, 2011 | DRAWN BY: VR DRAWING NO.: BD46 -41 |
| <div>AVW+TELAV</div> <div>1930 ONESIME GAGNON</div> <div>LACHINE, QUEBEC, CANADA, H8T 3M6</div> <div>TEL.:(514) 631-0710 FAX:(514) 631-2943</div> | | |

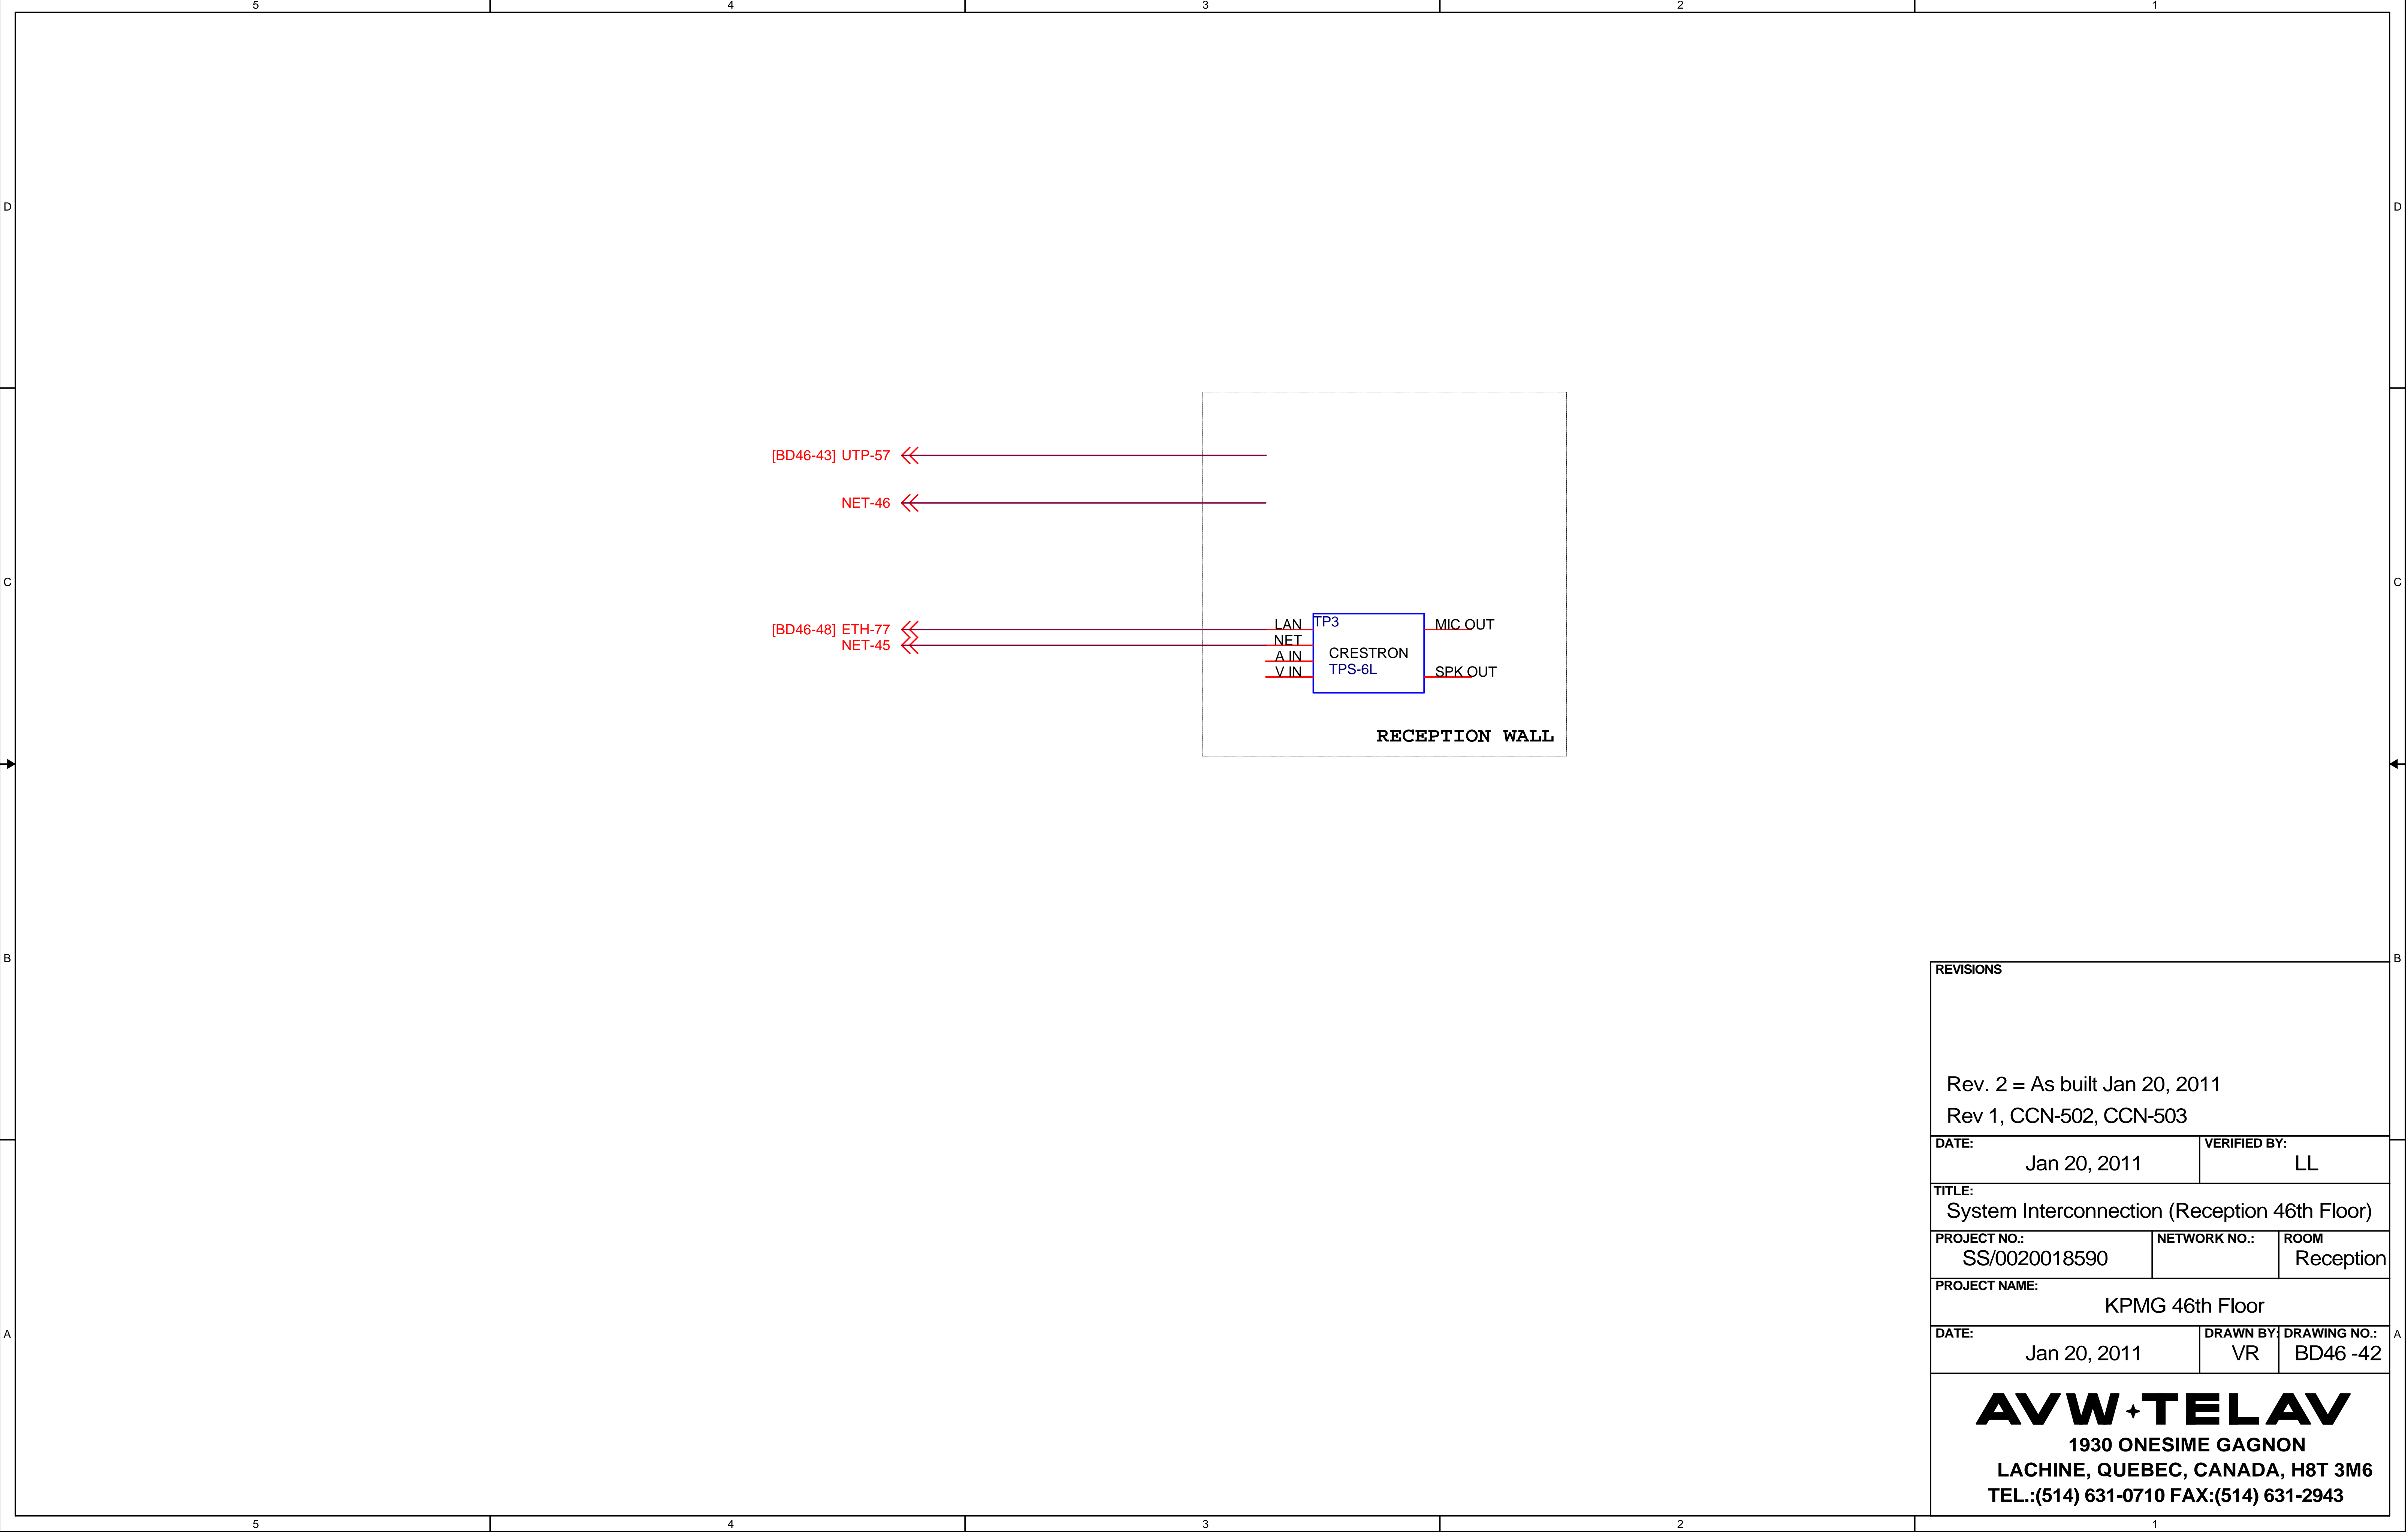

| | | |
|---|---------------|-----------------------------------|
| REVISIONS | | |
| Rev. 2 = As built Jan 20, 2011 Rev 1, CCN-502, CCN-503 | | |
| DATE: | Jan 20, 2011 | VERIFIED BY: LL |
| TITLE: System Interconnection (Reception 46th Floor) | | |
| PROJECT NO.: | SS/0020018590 | NETWORK NO.: ROOM Reception |
| PROJECT NAME: KPMG 46th Floor | | |
| DATE: | Jan 20, 2011 | DRAWN BY: VR |
| | | DRAWING NO.: BD46 -42 |
| <div>AVW+TELAV</div> <div>1930 ONESIME GAGNON</div> <div>LACHINE, QUEBEC, CANADA, H8T 3M6</div> <div>TEL.:(514) 631-0710 FAX:(514) 631-2943</div> | | |

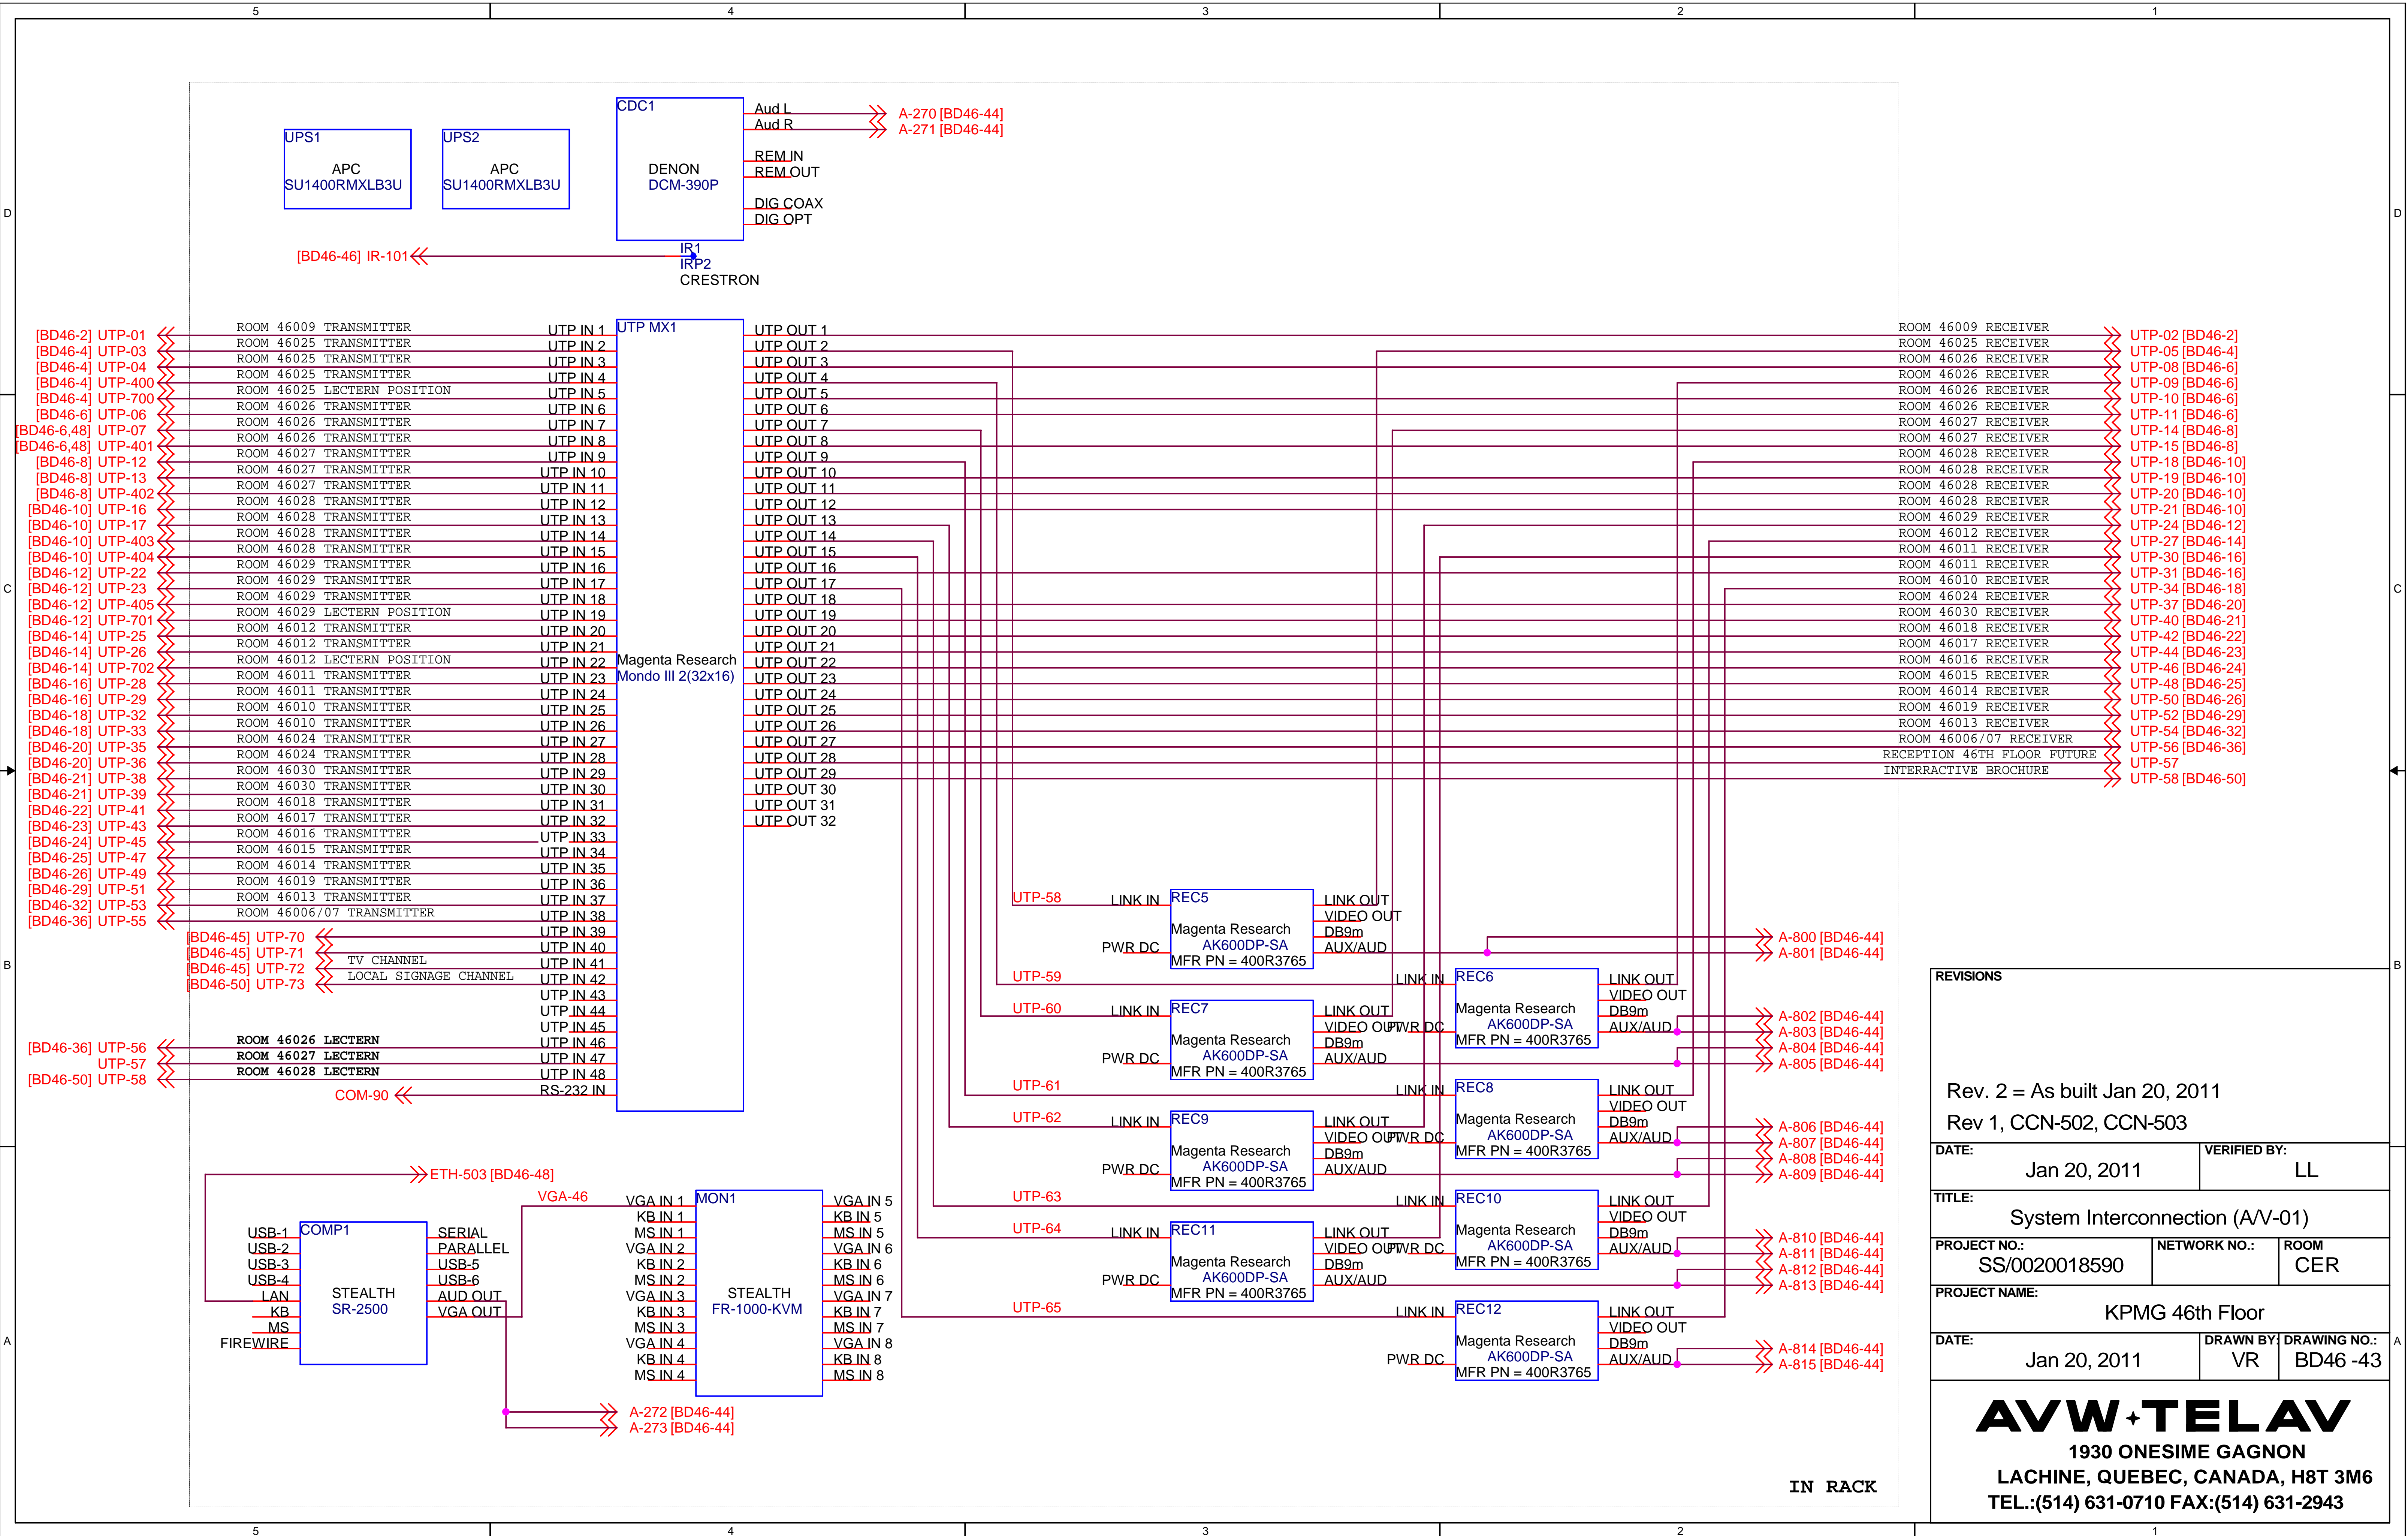


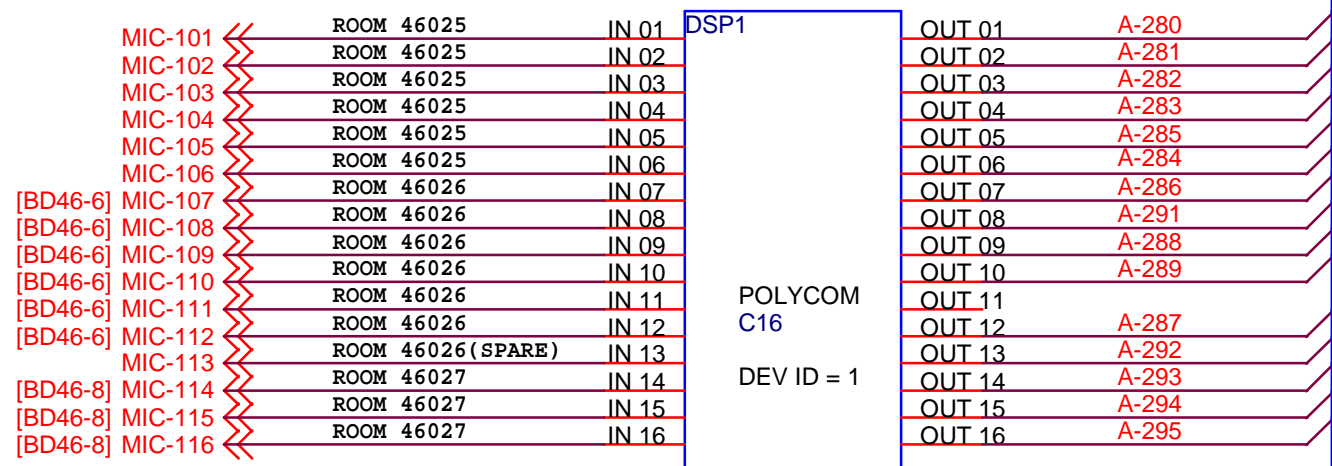

[BD46-48] LAN-80 << LAN

REM 1
C-LINK 1
OBAM IN


TEL 1 >> PSTN1
TEL 2 >> 2200-35004-001
POLYCOM PSTN

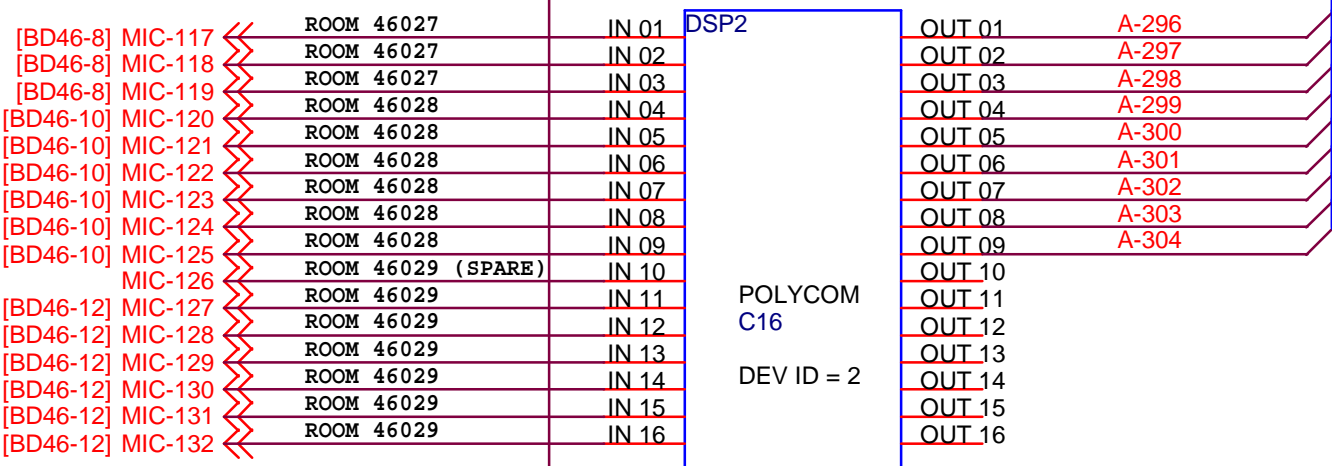

LAN

REM 1
C-LINK 1
OBAM IN


TEL 1 >> PSTN2
TEL 2 >> 2200-35004-001
POLYCOM PSTN

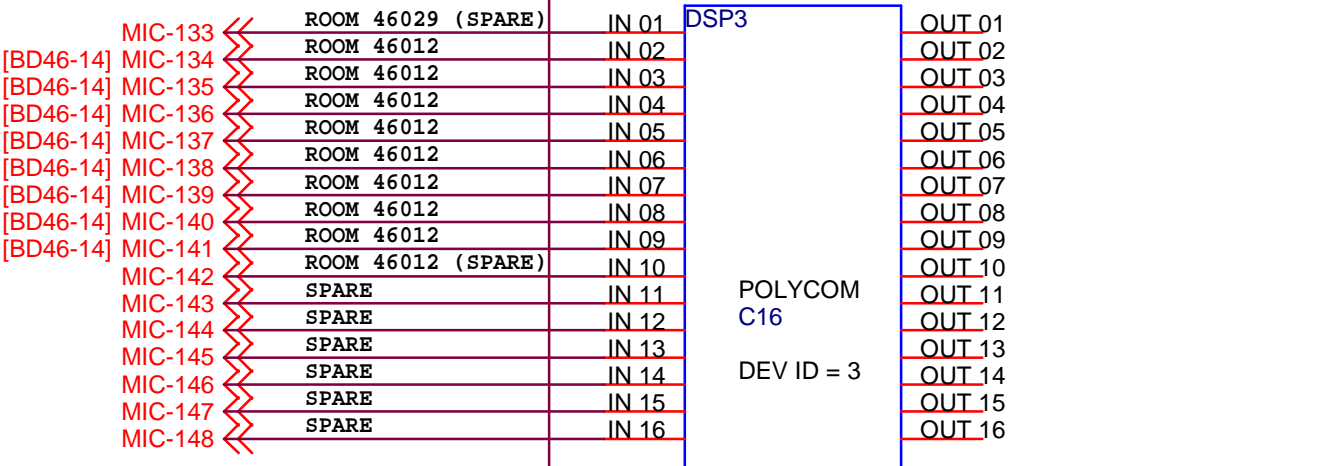

LAN

REM 1
C-LINK 1
OBAM IN


TEL 1 >> PSTN3
TEL 2 >> 2200-35004-001
POLYCOM PSTN

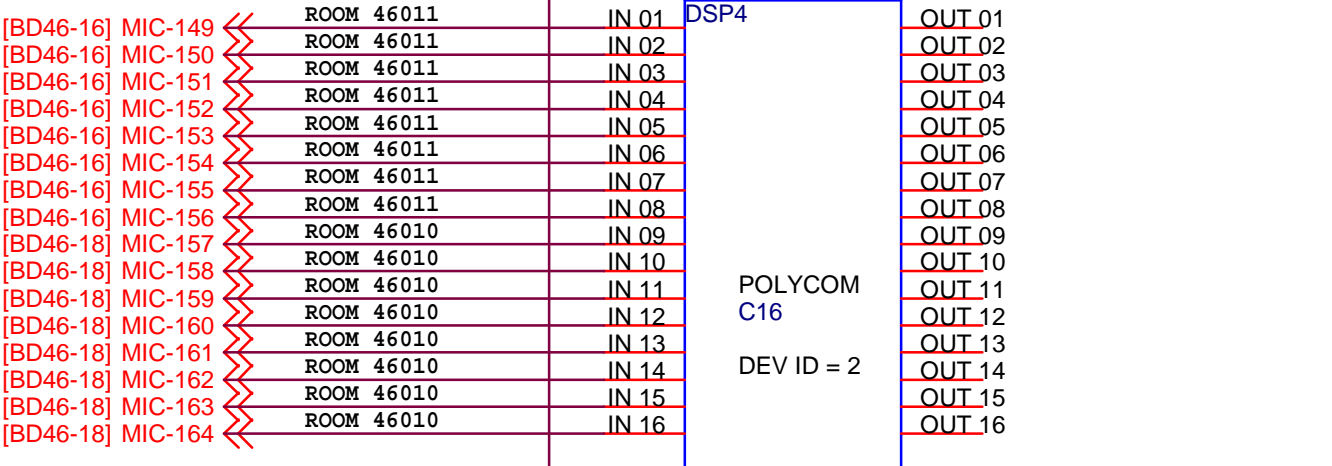

LAN

REM 1
C-LINK 1
OBAM IN


TEL 1 >> PSTN4
TEL 2 >> 2200-35004-001
POLYCOM PSTN

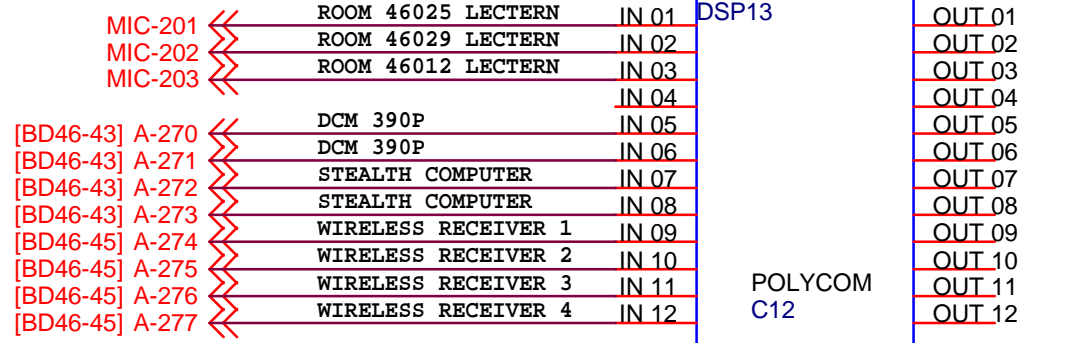

LAN

REM 1
C-LINK 1
OBAM IN


TEL 1 >> PSTN5
TEL 2 >> 2200-35004-001
POLYCOM PSTN

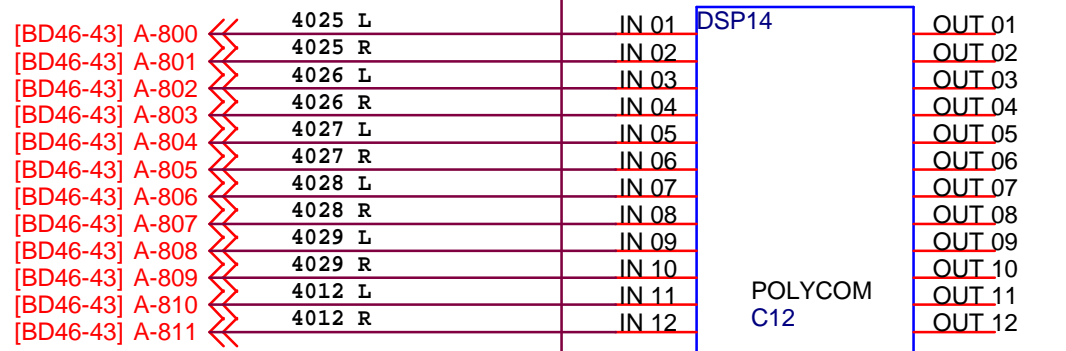

LAN

REM 1
C-LINK 1
OBAM IN


TEL 1 >> PSTN6
TEL 2 >> 2200-35004-001
POLYCOM PSTN

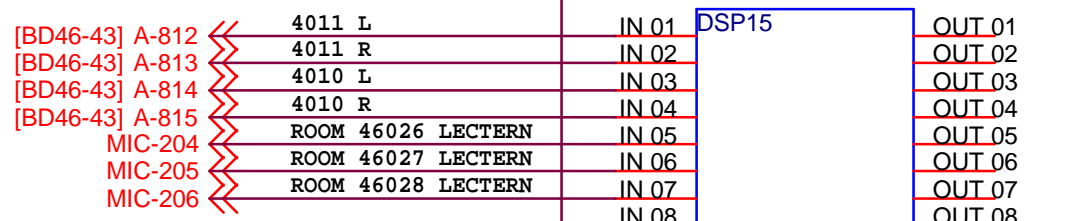


LAN

REM 1
C-LINK 1
OBAM IN


TEL 1 >> PSTN7
TEL 2 >> 2200-35004-001
POLYCOM PSTN

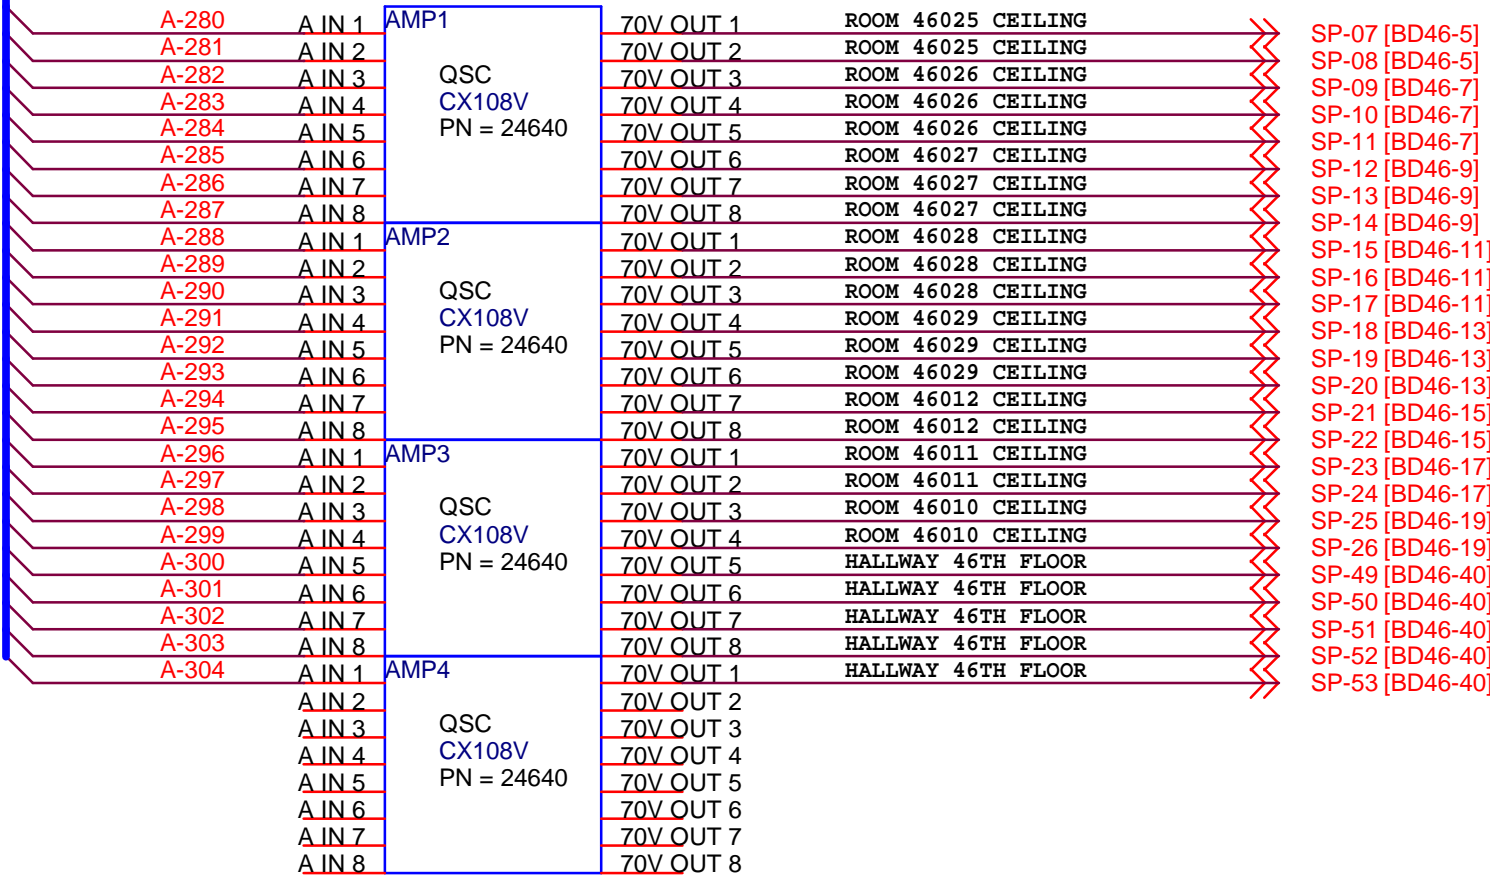


| REVISIONS | | | |
|--|---------------|--------------|----------|
| Rev. 2 = As built Jan 20, 2011 | | | |
| Rev 1, CCN-502, CCN-503 | | | |
| DATE: | Jan 20, 2011 | VERIFIED BY: | LL |
| TITLE: | | | |
| System Interconnection (A/V-01) | | | |
| PROJECT NO.: | SS/0020018590 | NETWORK NO.: | ROOM CER |
| PROJECT NAME: | | | |
| KPMG 46th Floor | | | |
| DATE: | Jan 20, 2011 | DRAWN BY: | VR |
| | | DRAWING NO.: | BD46 -44 |
| AVW+TELAV | | | |
| 1930 ONESIME GAGNON | | | |
| LACHINE, QUEBEC, CANADA, H8T 3M6 | | | |
| TEL.:(514) 631-0710 FAX:(514) 631-2943 | | | |

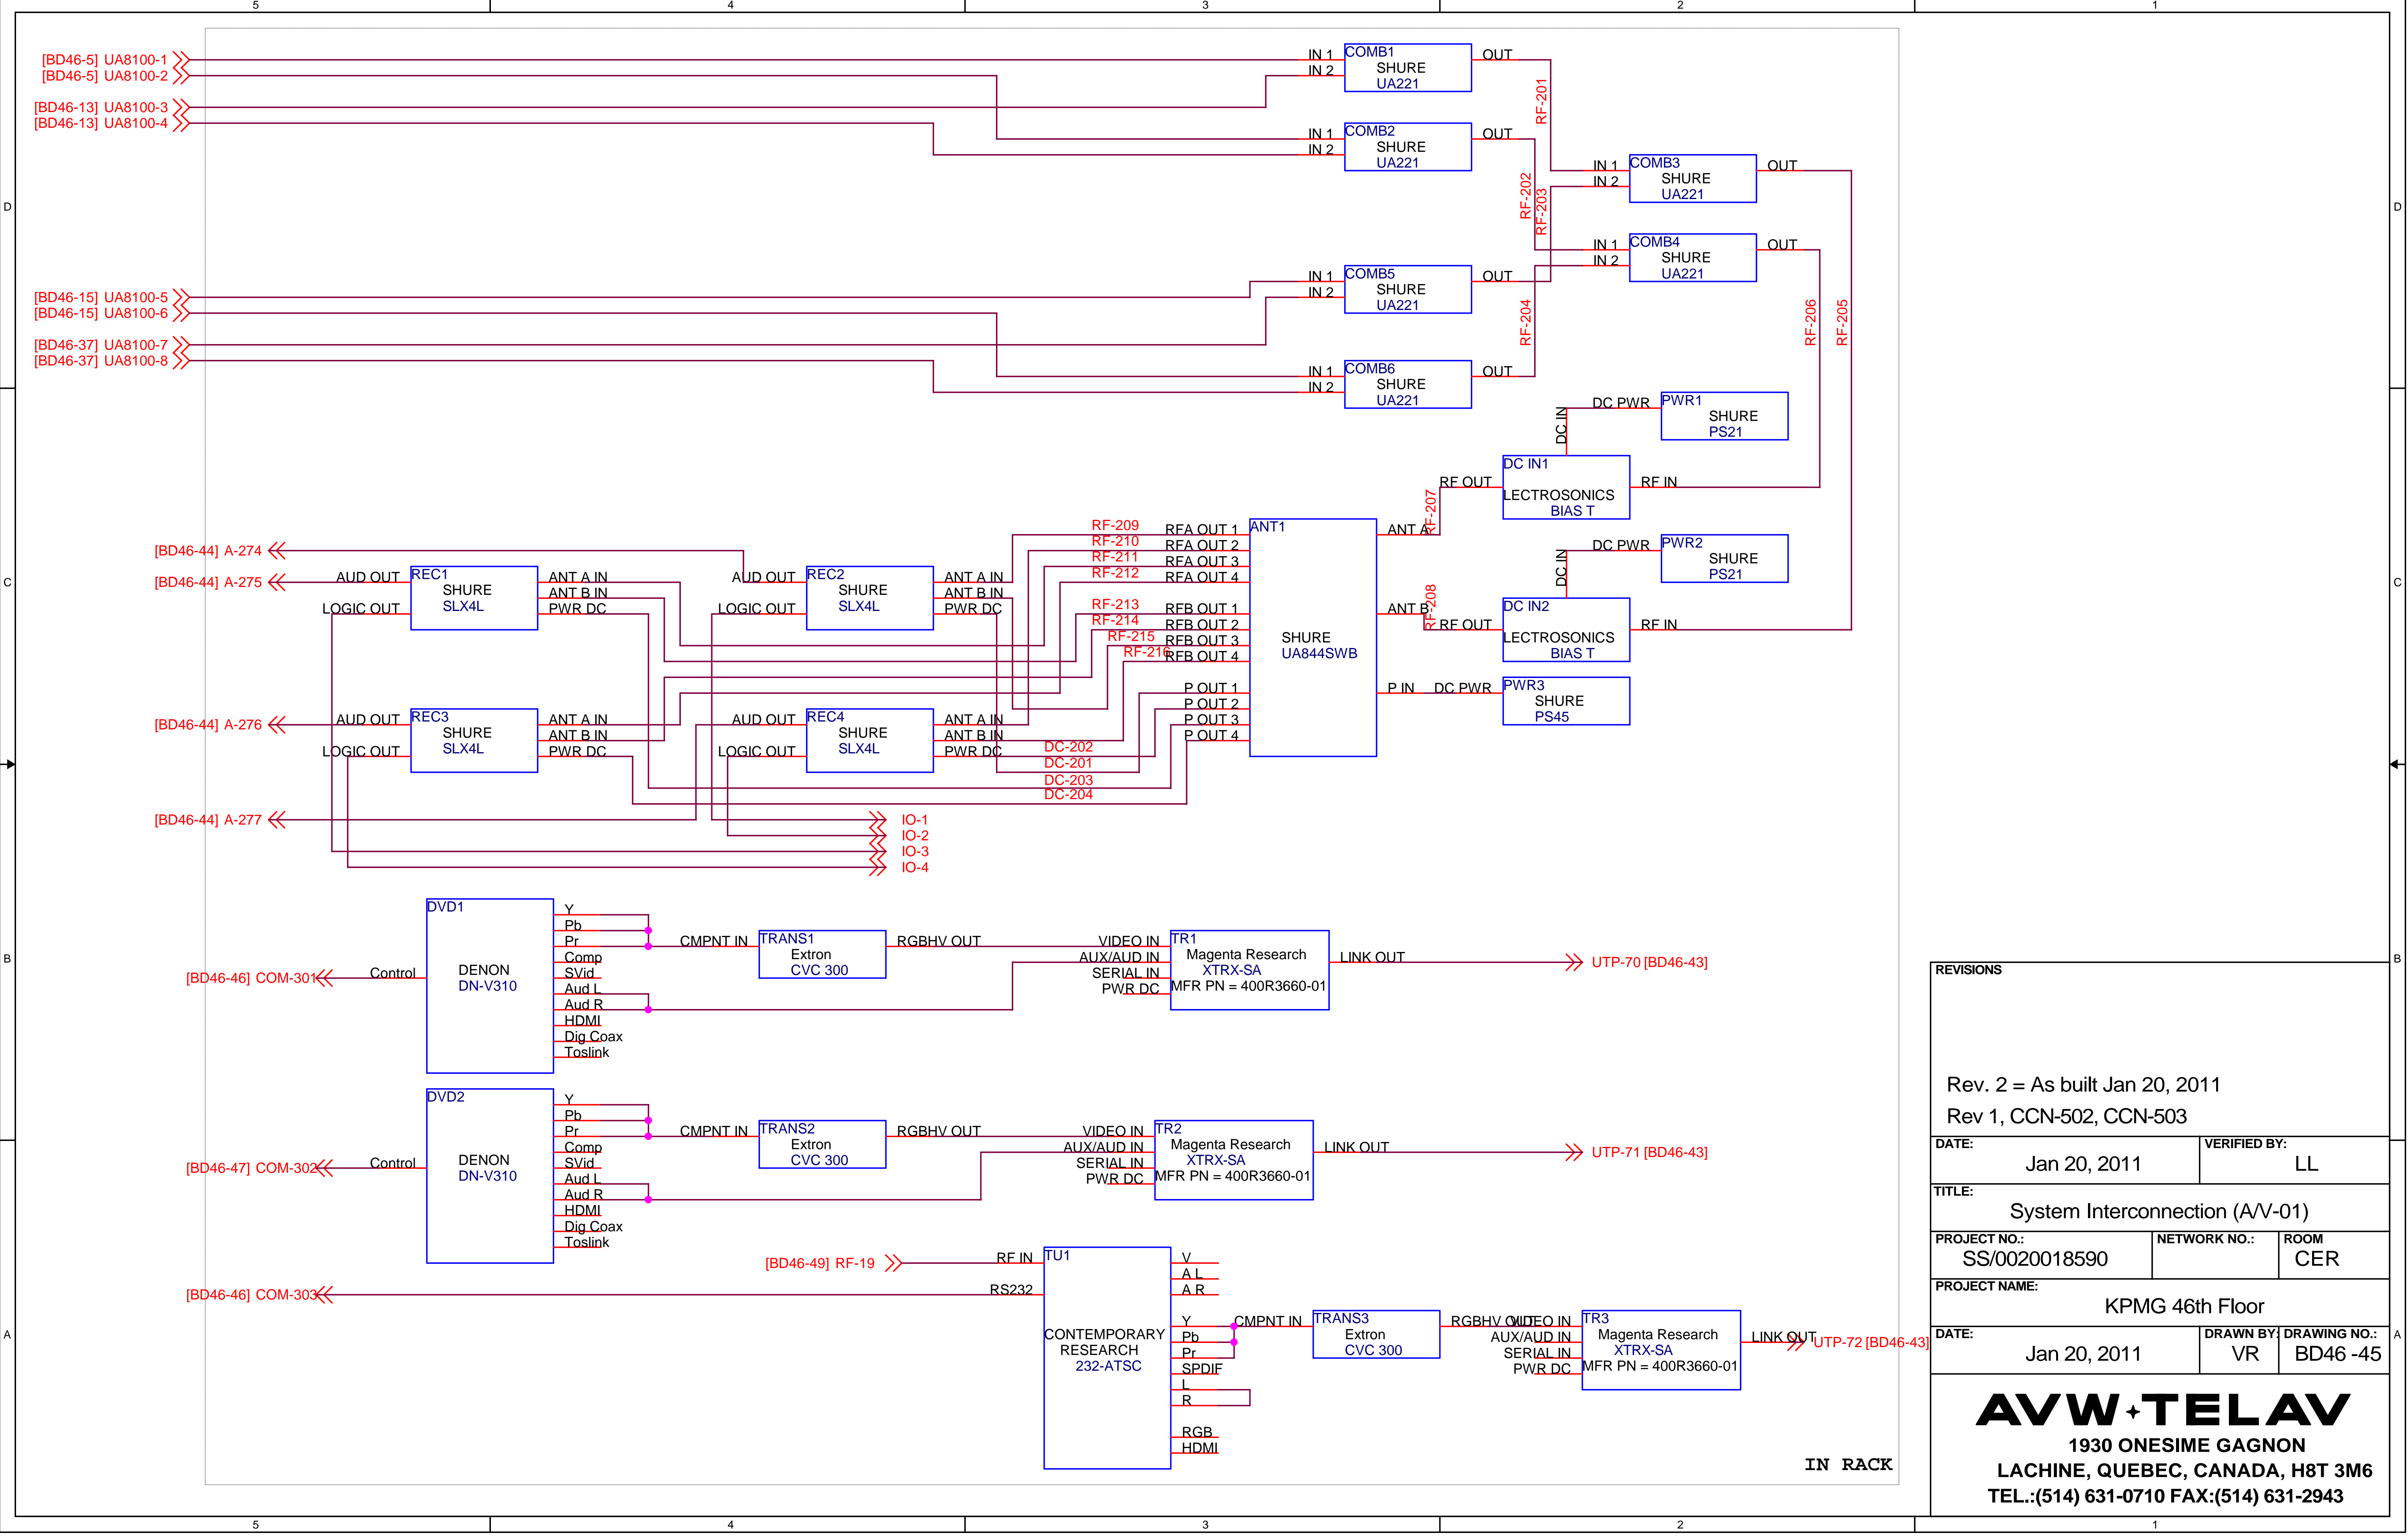

| REVISIONS | | |
|---|---------------|-----------------------------|
| Rev. 2 = As built Jan 20, 2011 Rev 1, CCN-502, CCN-503 | | |
| DATE: | Jan 20, 2011 | VERIFIED BY: LL |
| TITLE: System Interconnection (A/V-01) | | |
| PROJECT NO.: | SS/0020018590 | NETWORK NO.: ROOM CER |
| PROJECT NAME: KPMG 46th Floor | | |
| DATE: | Jan 20, 2011 | DRAWN BY: VR |
| | | DRAWING NO.: BD46 -45 |
| AVW+TELAV 1930 ONESIME GAGNON LACHINE, QUEBEC, CANADA, H8T 3M6 TEL.:(514) 631-0710 FAX:(514) 631-2943 | | |

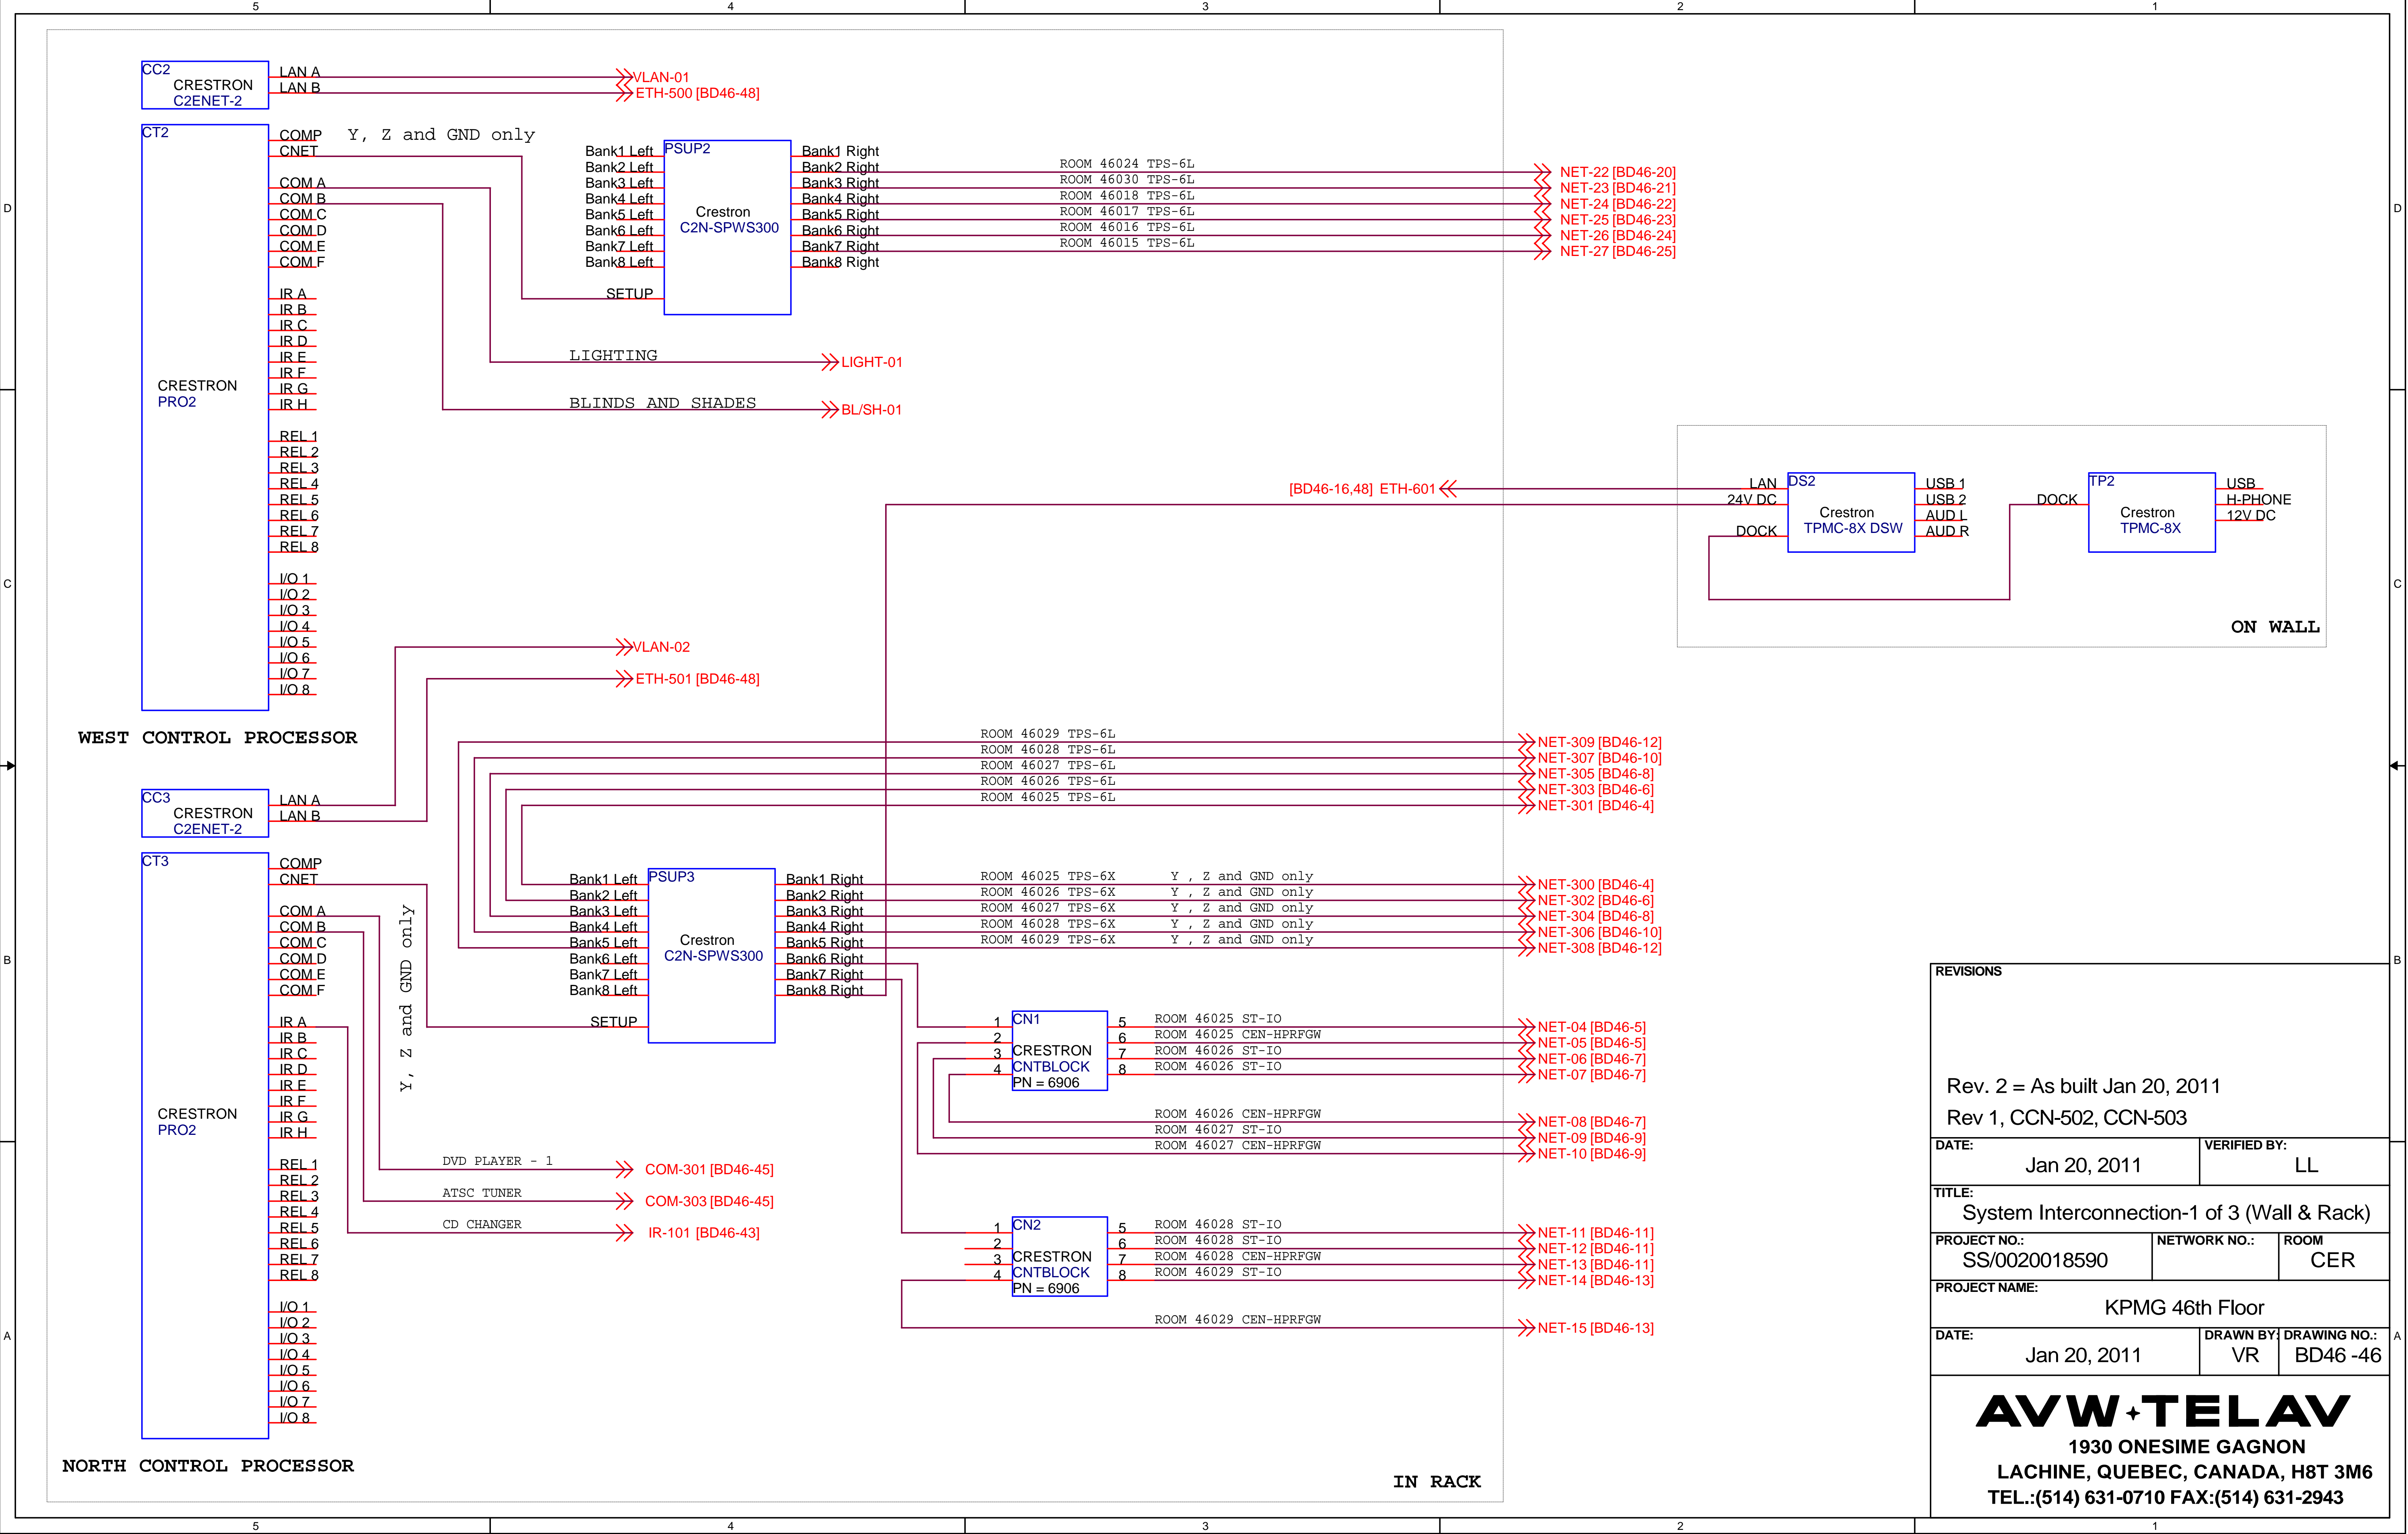

| REVISIONS | | |
|---|---------------|--------------------------|
| Rev. 2 = As built Jan 20, 2011 Rev 1, CCN-502, CCN-503 | | |
| DATE: | Jan 20, 2011 | VERIFIED BY: LL |
| TITLE: System Interconnection-1 of 3 (Wall & Rack) | | |
| PROJECT NO.: | SS/0020018590 | NETWORK NO.: |
| | | ROOM CER |
| PROJECT NAME: KPMG 46th Floor | | |
| DATE: | Jan 20, 2011 | DRAWN BY: VR |
| | | DRAWING NO.: BD46 -46 |
| AVW+TELAV 1930 ONESIME GAGNON LACHINE, QUEBEC, CANADA, H8T 3M6 TEL.:(514) 631-0710 FAX:(514) 631-2943 | | |

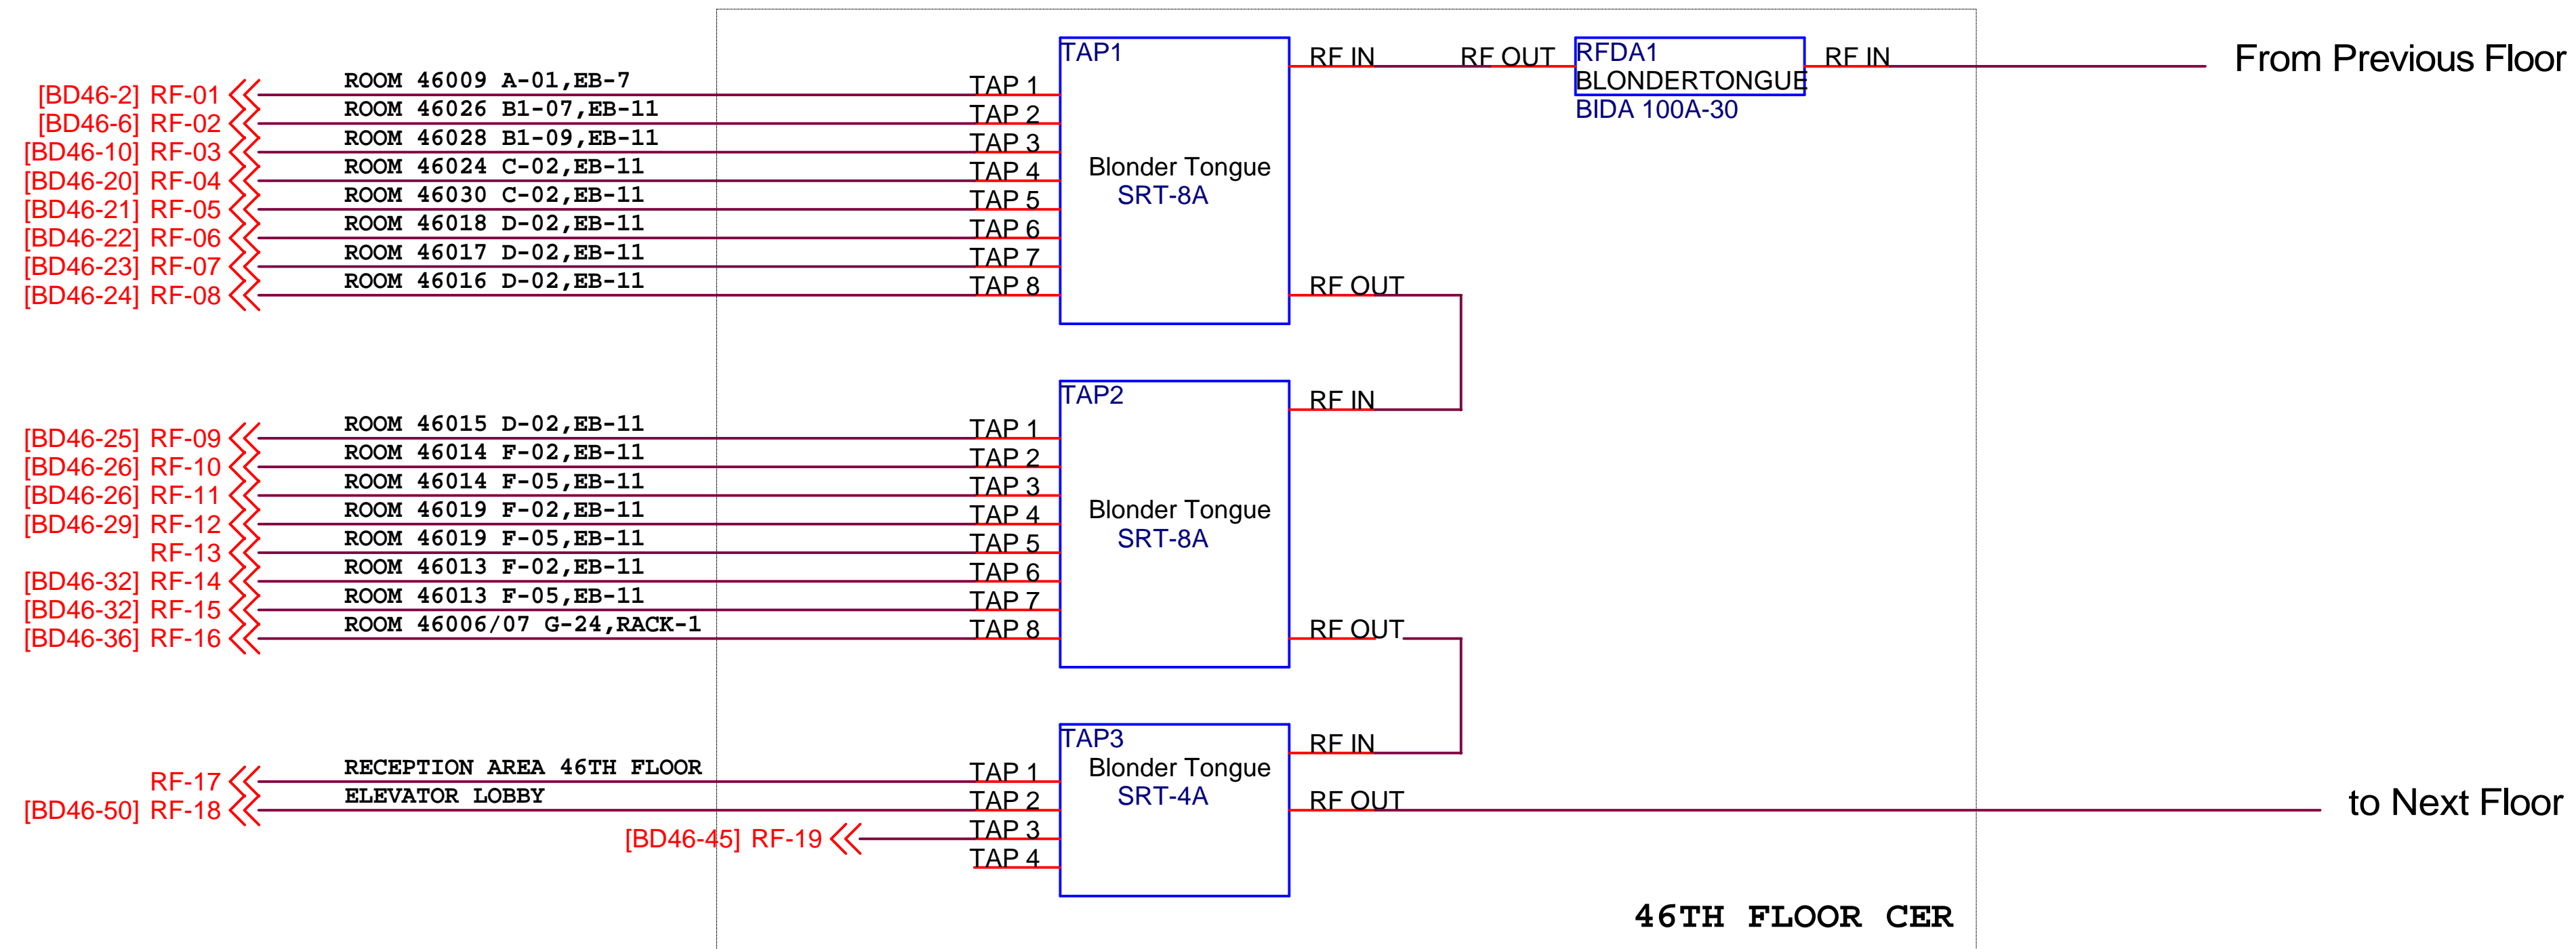

| | | |
|---|--------------------|--------------------------|
| REVISIONS | | |
| Rev. 2 = As built Jan 20, 2011 Rev 1, CCN-502, CCN-503 | | |
| DATE: Jan 20, 2011 | VERIFIED BY: LL | |
| TITLE: RF Distribution | | |
| PROJECT NO.: SS/0020018590 | NETWORK NO.: | ROOM CER |
| PROJECT NAME: KPMG 46th Floor | | |
| DATE: Jan 20, 2011 | DRAWN BY: VR | DRAWING NO.: BD46 -49 |
| AVW+TELAV 1930 ONESIME GAGNON LACHINE, QUEBEC, CANADA, H8T 3M6 TEL.:(514) 631-0710 FAX:(514) 631-2943 | | |

