


DEPTH = 19.25" (RACK DEPTH) + 1.5" FOR CABLING = 20.75"

REVISIONS		
Rev. 2 = As built Jan 2011 Rev 1, CCN-502, CCN-503		
DATE:	Jan 20, 2011	VERIFIED BY: LL
TITLE: RACK LAYOUT		
PROJECT NO.:	SS/0020018590	NETWORK NO.: TYPE F
PROJECT NAME: KPMG 46th Floor		
DATE:	Jan 20, 2011	DRAWN BY: VR
DRAWING NO.: RL46-02		
<b>AVW+TELAV</b> 1930 ONESIME GAGNON LACHINE, QUEBEC, CANADA, H8T 3M6 TEL.:(514) 631-0710 FAX:(514) 631-2943		





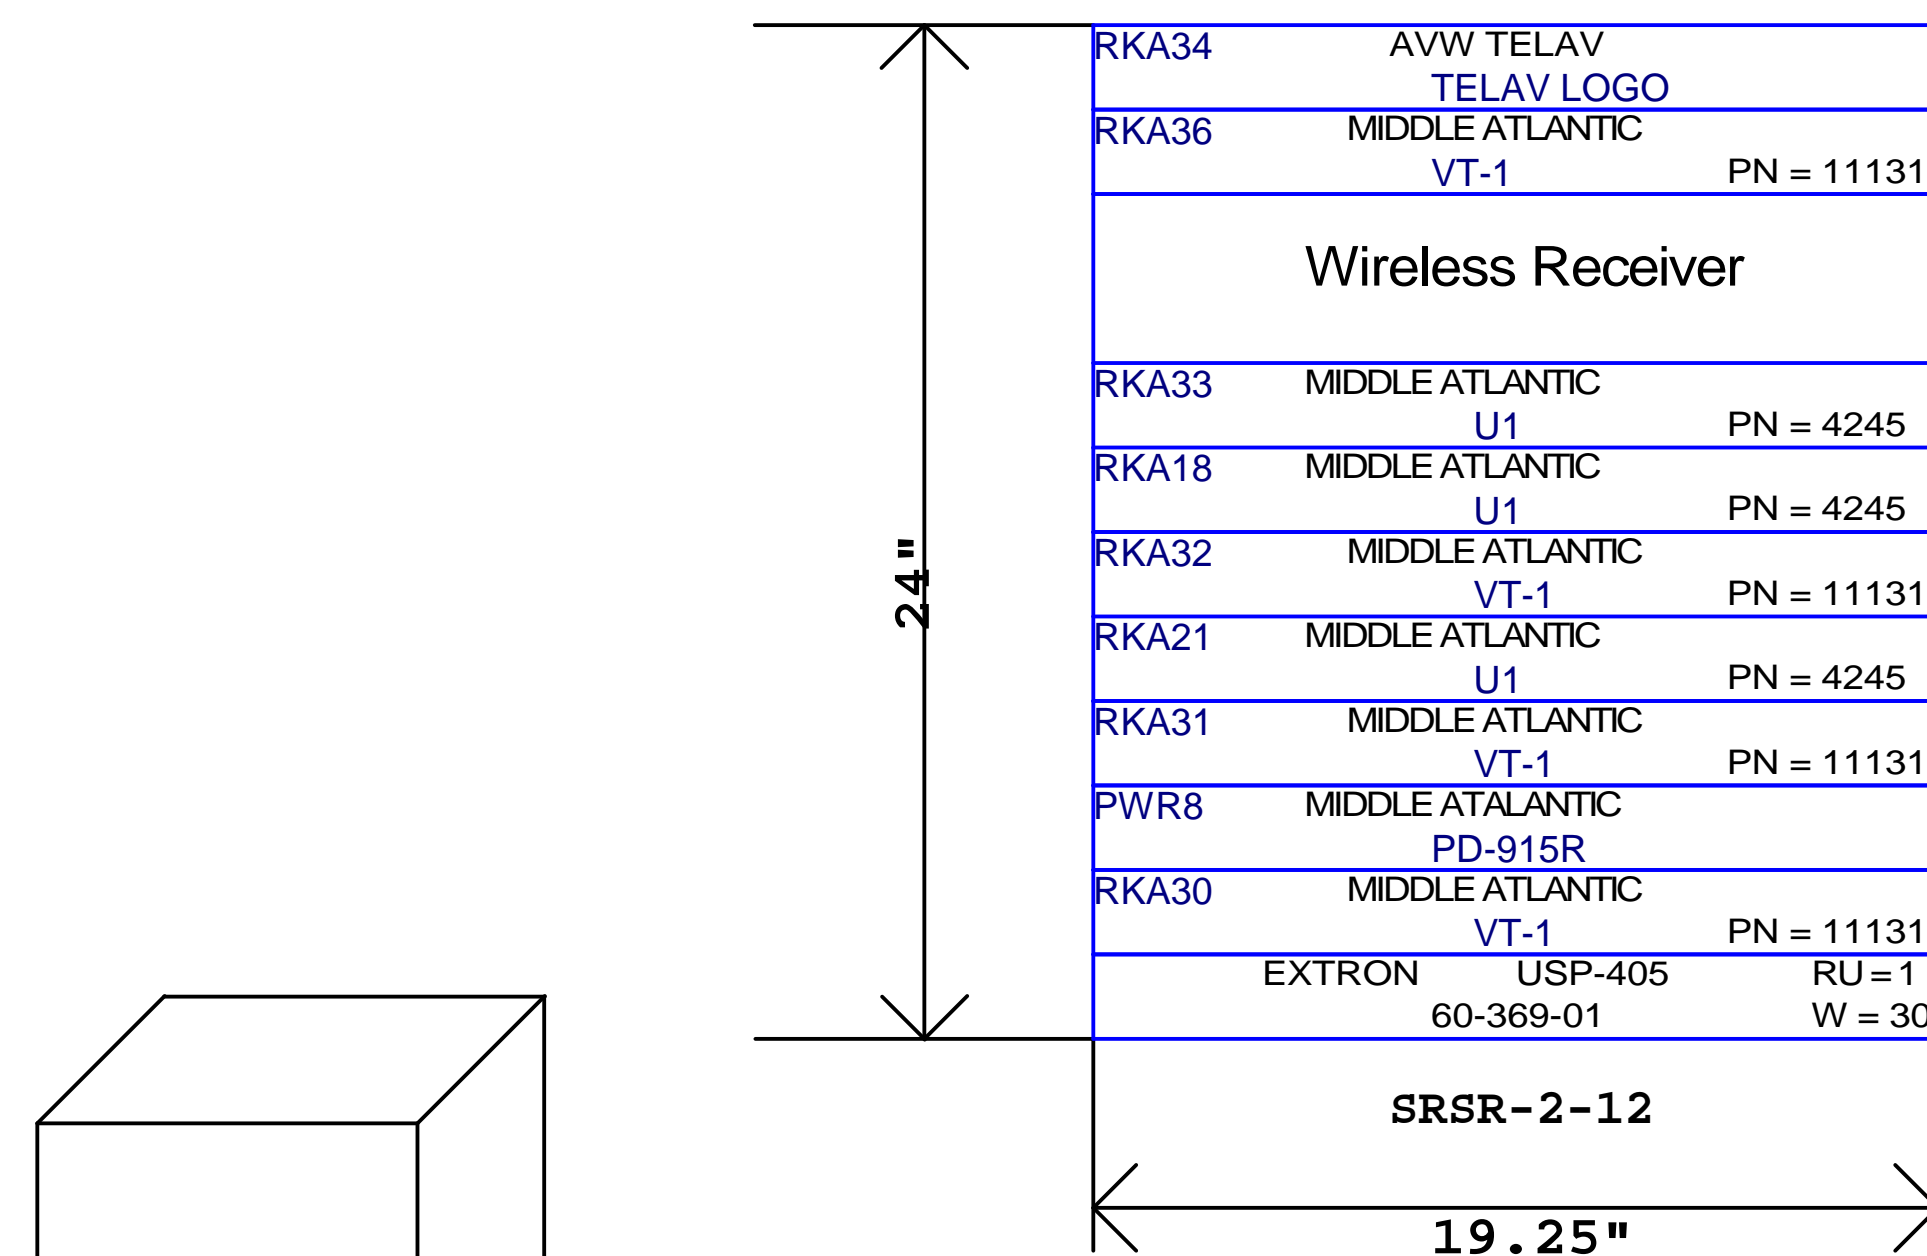


FOR RDL FP-BUC2


FOR POWER SUPPLIES

FOR XTRX-SA, AKDP600-SA, PWE-4803,  
CEN-WAP-1B-1G

DEPTH = 19.25" (RACK DEPTH) + 1.5" FOR CABLING = 20.75"

<b>REVISIONS</b>  Rev. 2 = As built Jan 2011 Rev 1, CCN-502, CCN-503		
<b>DATE:</b> Jan 20, 2011		<b>VERIFIED BY:</b> LL
<b>TITLE:</b> RACK LAYOUT		
<b>PROJECT NO.:</b> SS/0020018590	<b>NETWORK NO.:</b> TYPE B1,B2 46	<b>ROOM</b> 025,29,12,10
<b>PROJECT NAME:</b> KPMG 46th Floor		
<b>DATE:</b> Jan 20, 2011		<b>DRAWN BY:</b> VR
		<b>DRAWING NO.:</b> RL46-06
<div style="text-align: center;">  <p> <b>1930 ONESIME GAGNON</b>  <b>LACHINE, QUEBEC, CANADA, H8T 3M6</b>  <b>TEL.:(514) 631-0710 FAX:(514) 631-2943</b> </p> </div>		



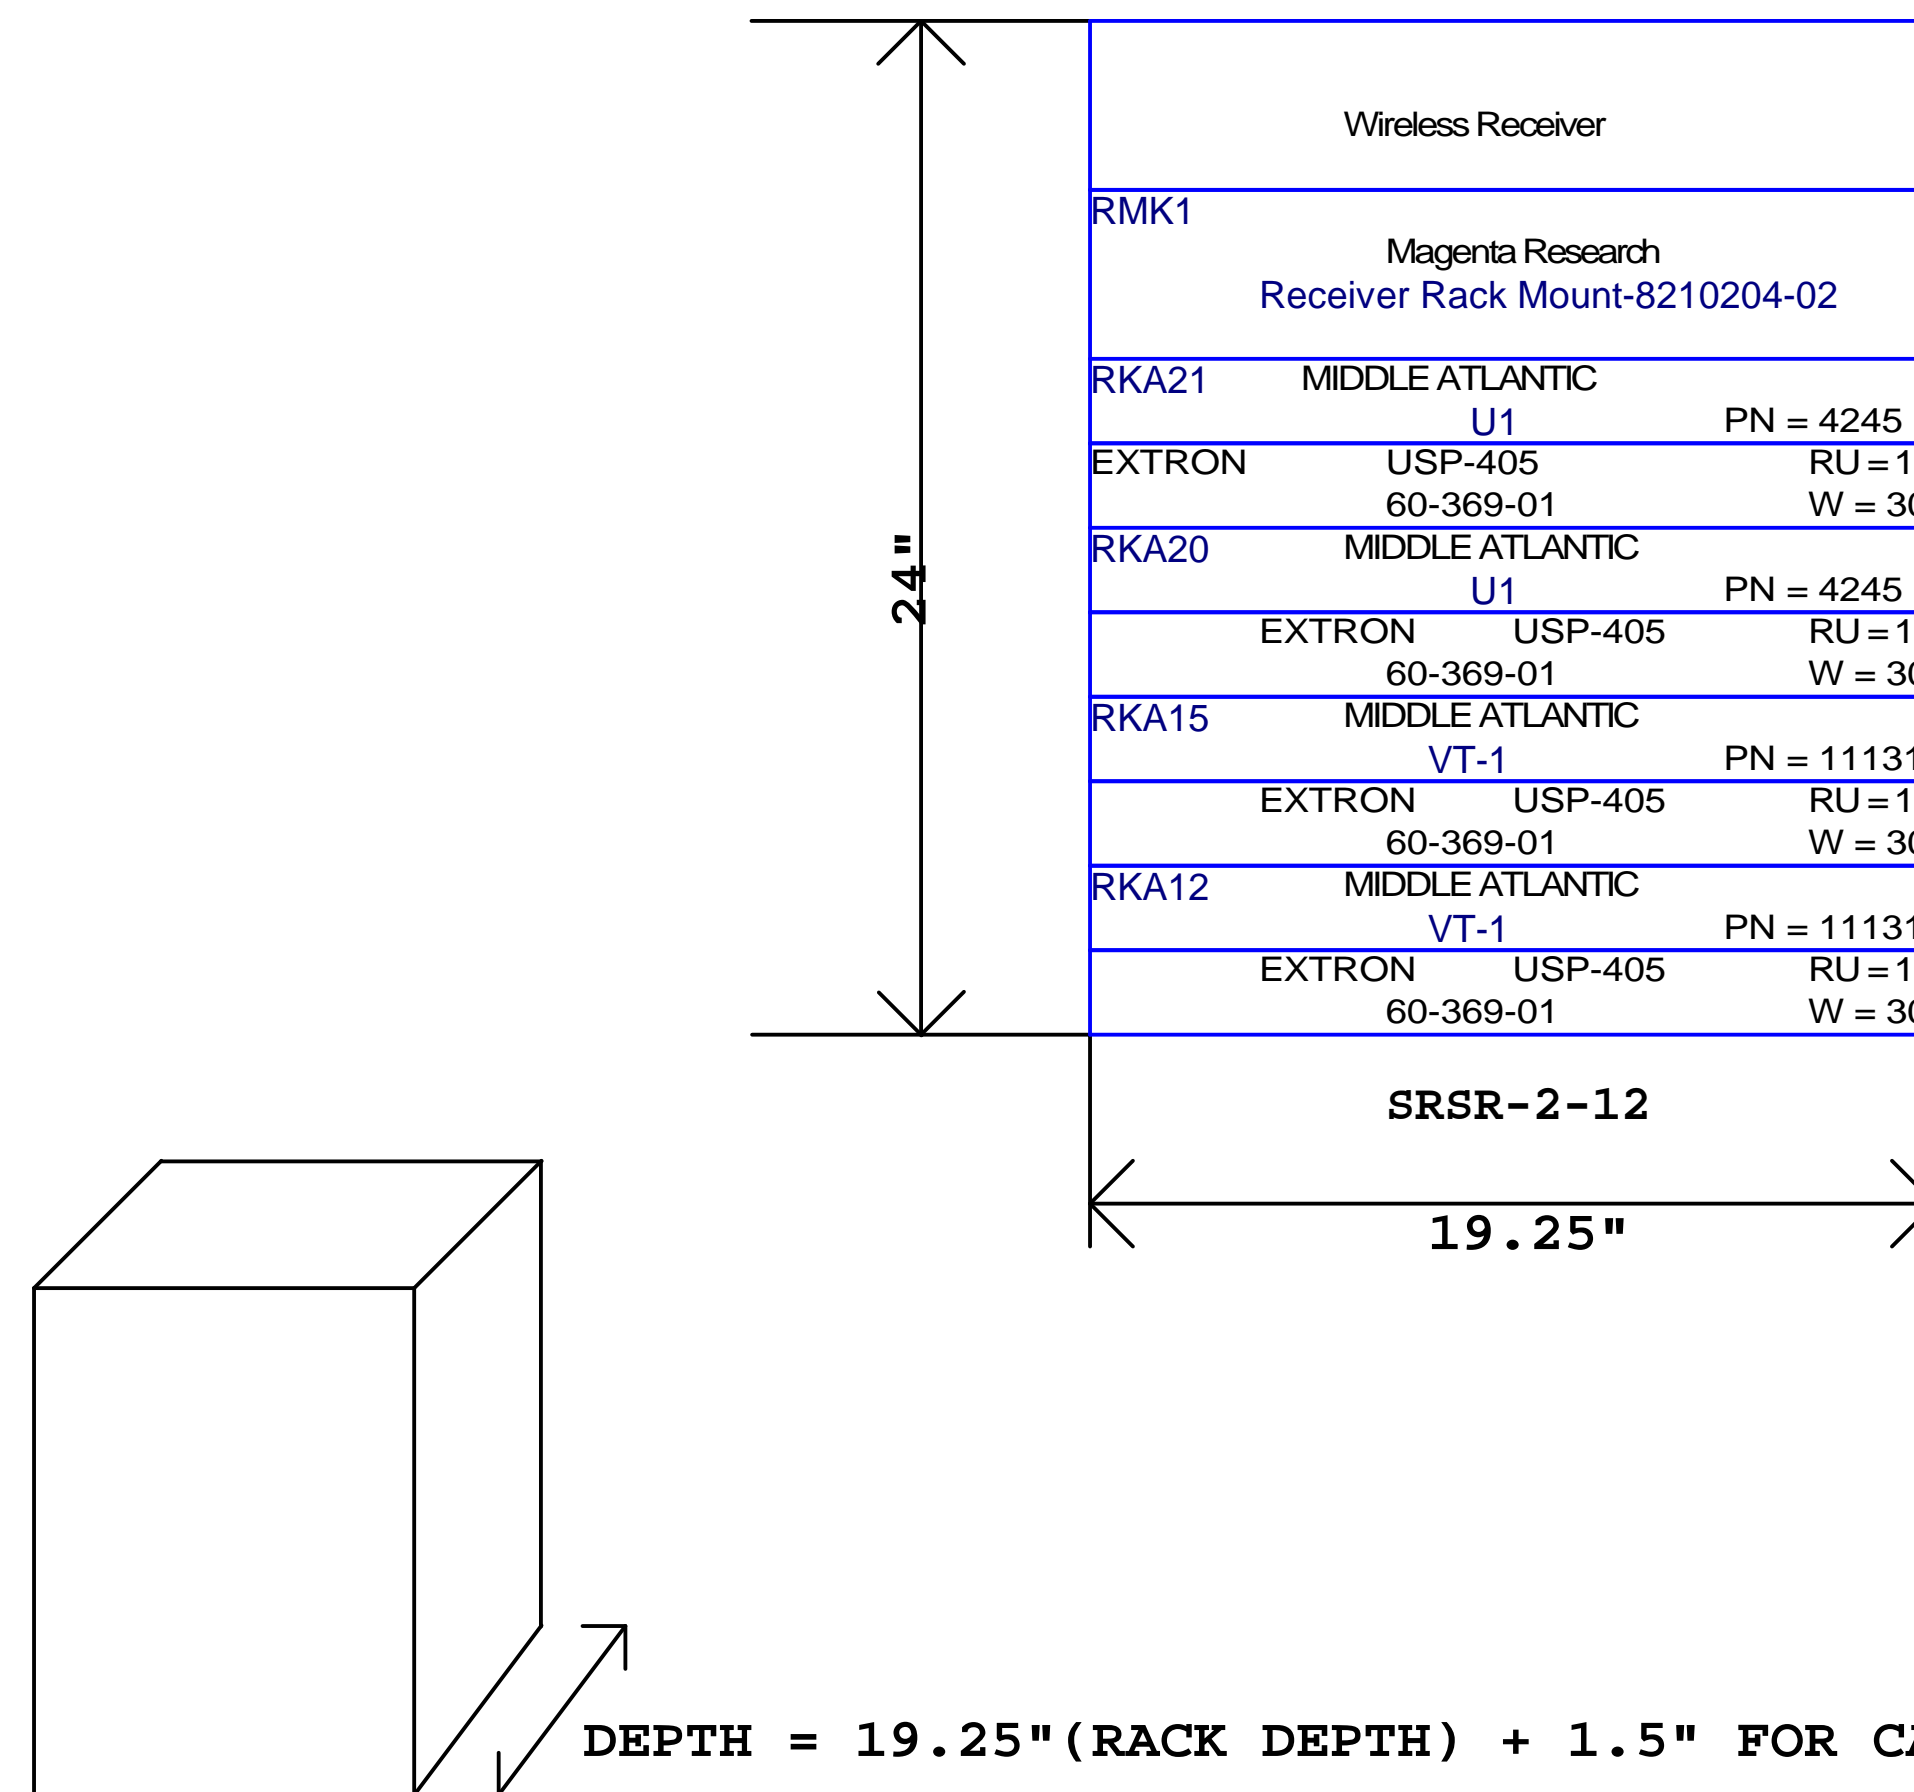


FOR 4 AKDP600-SA RECEIVERS

FOR 2 moxa n-port 5450 receivers,  
PWE-4803, CEN-WAP-ABG-1G

FOR POWER SUPPLIES

<b>REVISIONS</b>  Rev. 2 = As built Jan 2011 Rev 1, CCN-502, CCN-503		
<b>DATE:</b> Jan 20, 2011		<b>VERIFIED BY:</b> LL
<b>TITLE:</b> RACK LAYOUT		
<b>PROJECT NO.:</b> SS/0020018590	<b>NETWORK NO.:</b> TYPE B1	<b>ROOM</b> 46026,28
<b>PROJECT NAME:</b> KPMG 46th Floor		
<b>DATE:</b> Jan 20, 2011		<b>DRAWN BY:</b> VR
		<b>DRAWING NO.:</b> RL46-07
<div style="text-align: center;">  <p> <b>1930 ONESIME GAGNON</b>  <b>LACHINE, QUEBEC, CANADA, H8T 3M6</b>  <b>TEL.:(514) 631-0710 FAX:(514) 631-2943</b> </p> </div>		











